
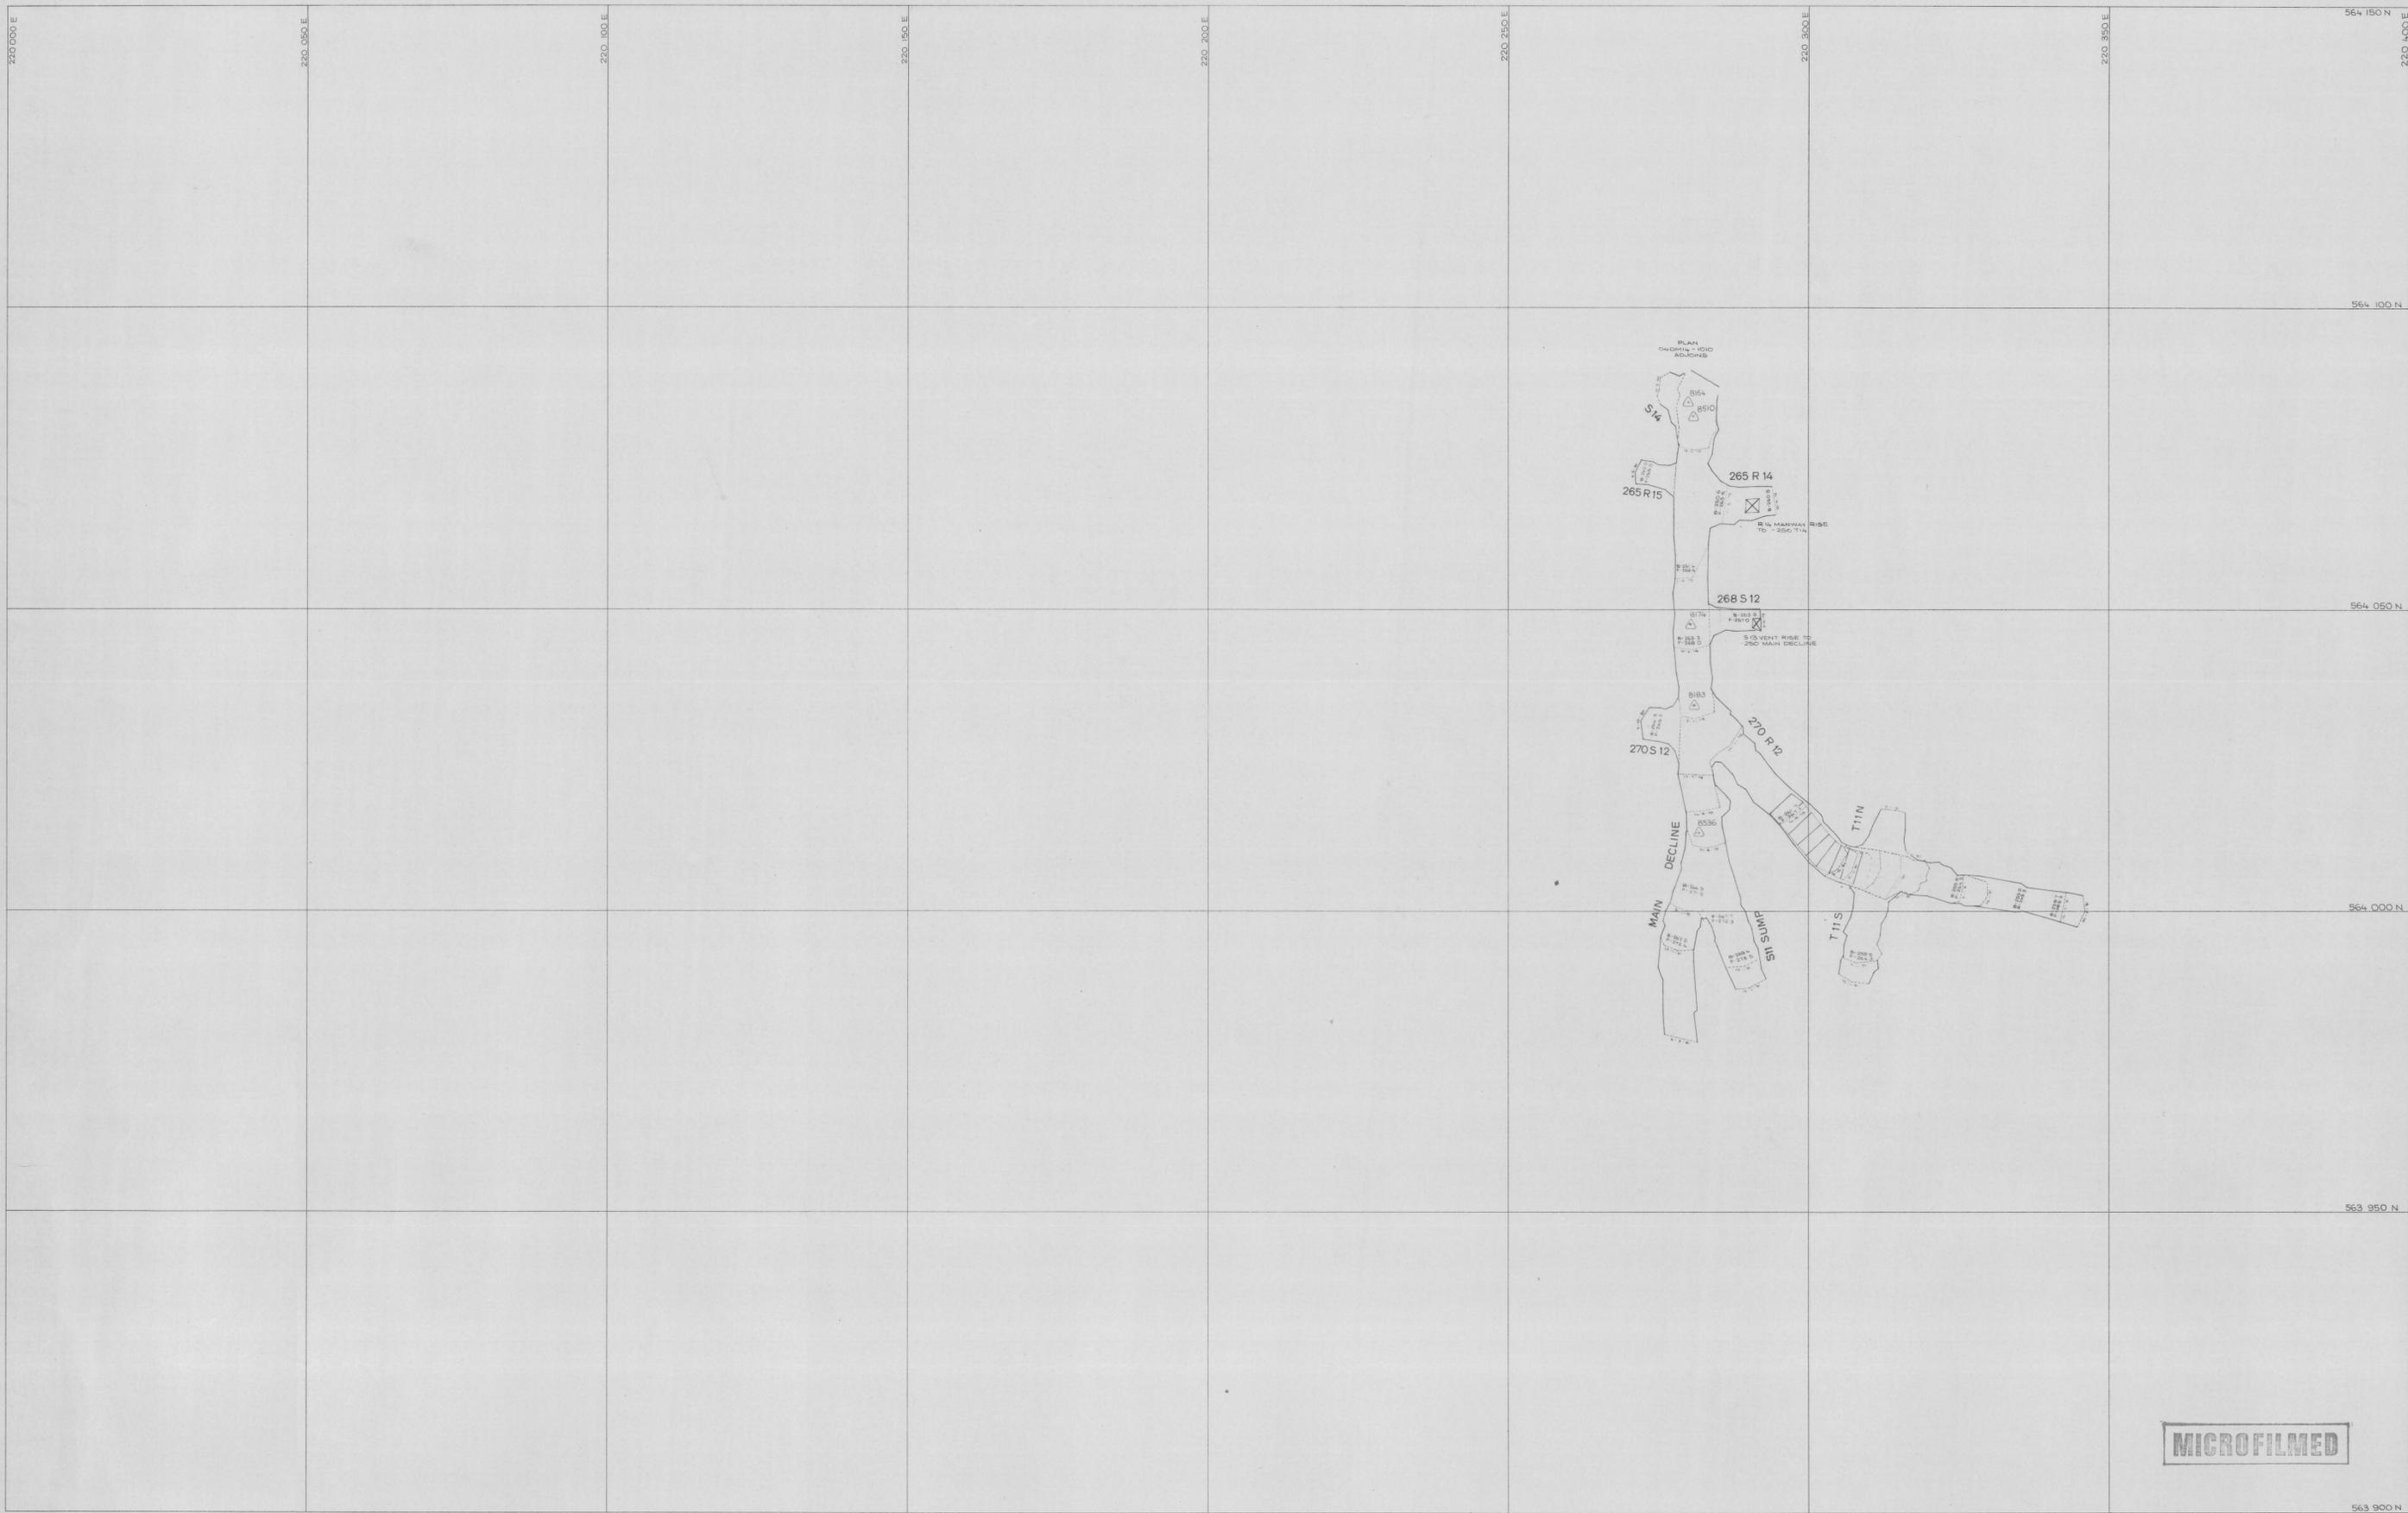


0374_519

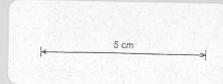

MICROFILMED

SCALE 1:500 	north	LOCATION DOLPHIN MINE	 GRASSY KING ISLAND PLAN NUMBER 04DM14 - 1011 811/3
		SUBJECT -275 m ZONE	