


0374_525

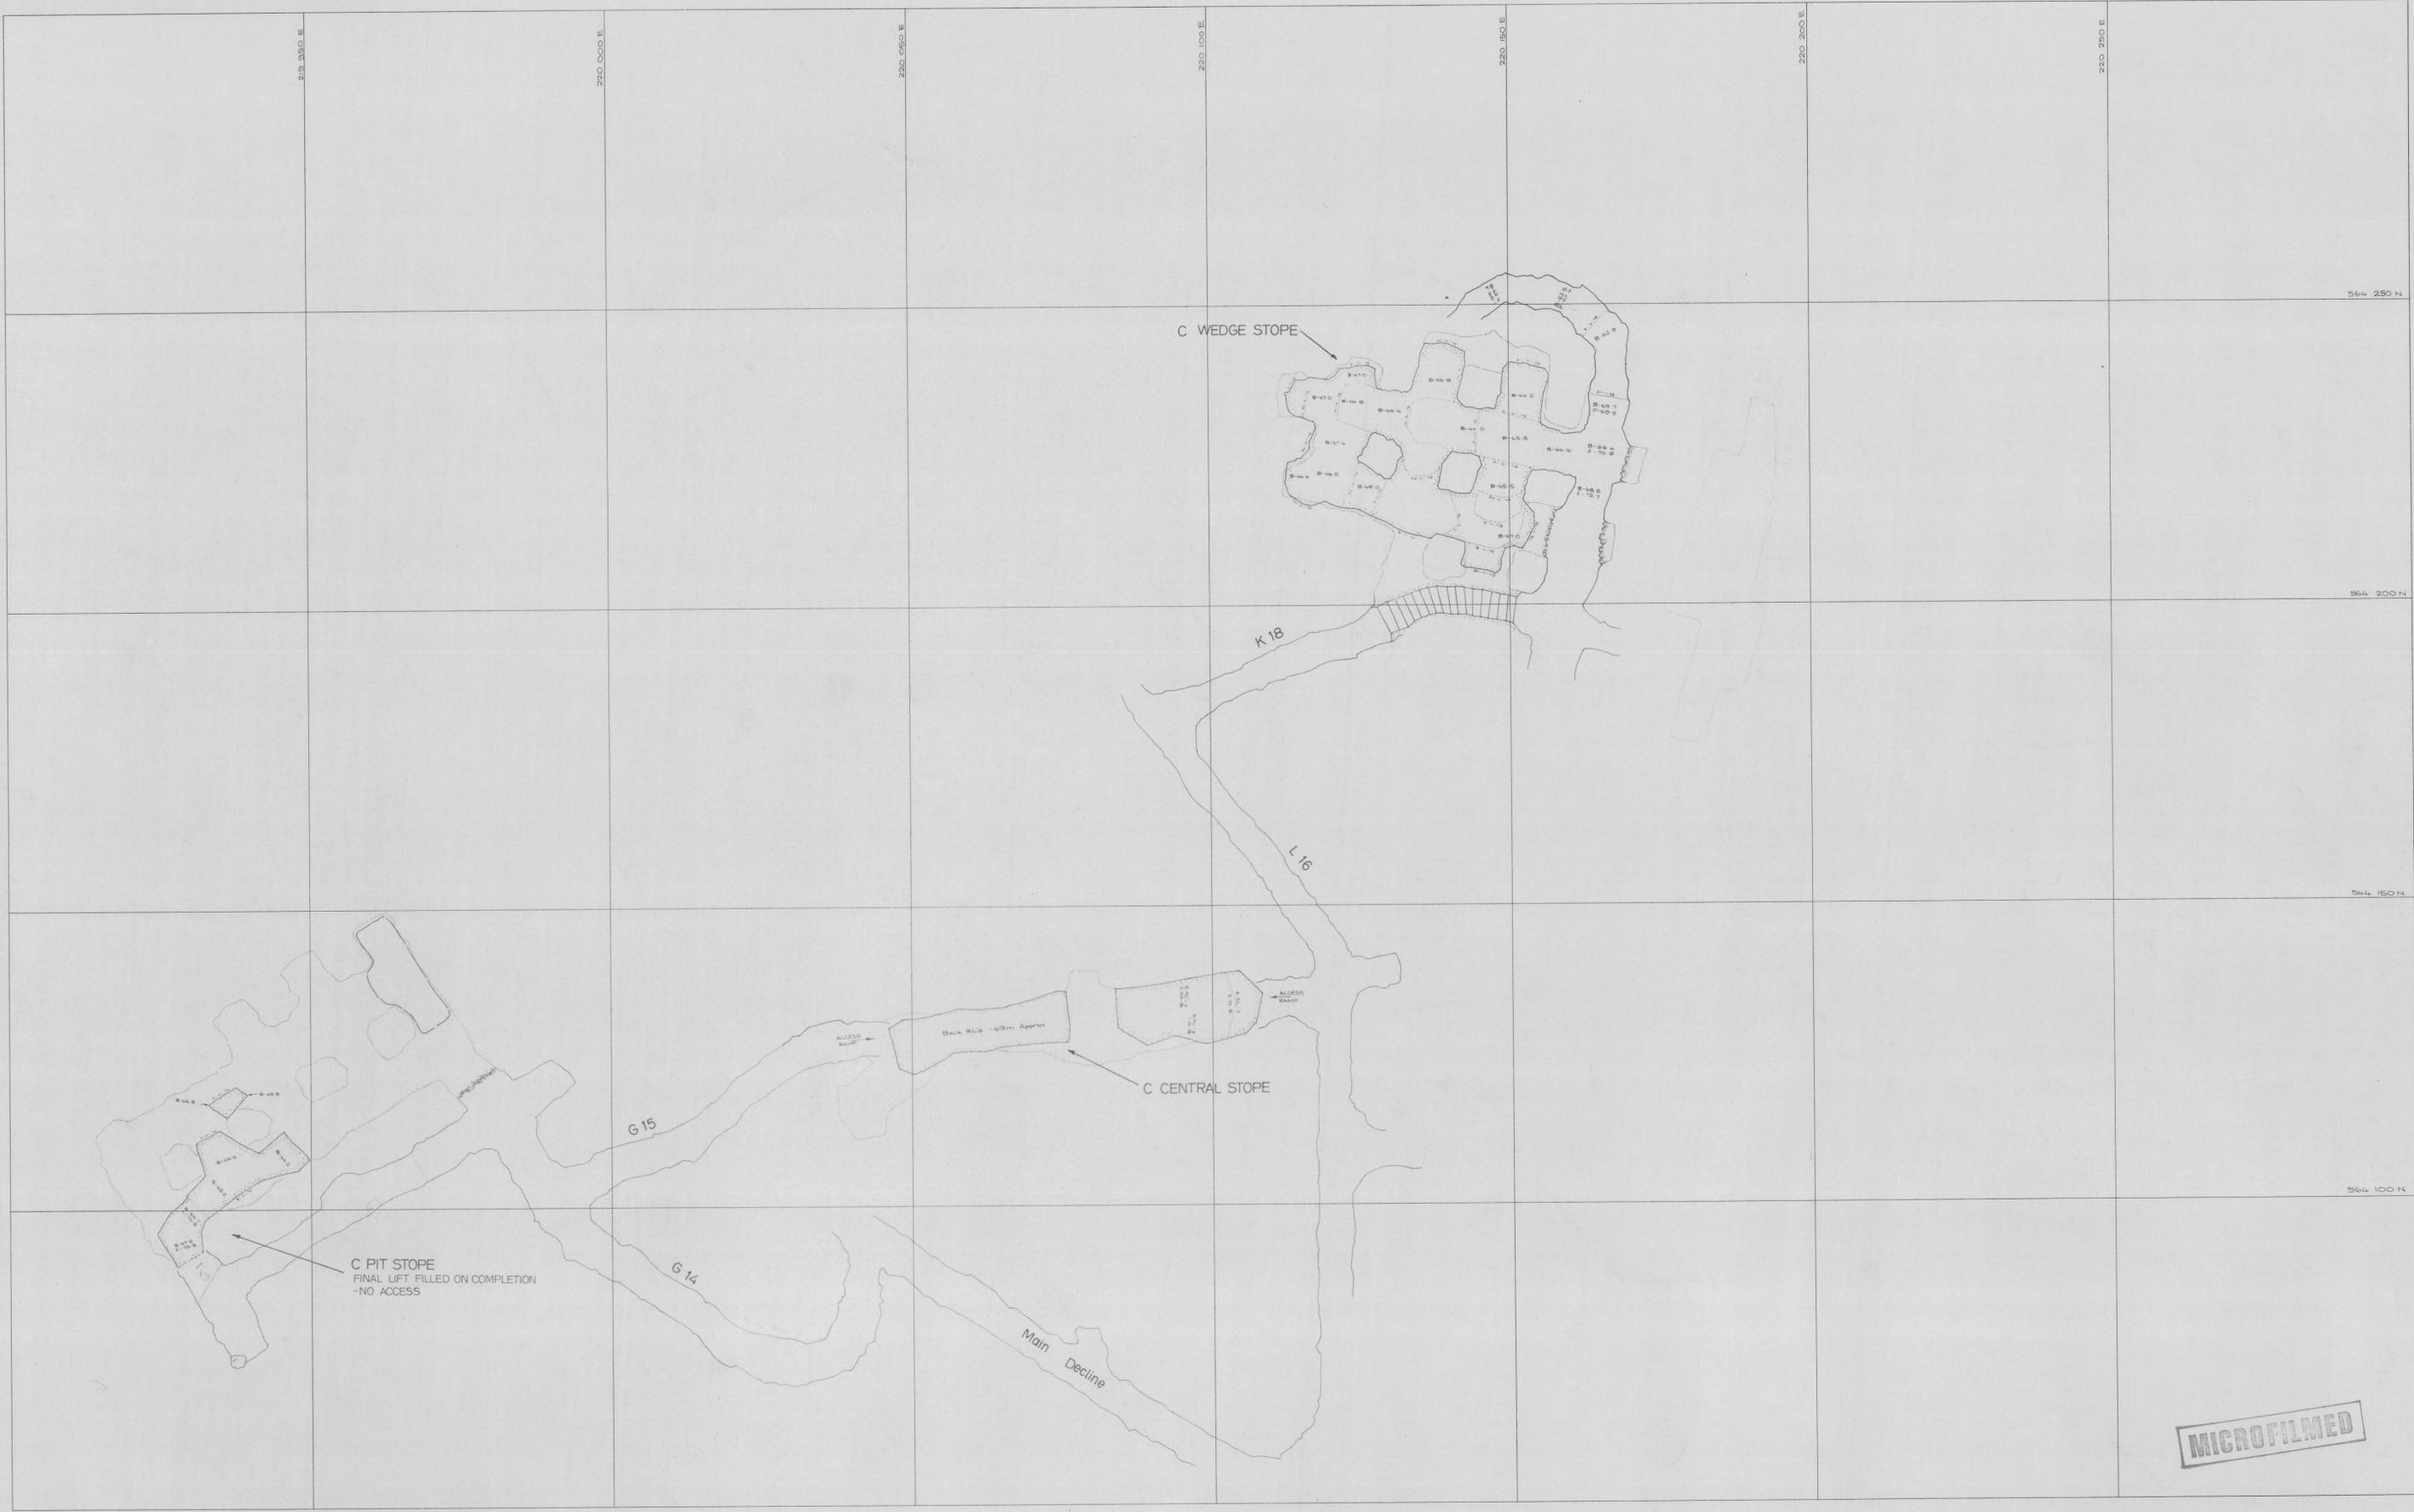

MICROFILMED

<p>SCALE 1:500</p> <p>See Plan Q4DM14-1002 for -75m ZONE DETAIL AND STOPE UNDERCUTS</p> <p>5 cm</p> <p>north</p>	<p>LOCATION DOLPHIN MINE</p> <p>SUBJECT -75 LEVEL STOPING</p> <p>WEDGE - 69.5m CONTOUR 1st LIFT</p> <p>CENTRAL - 72m CONTOUR 1st LIFT</p> <p>PIT - 68.5m CONTOUR 1st LIFT [Final]</p>	<p>KIS KING ISLAND SCHEELITE A DIVISION OF WARMAN INTERNATIONAL</p> <p>GRASSY KING ISLAND</p> <p>PLAN NUMBER 04DM15 - 1003 81119</p>
--	---	---