



0374\_528

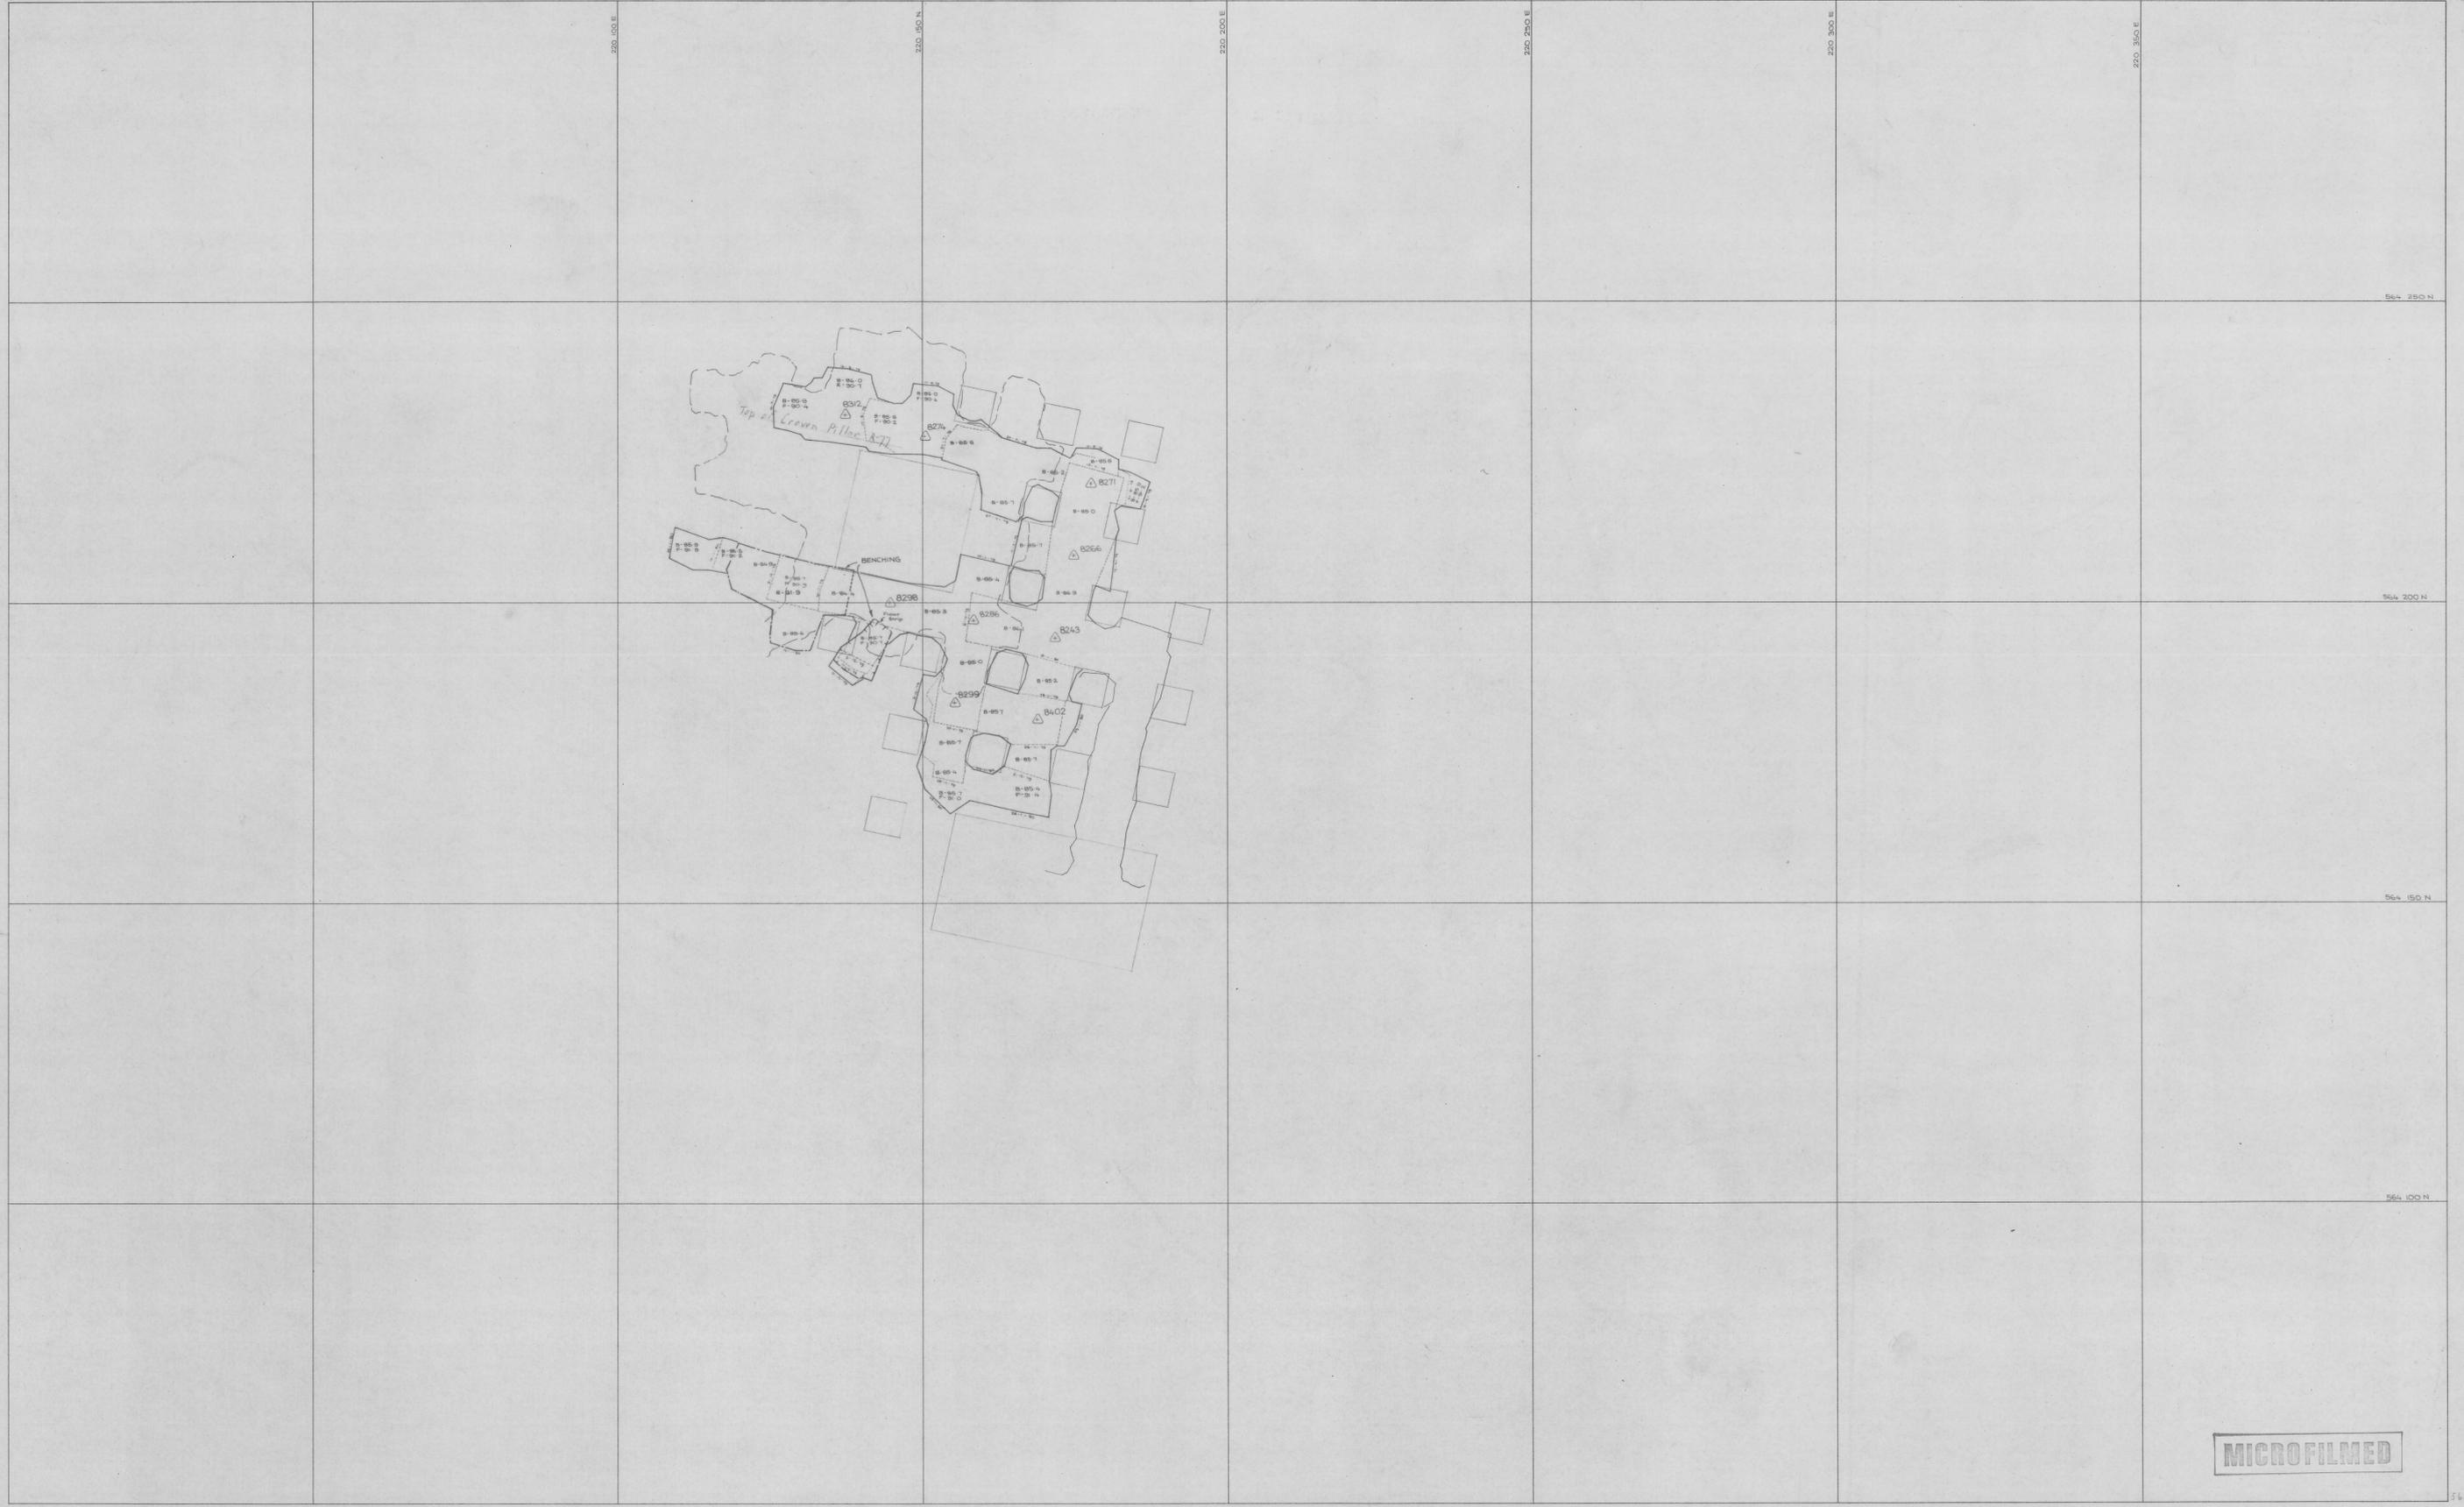

SCALE 1:500

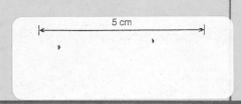

north

LOCATION  
DOLPHIN MINE

SUBJECT  
Wedge Stope  
-89 m CONTOUR

**KIS** KING ISLAND SCHEELITE  
A DIVISION OF WARMAN INTERNATIONAL

GRASSY KING ISLAND

PLAN NUMBER  
04DM15 - 1010 8/1/22