


0374_529

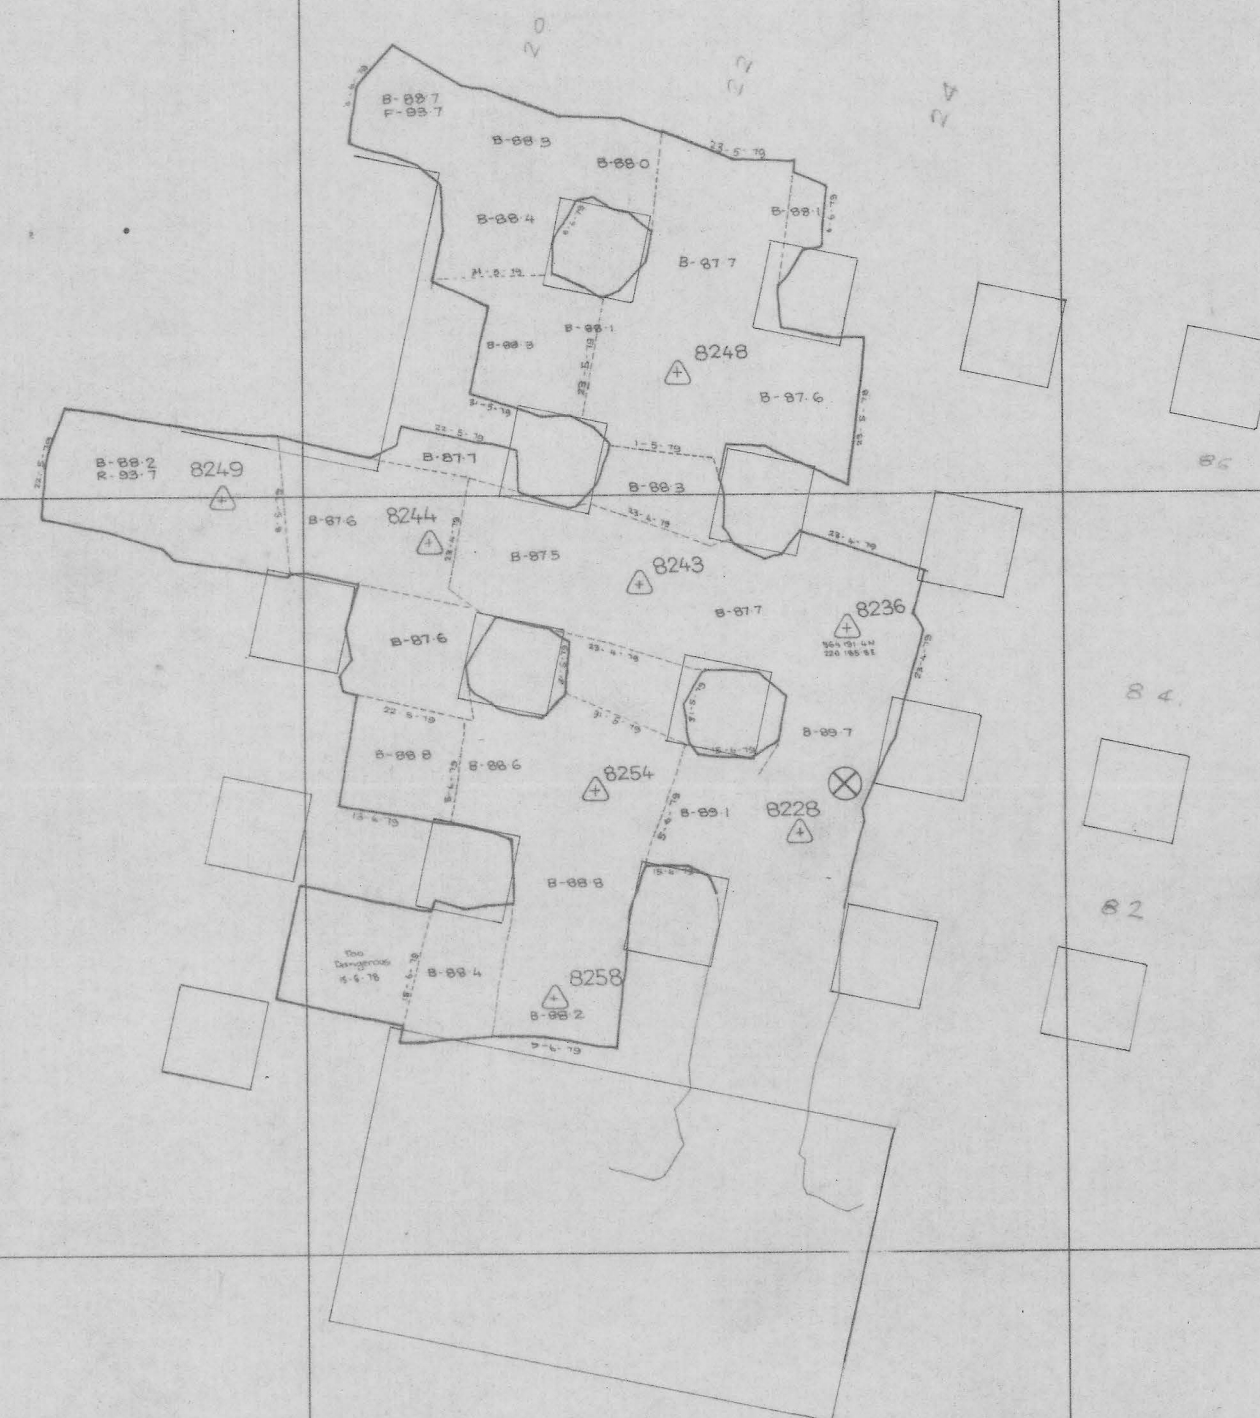

MICROFILMED

564 050 N

SCALE 1:500



north

LOCATION

DOLPHIN

 
MINE

SUBJECT

C WEDGE STOPE

- 92 m

CONTOUR



KIS KING ISLAND SCHEELITE
A DIVISION OF WARMAN INTERNATIONAL

GRASSY

KING ISLAND

PLAN NUMBER	
-------------	--

04DM115 - 1011

81123