



0374_530

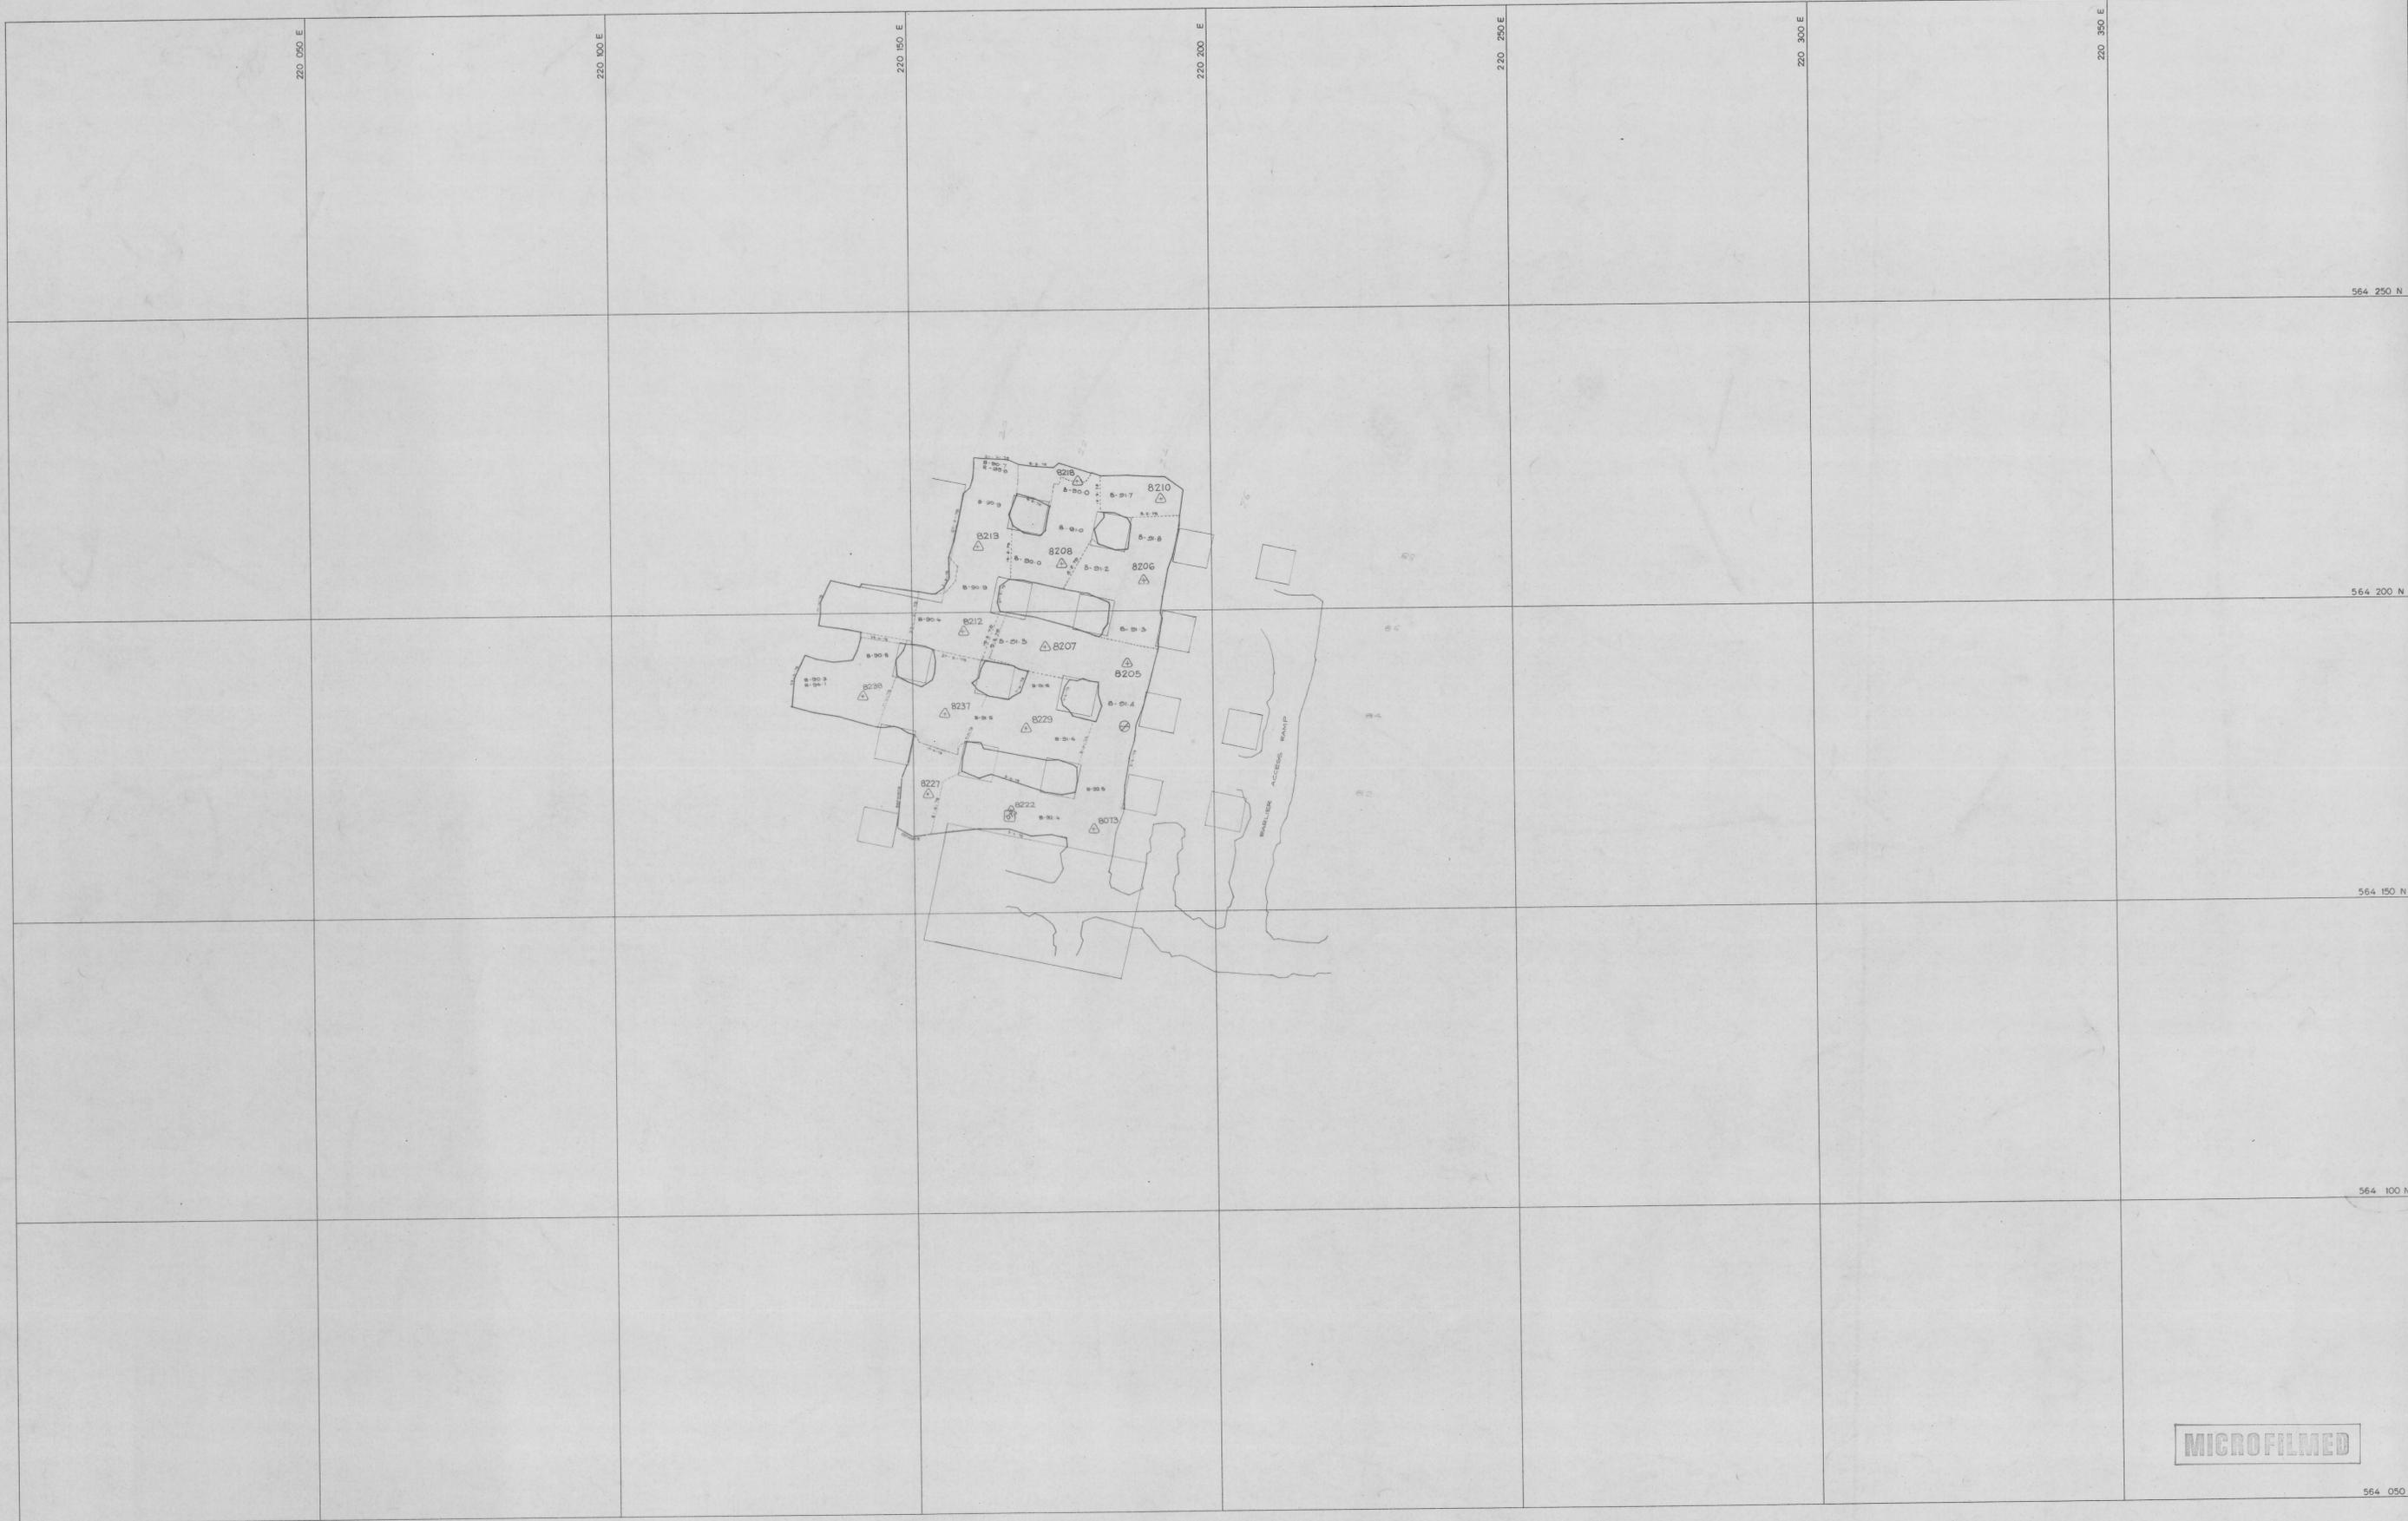

MICROFILMED

SCALE 1:500

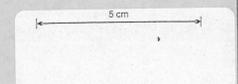

north

LOCATION DOLPHIN MINE

SUBJECT C WEDGE STOPE
- 95m CONTOUR

KIS KING ISLAND SCHEELITE
A DIVISION OF WARRAN INTERNATIONAL

GRASSY KING ISLAND

PLAN NUMBER 04DM115 - 1012 8/124