


0374_531



MICROFILMED

SCALE 1:500

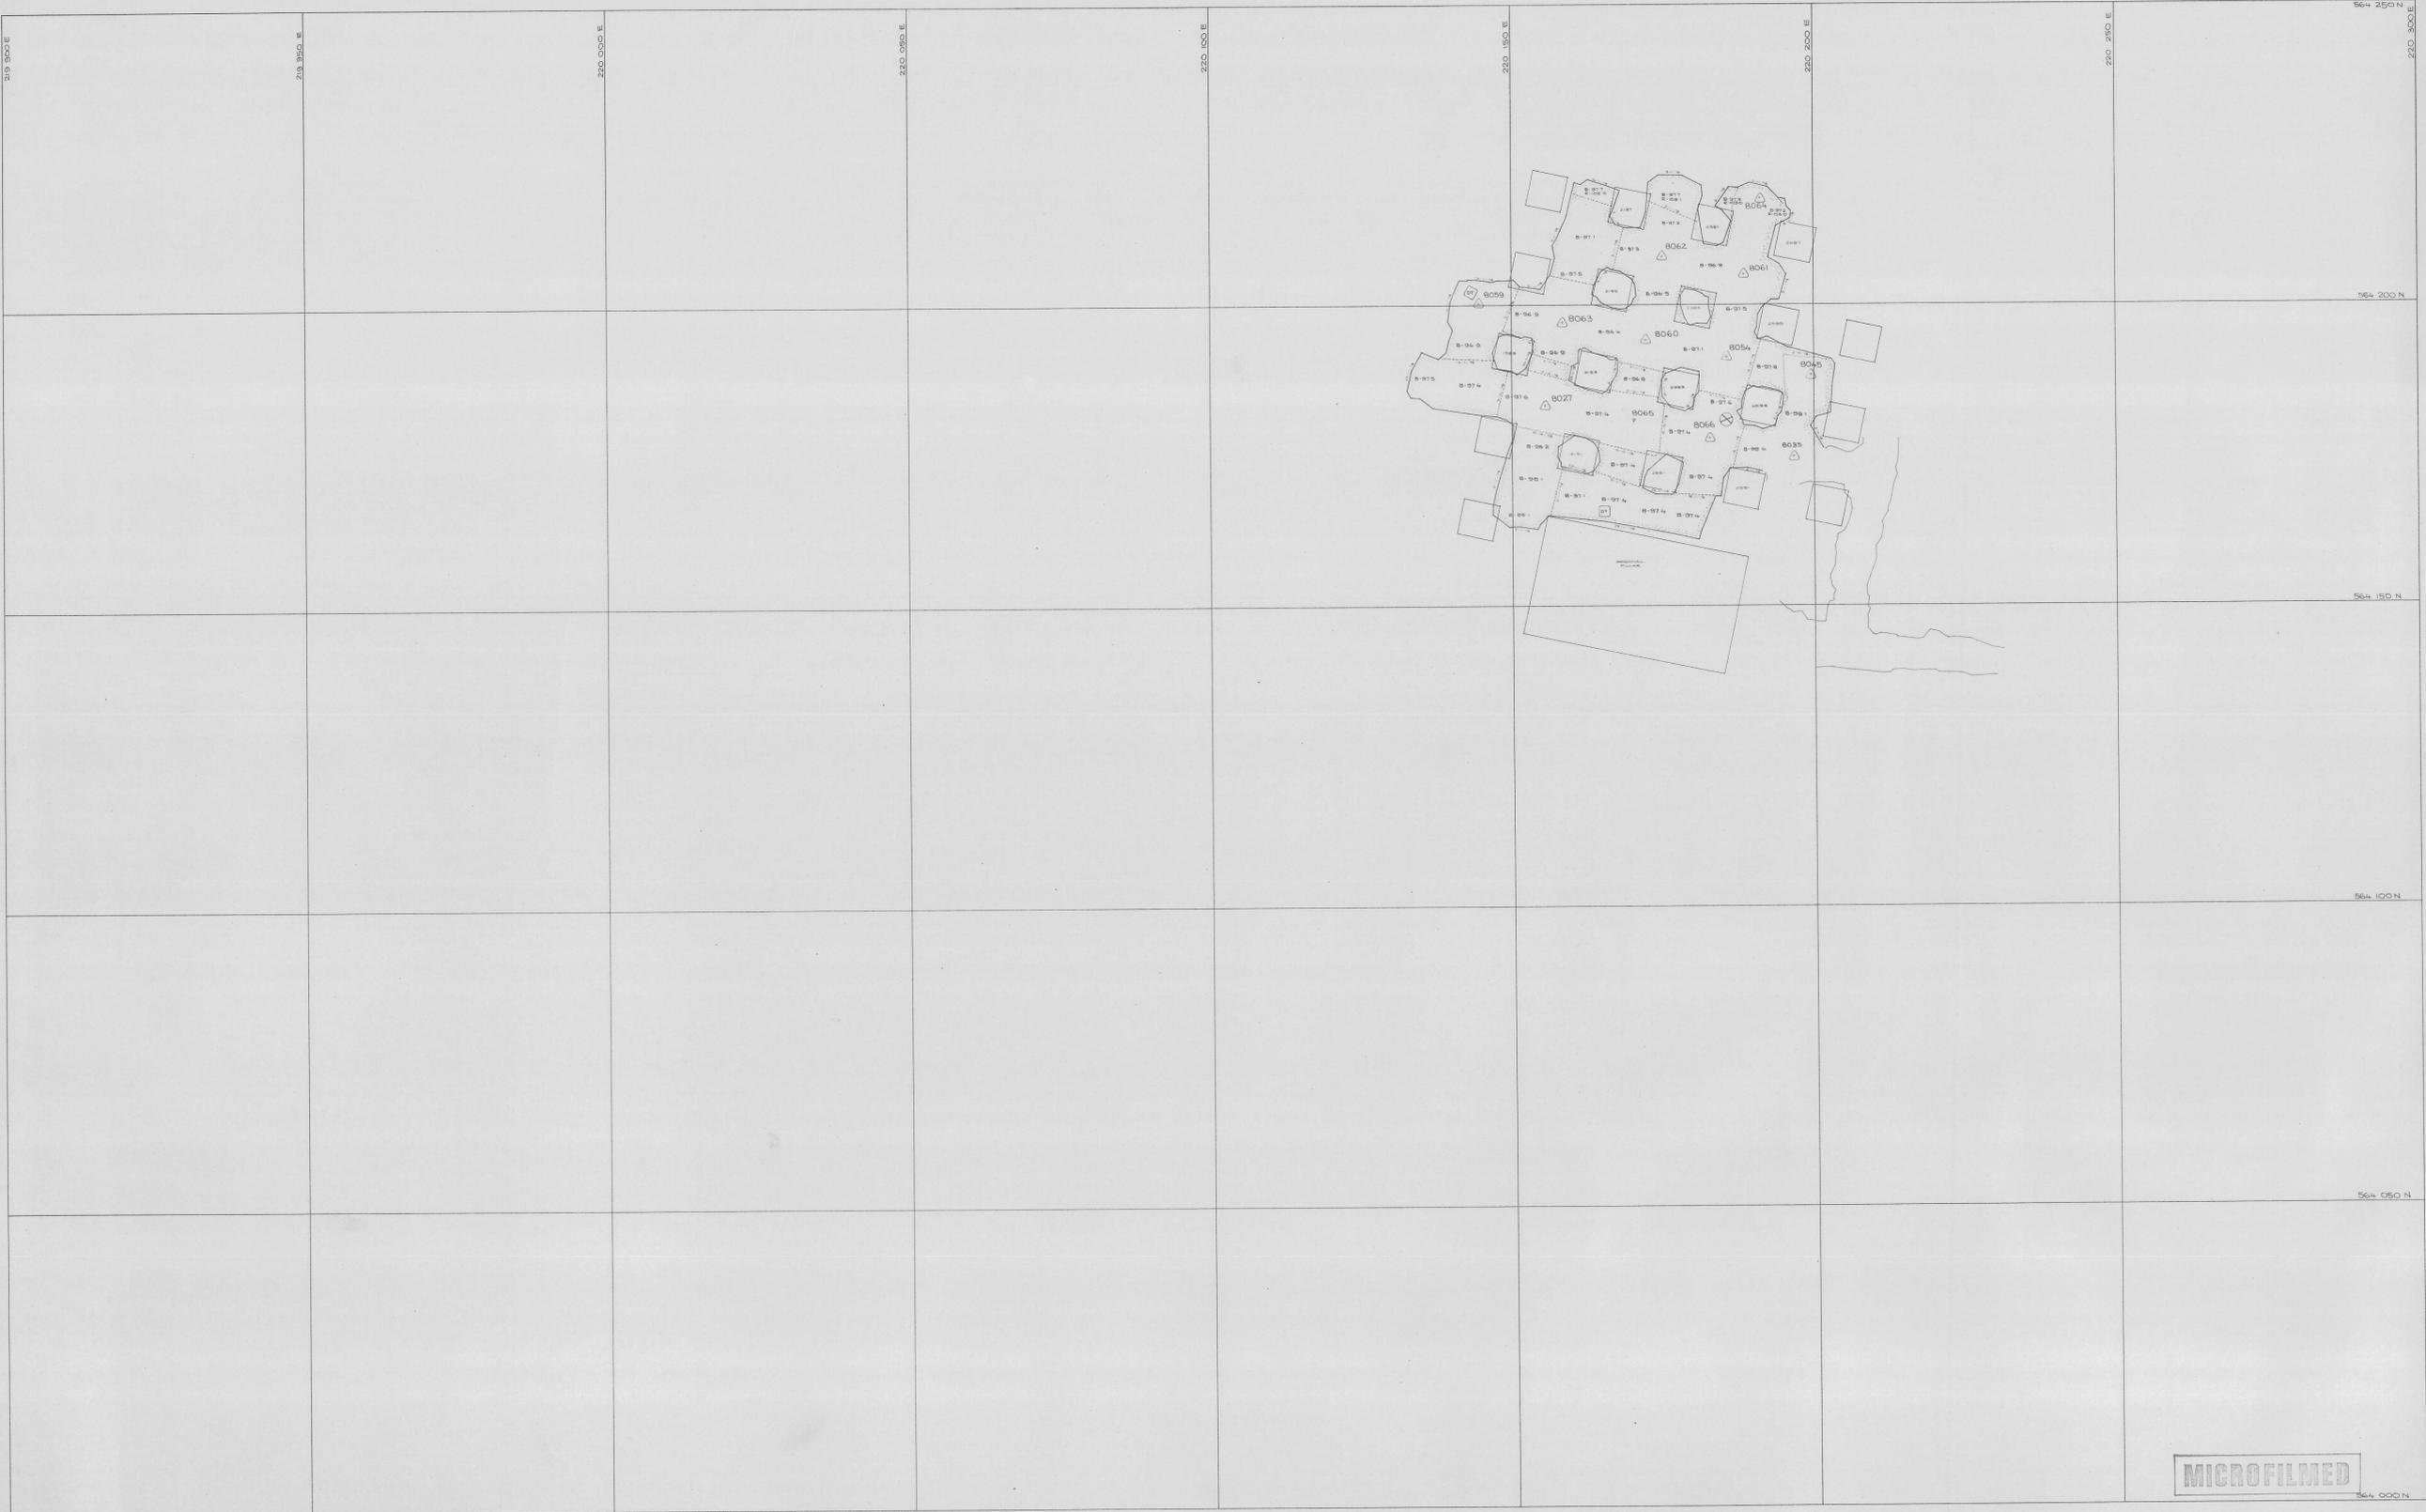

north

LOCATION DOLPHIN MINE
 SUBJECT
 C WEDGE STOPE - 101m CONTOUR
 PIT
 CENTRAL

KIS KING ISLAND SCHEELITE
 A DIVISION OF WARMAN INTERNATIONAL
 GRASSY KING ISLAND
 PLAN NUMBER 04DM15 - 1014 8/126