



0374\_533

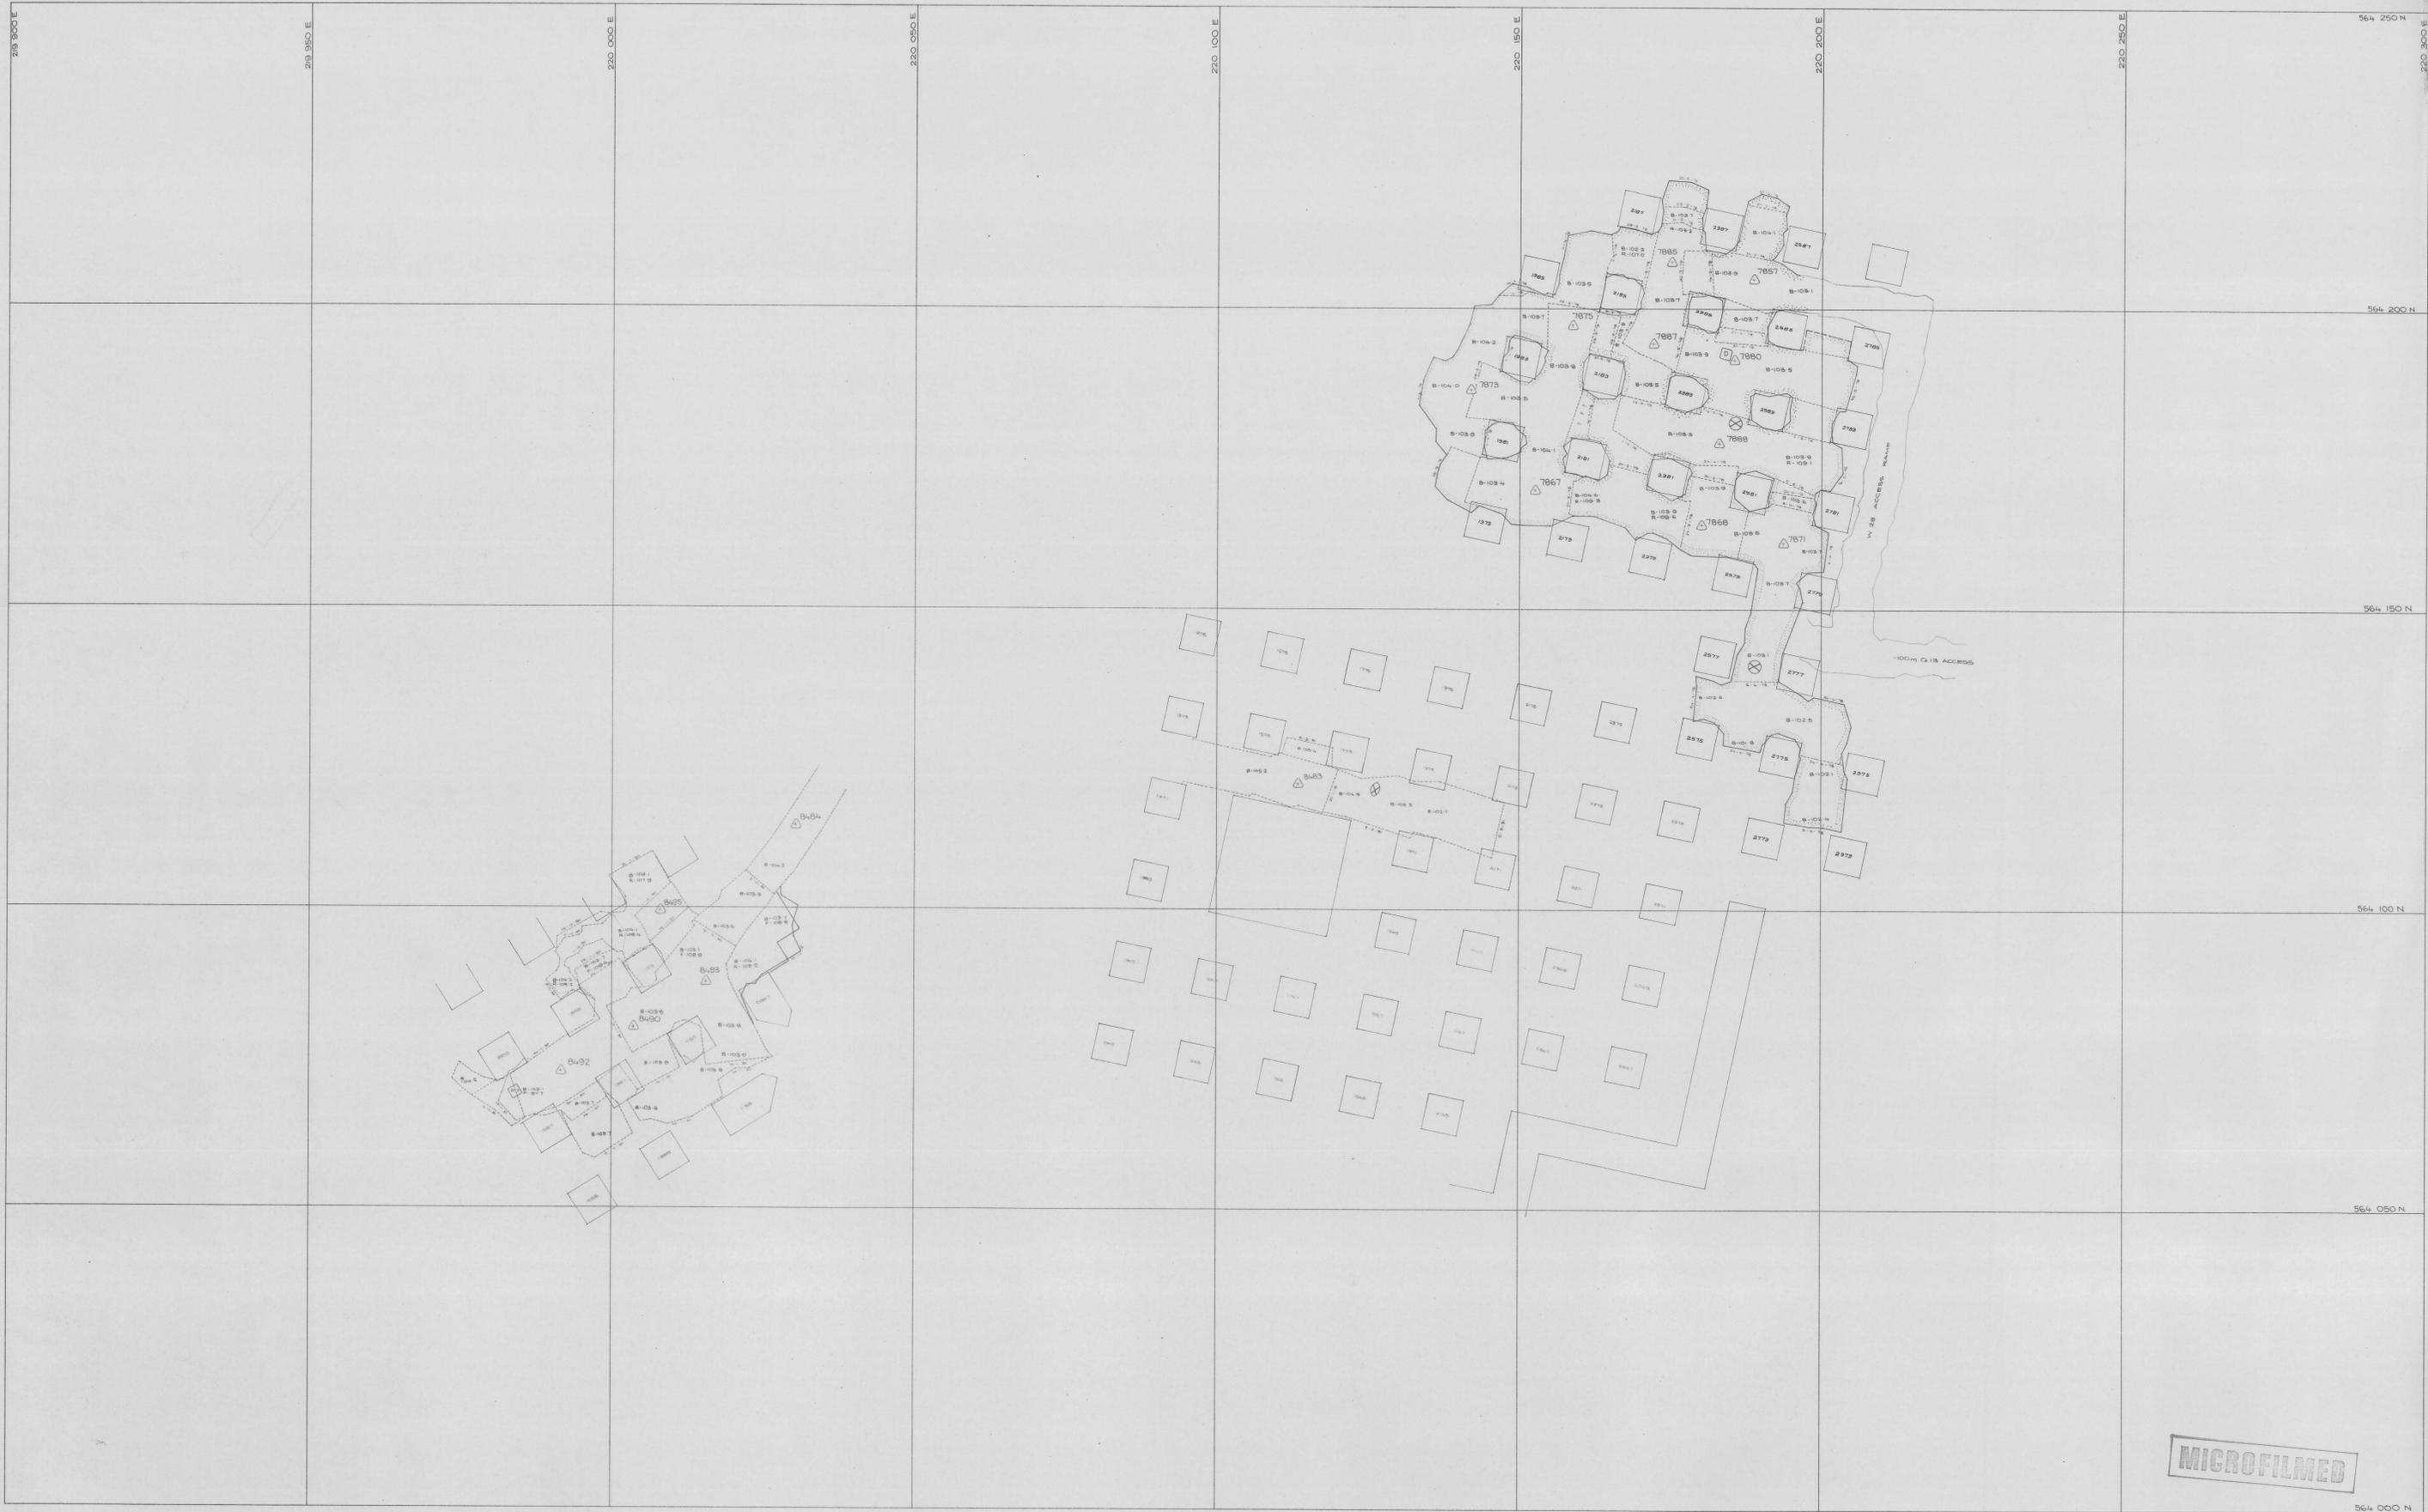

MICROFILMED

SCALE 1:500

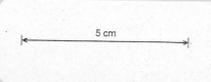

north

LOCATION  
DOLPHIN MINE

SUBJECT  
C WEDGE STOPE -107m CONTOUR  
PIT  
CENTRAL upper  
lower

**KIS** KING ISLAND SCHEELITE  
A DIVISION OF WARMAN INTERNATIONAL

GRASSY KING ISLAND

PLAN NUMBER  
04DM15 - 1016 8/128