


0374_534



MICROFILMED

SCALE 1:500

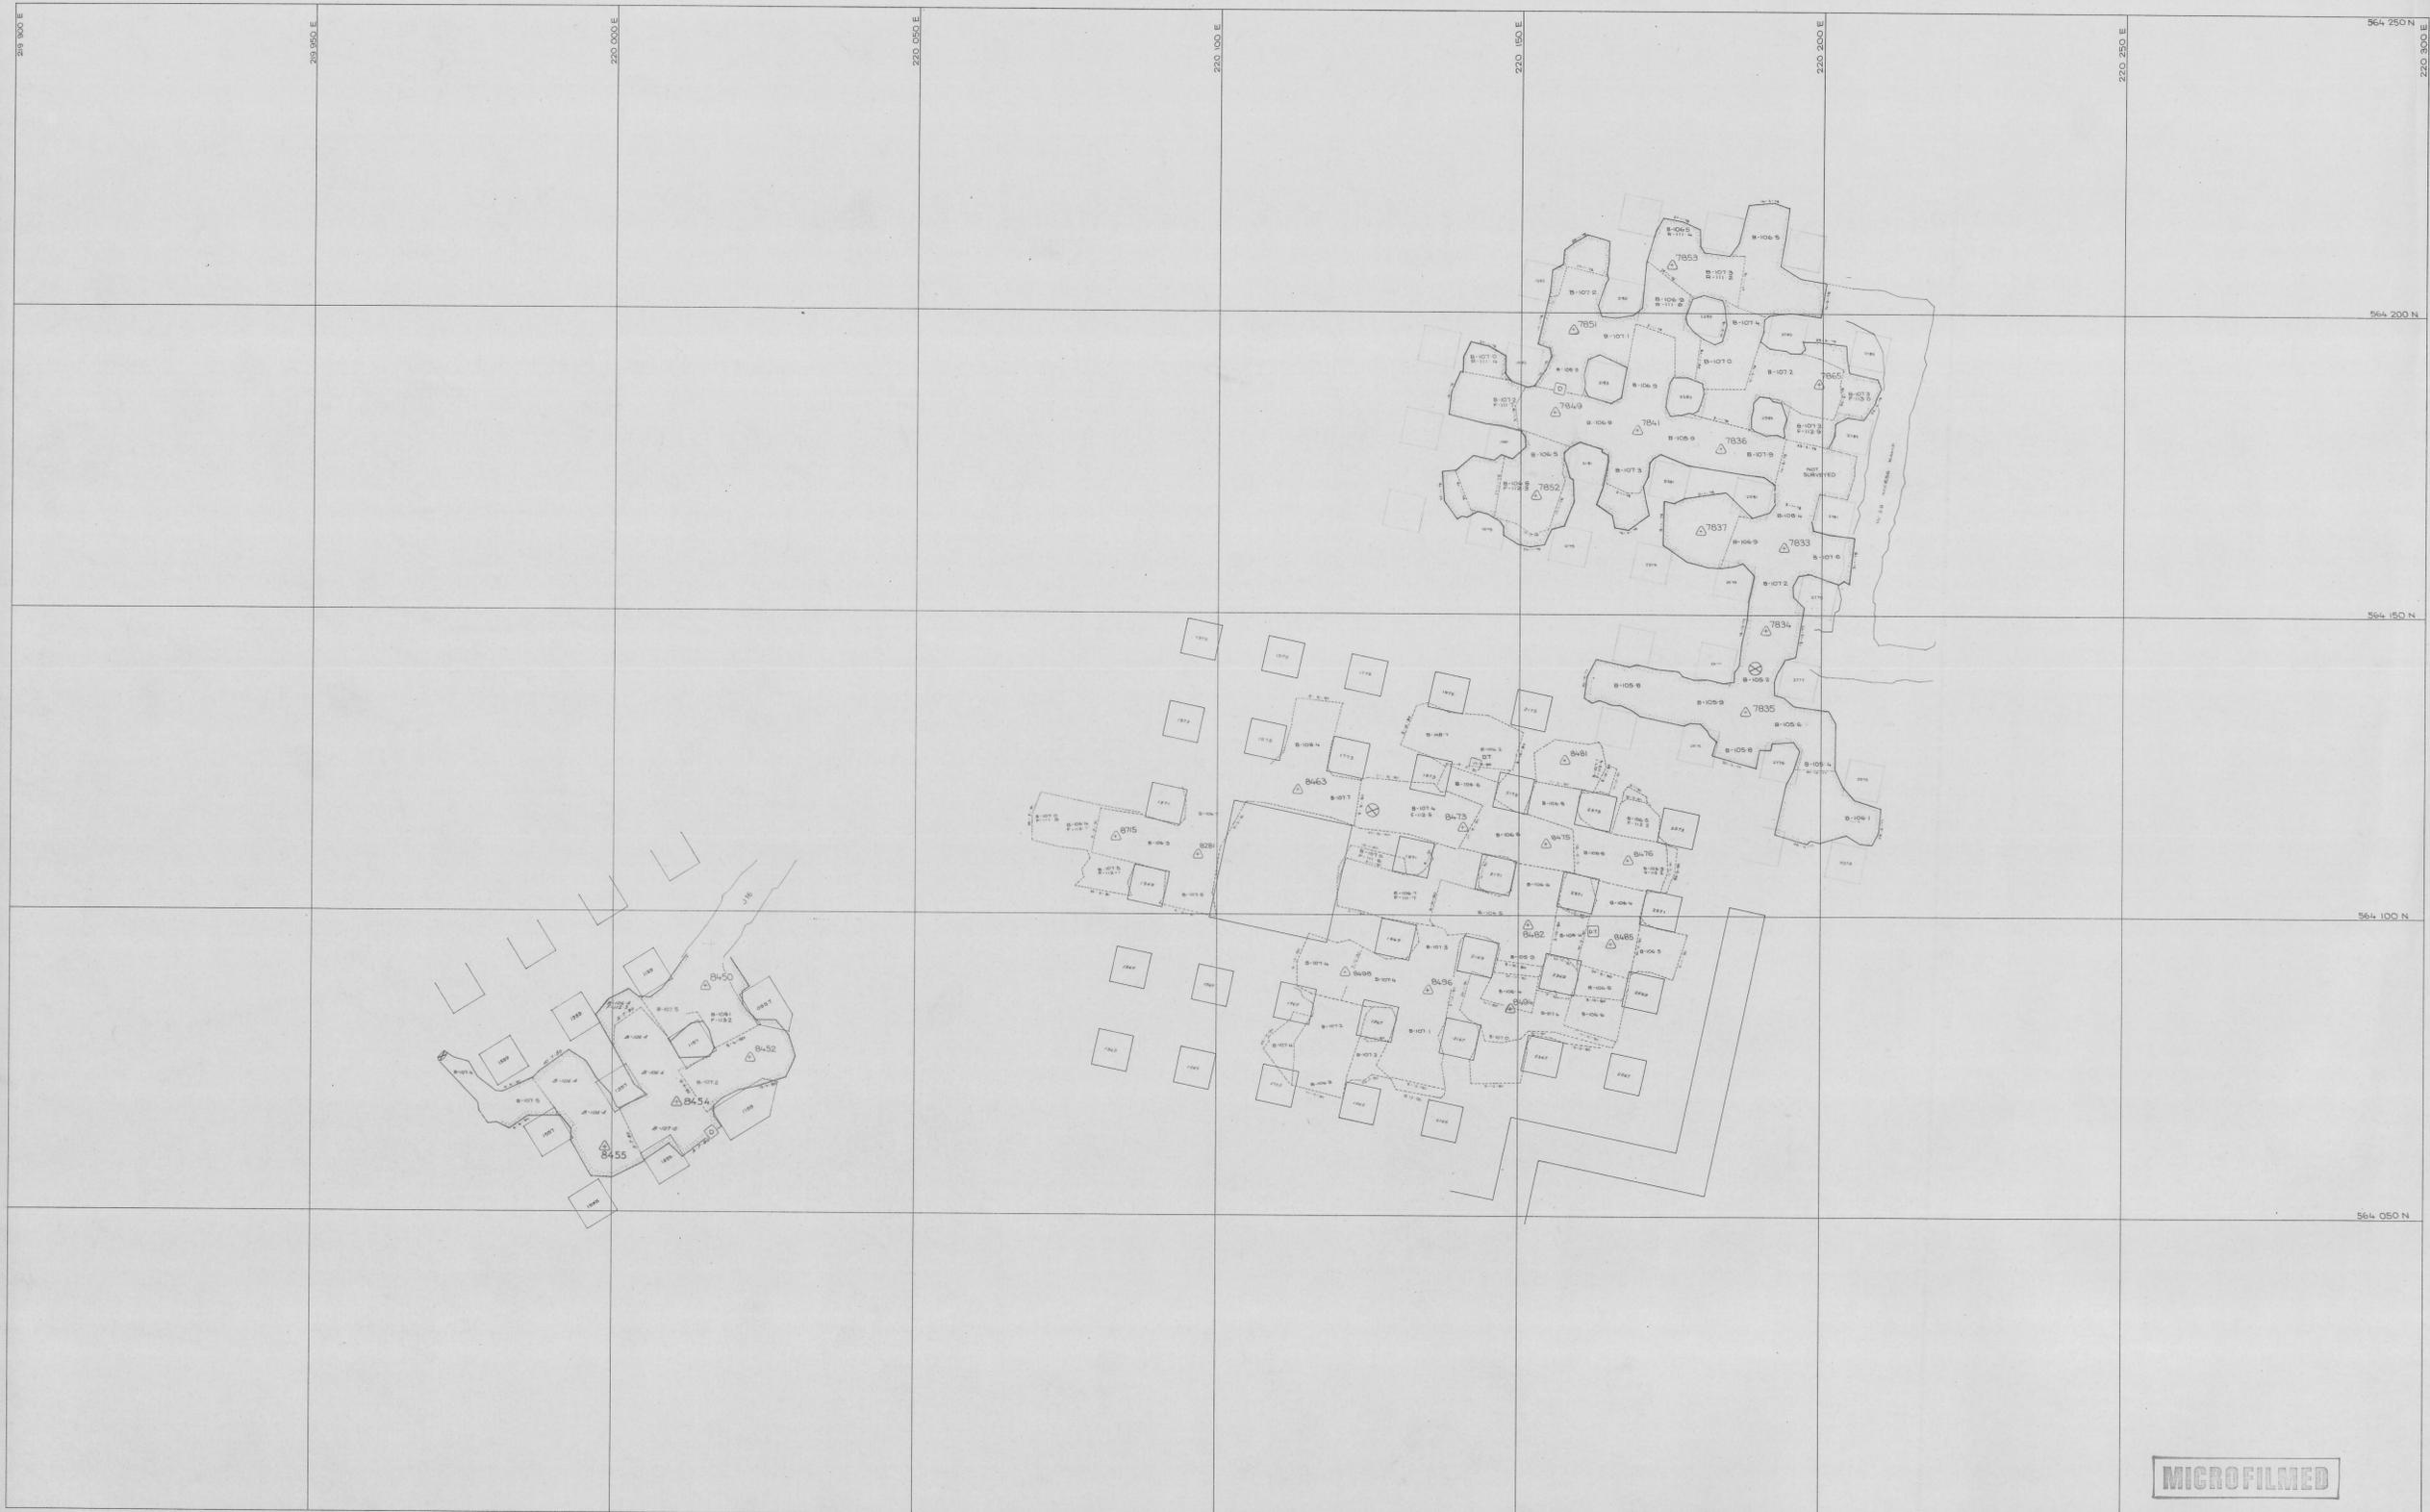

north

LOCATION

DOLPHIN MINE

SUBJECT

C WEDGE STOPE -110m CONTOUR
 PIT
 CENTRAL upper
 lower

KIS KING ISLAND SCHEELITE
 A DIVISION OF WARMAN INTERNATIONAL
 GRASSY KING ISLAND

PLAN NUMBER 04DM15 - 1017 8/129