



0374_537

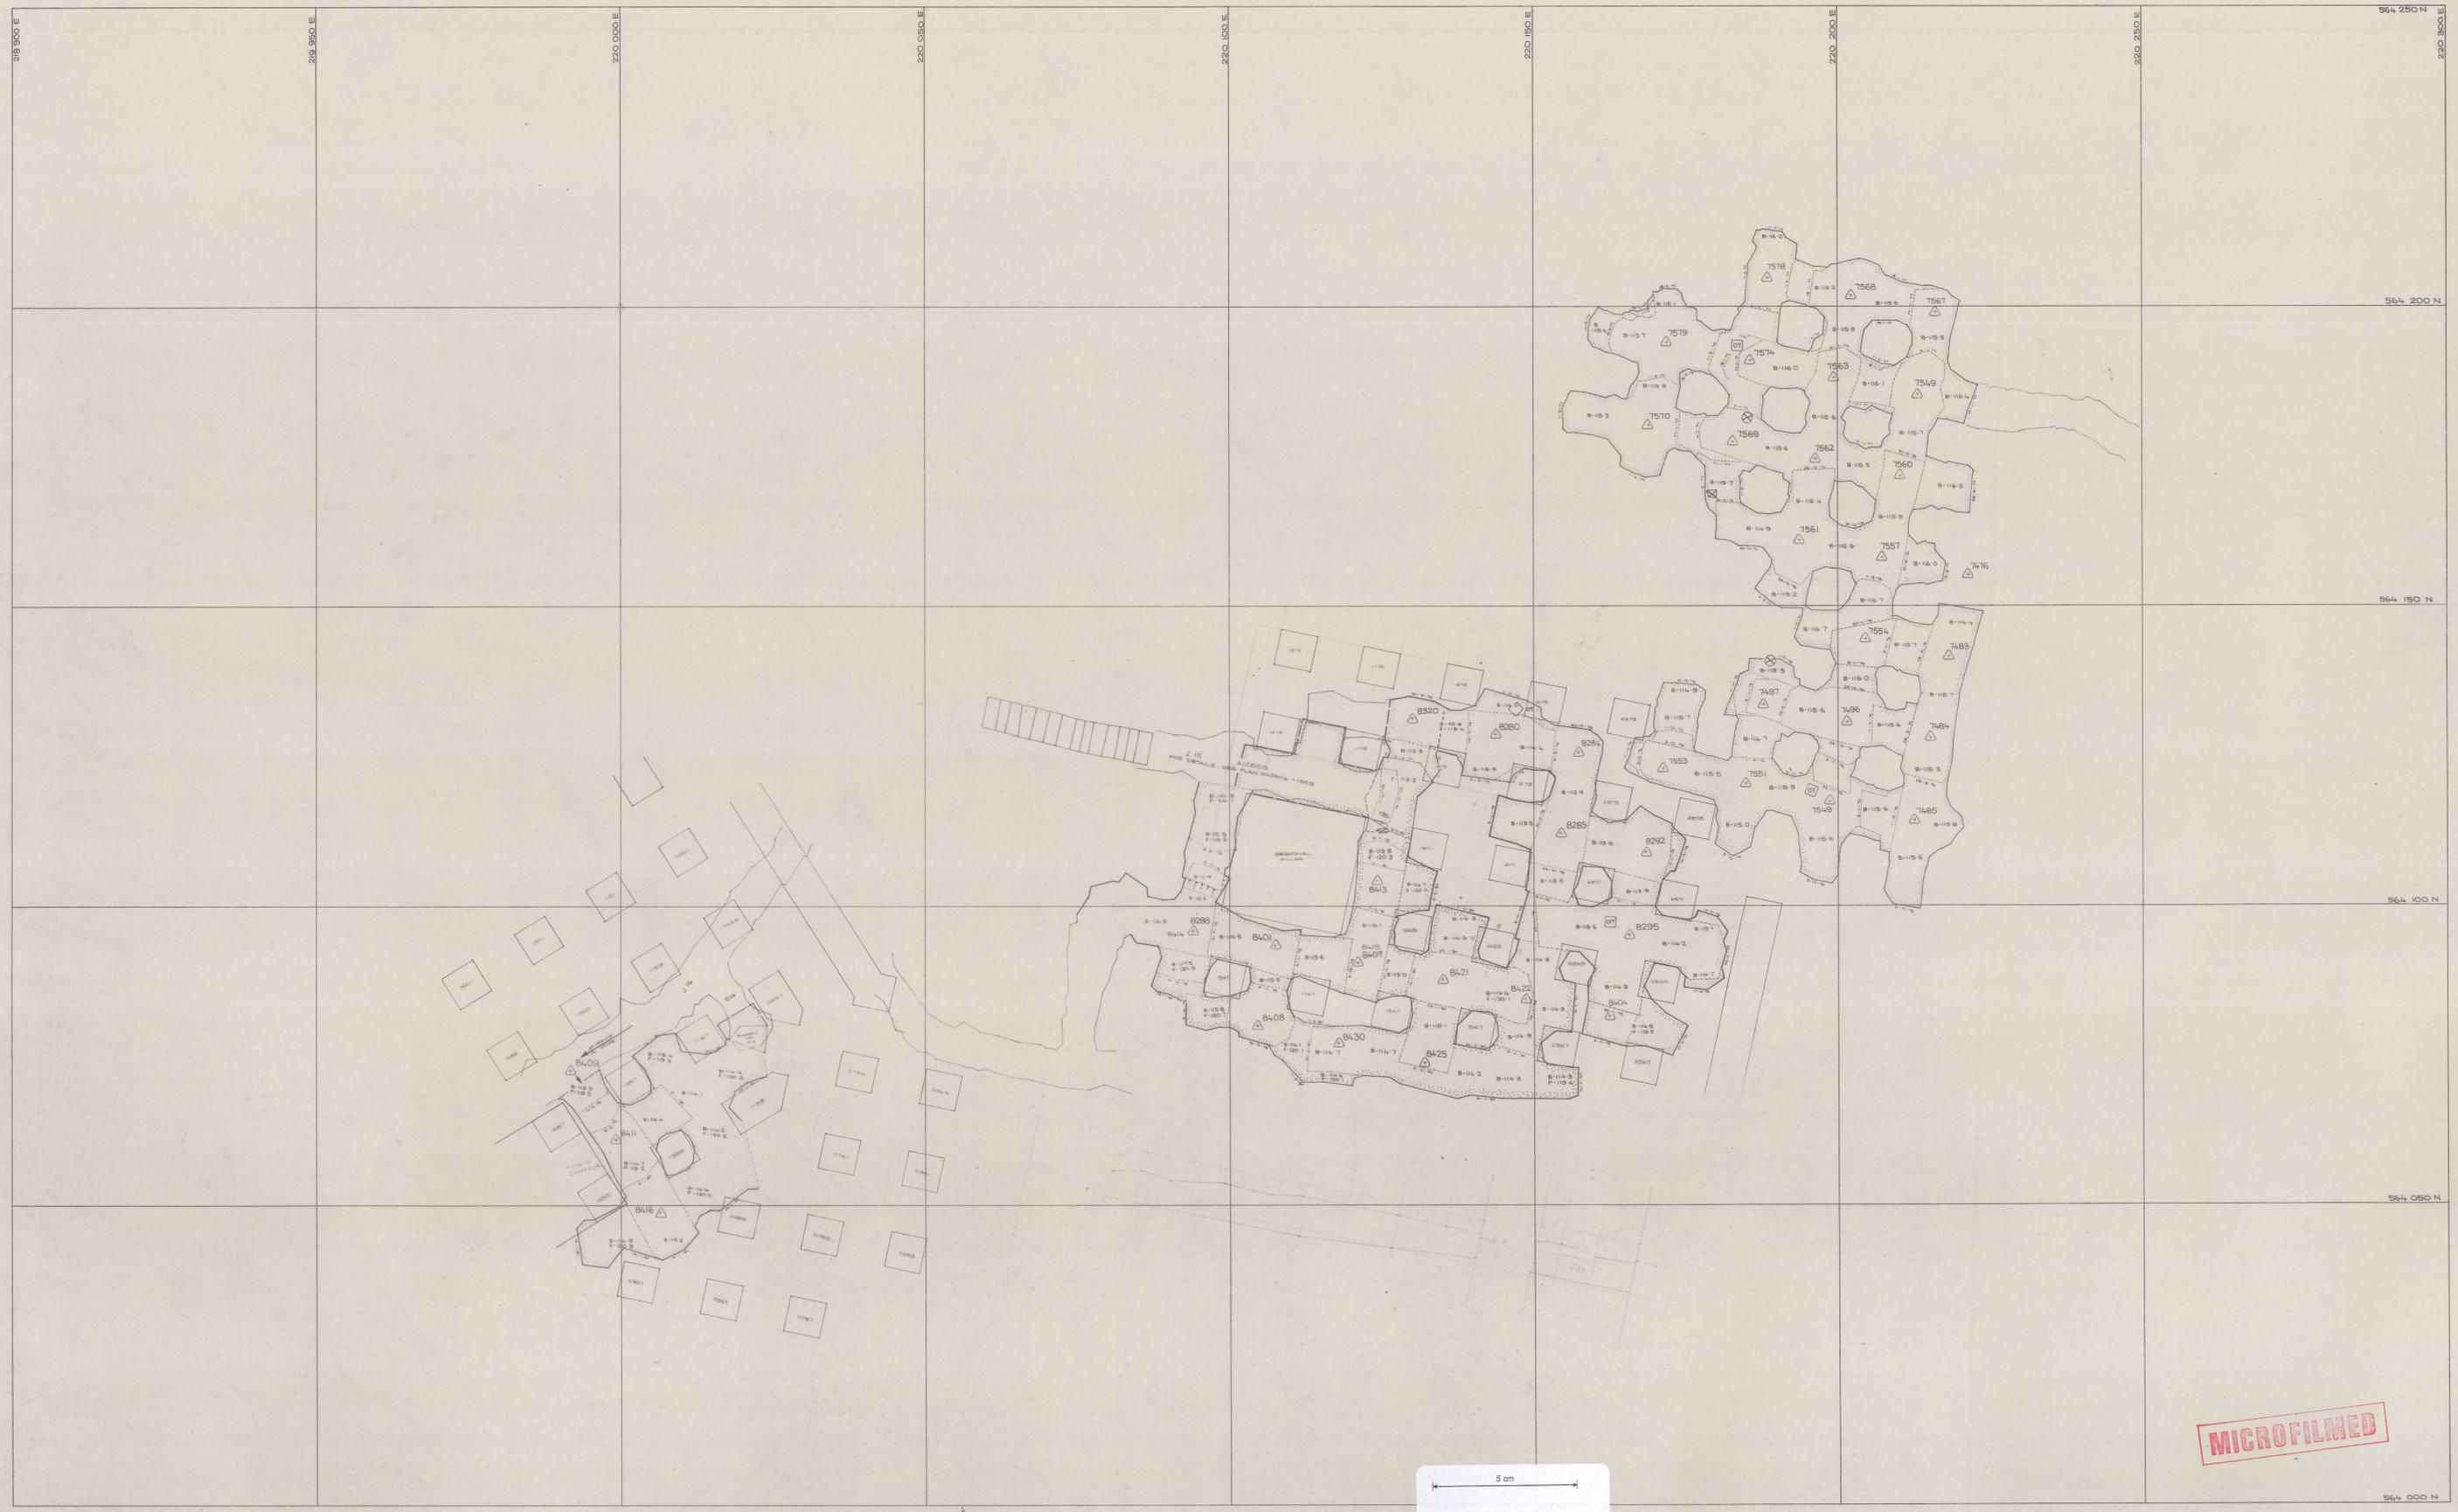

MICROFILMED

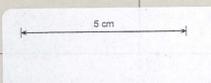

<p>SCALE 1:500</p> <p>Note</p> <ul style="list-style-type: none"> C Wedge Slope - Life N° 3 C Central Slope - Life N° 9 C Pit Slope - Life N° 10 - 117.5m Contour 	<p>LOCATION DOLPHIN MINE</p> <p>SUBJECT C WEDGE, CENTRAL & PIT STOPES</p> <p>- -119m CONTOUR</p> <p>north</p>	<p>KIS KING ISLAND SCHEELITE A DIVISION OF WARMAN INTERNATIONAL</p> <p>GRASSY KING ISLAND</p> <p>PLAN NUMBER 04DM15 - 1020</p>	<p>81132</p>
--	---	--	--------------