



0374_543

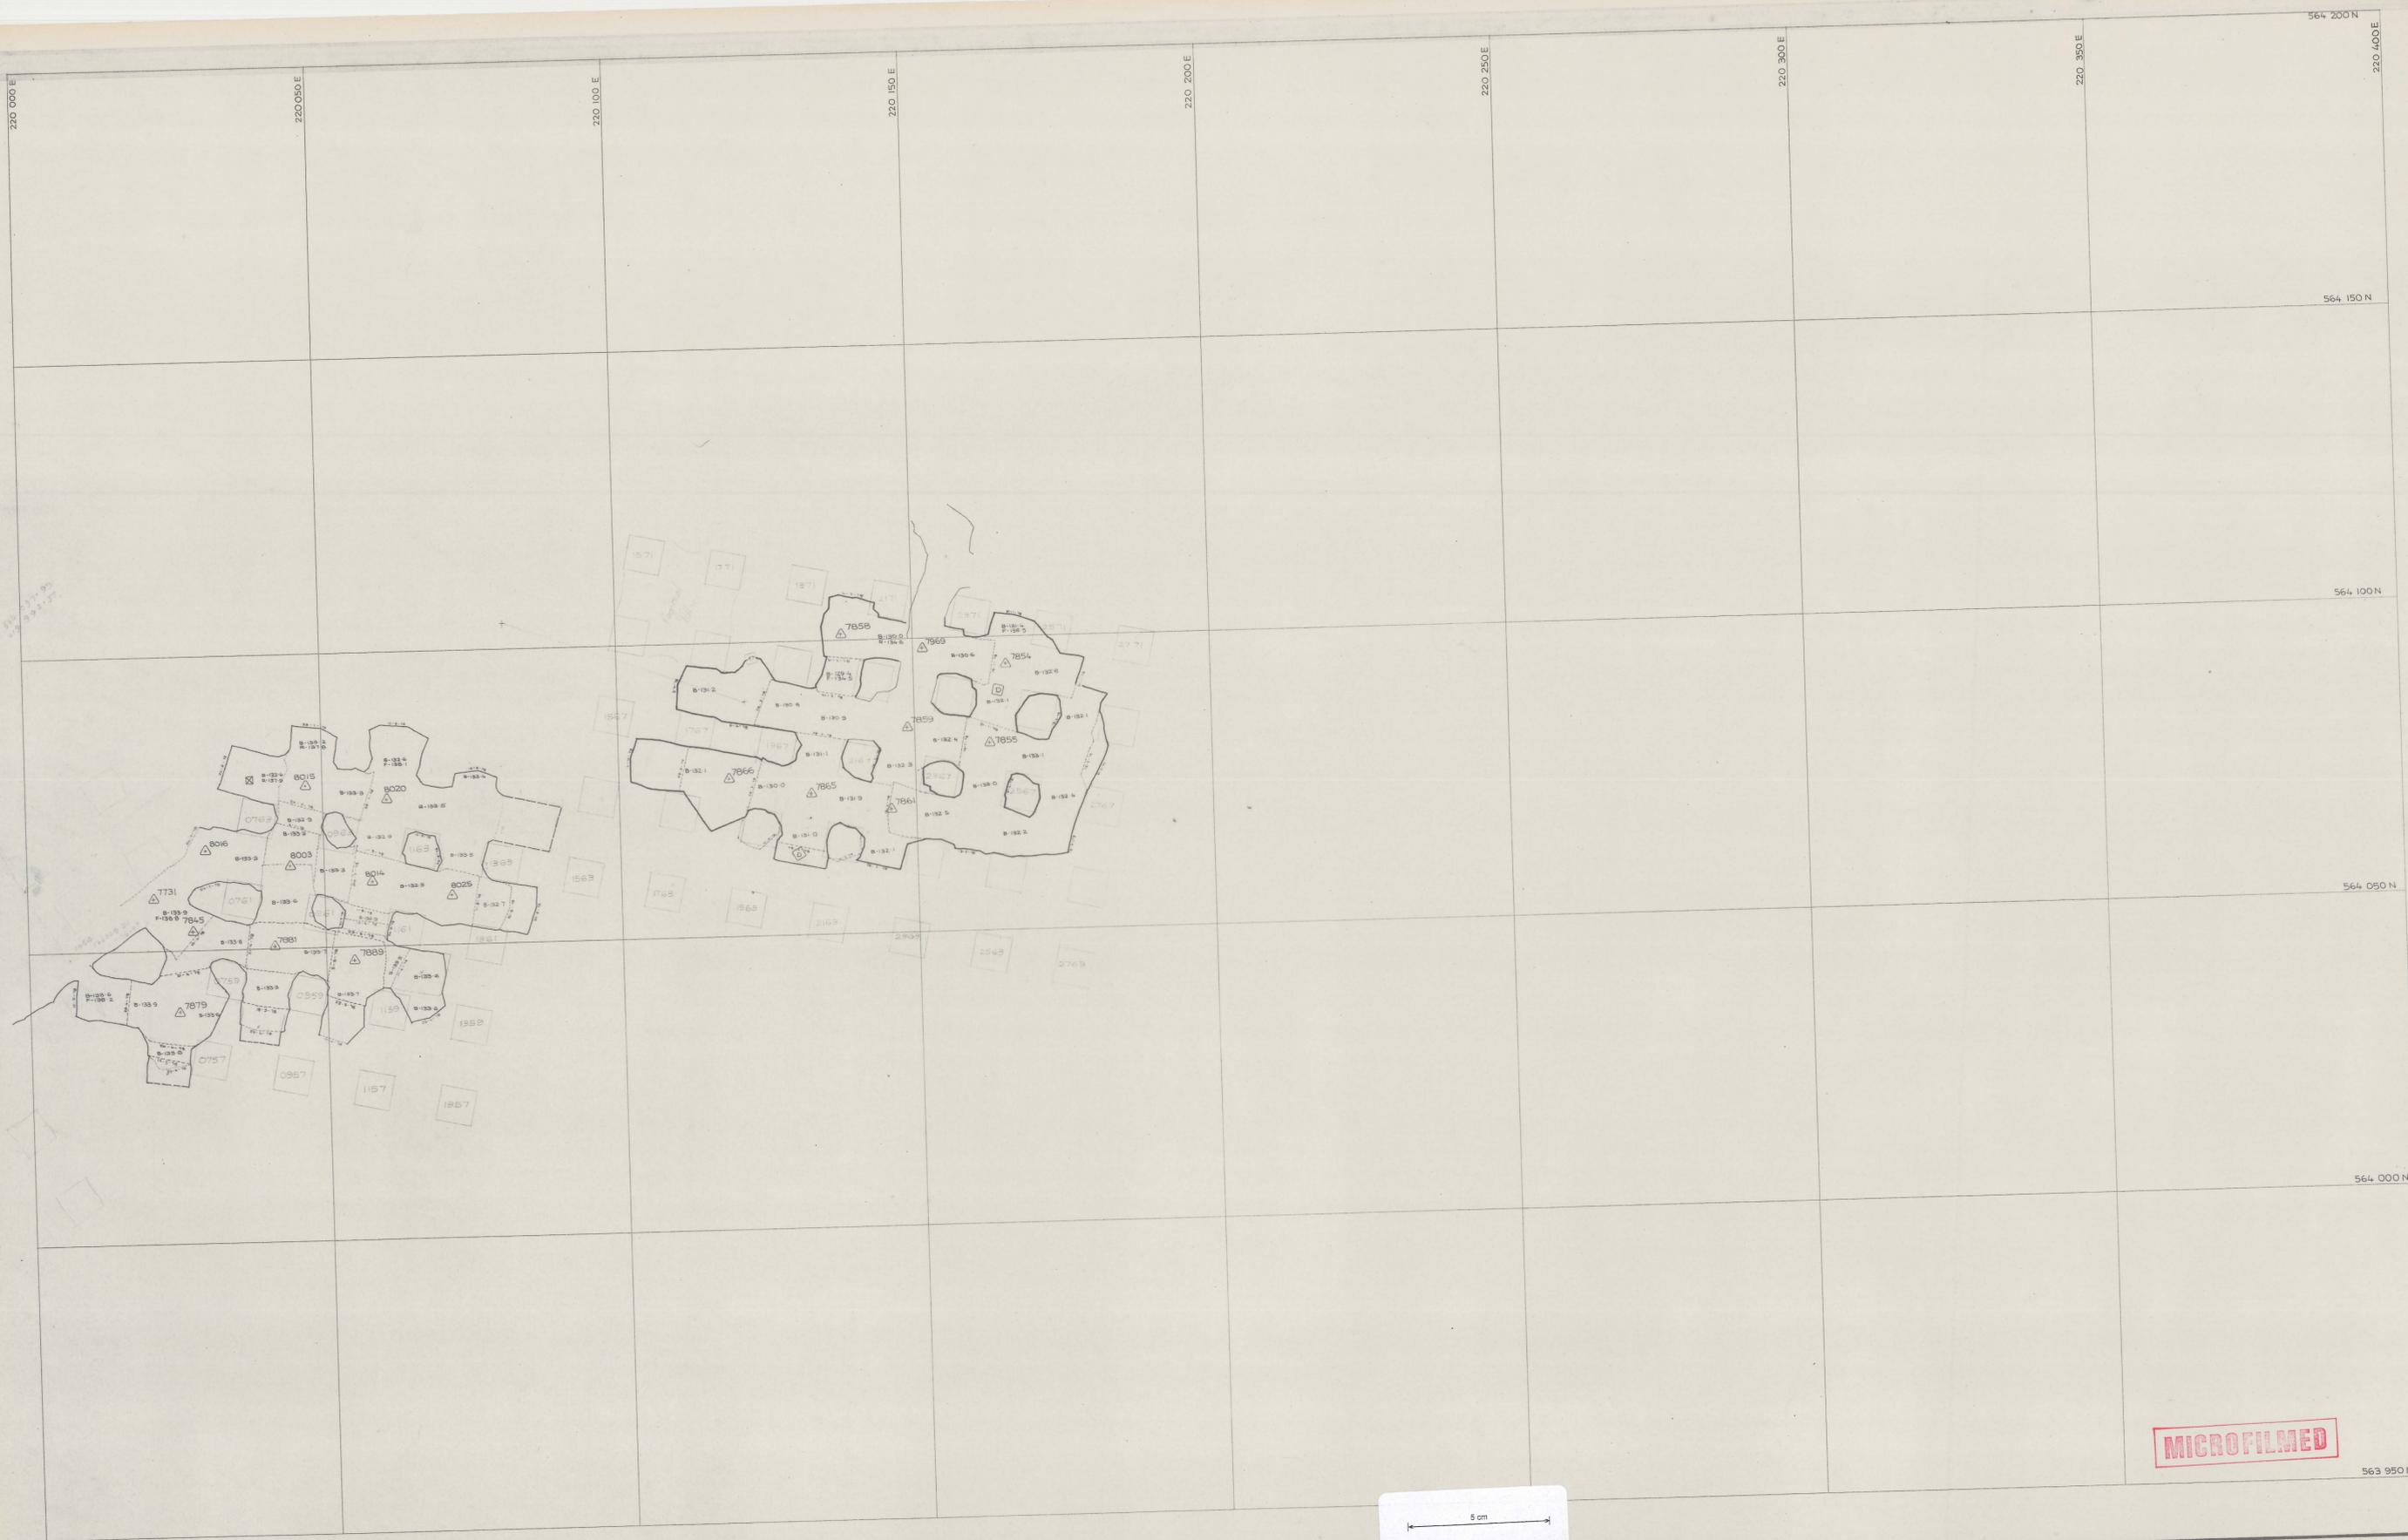

MICROFILMED

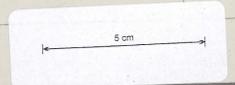

SCALE 1:500	LOCATION	DOLPHIN MINE	
	SUBJECT	- 135m CONTOUR C CENTRAL & C PIT STOPES	
north	PLAN NUMBER	04DM15 - 1026	81138