


0374_547

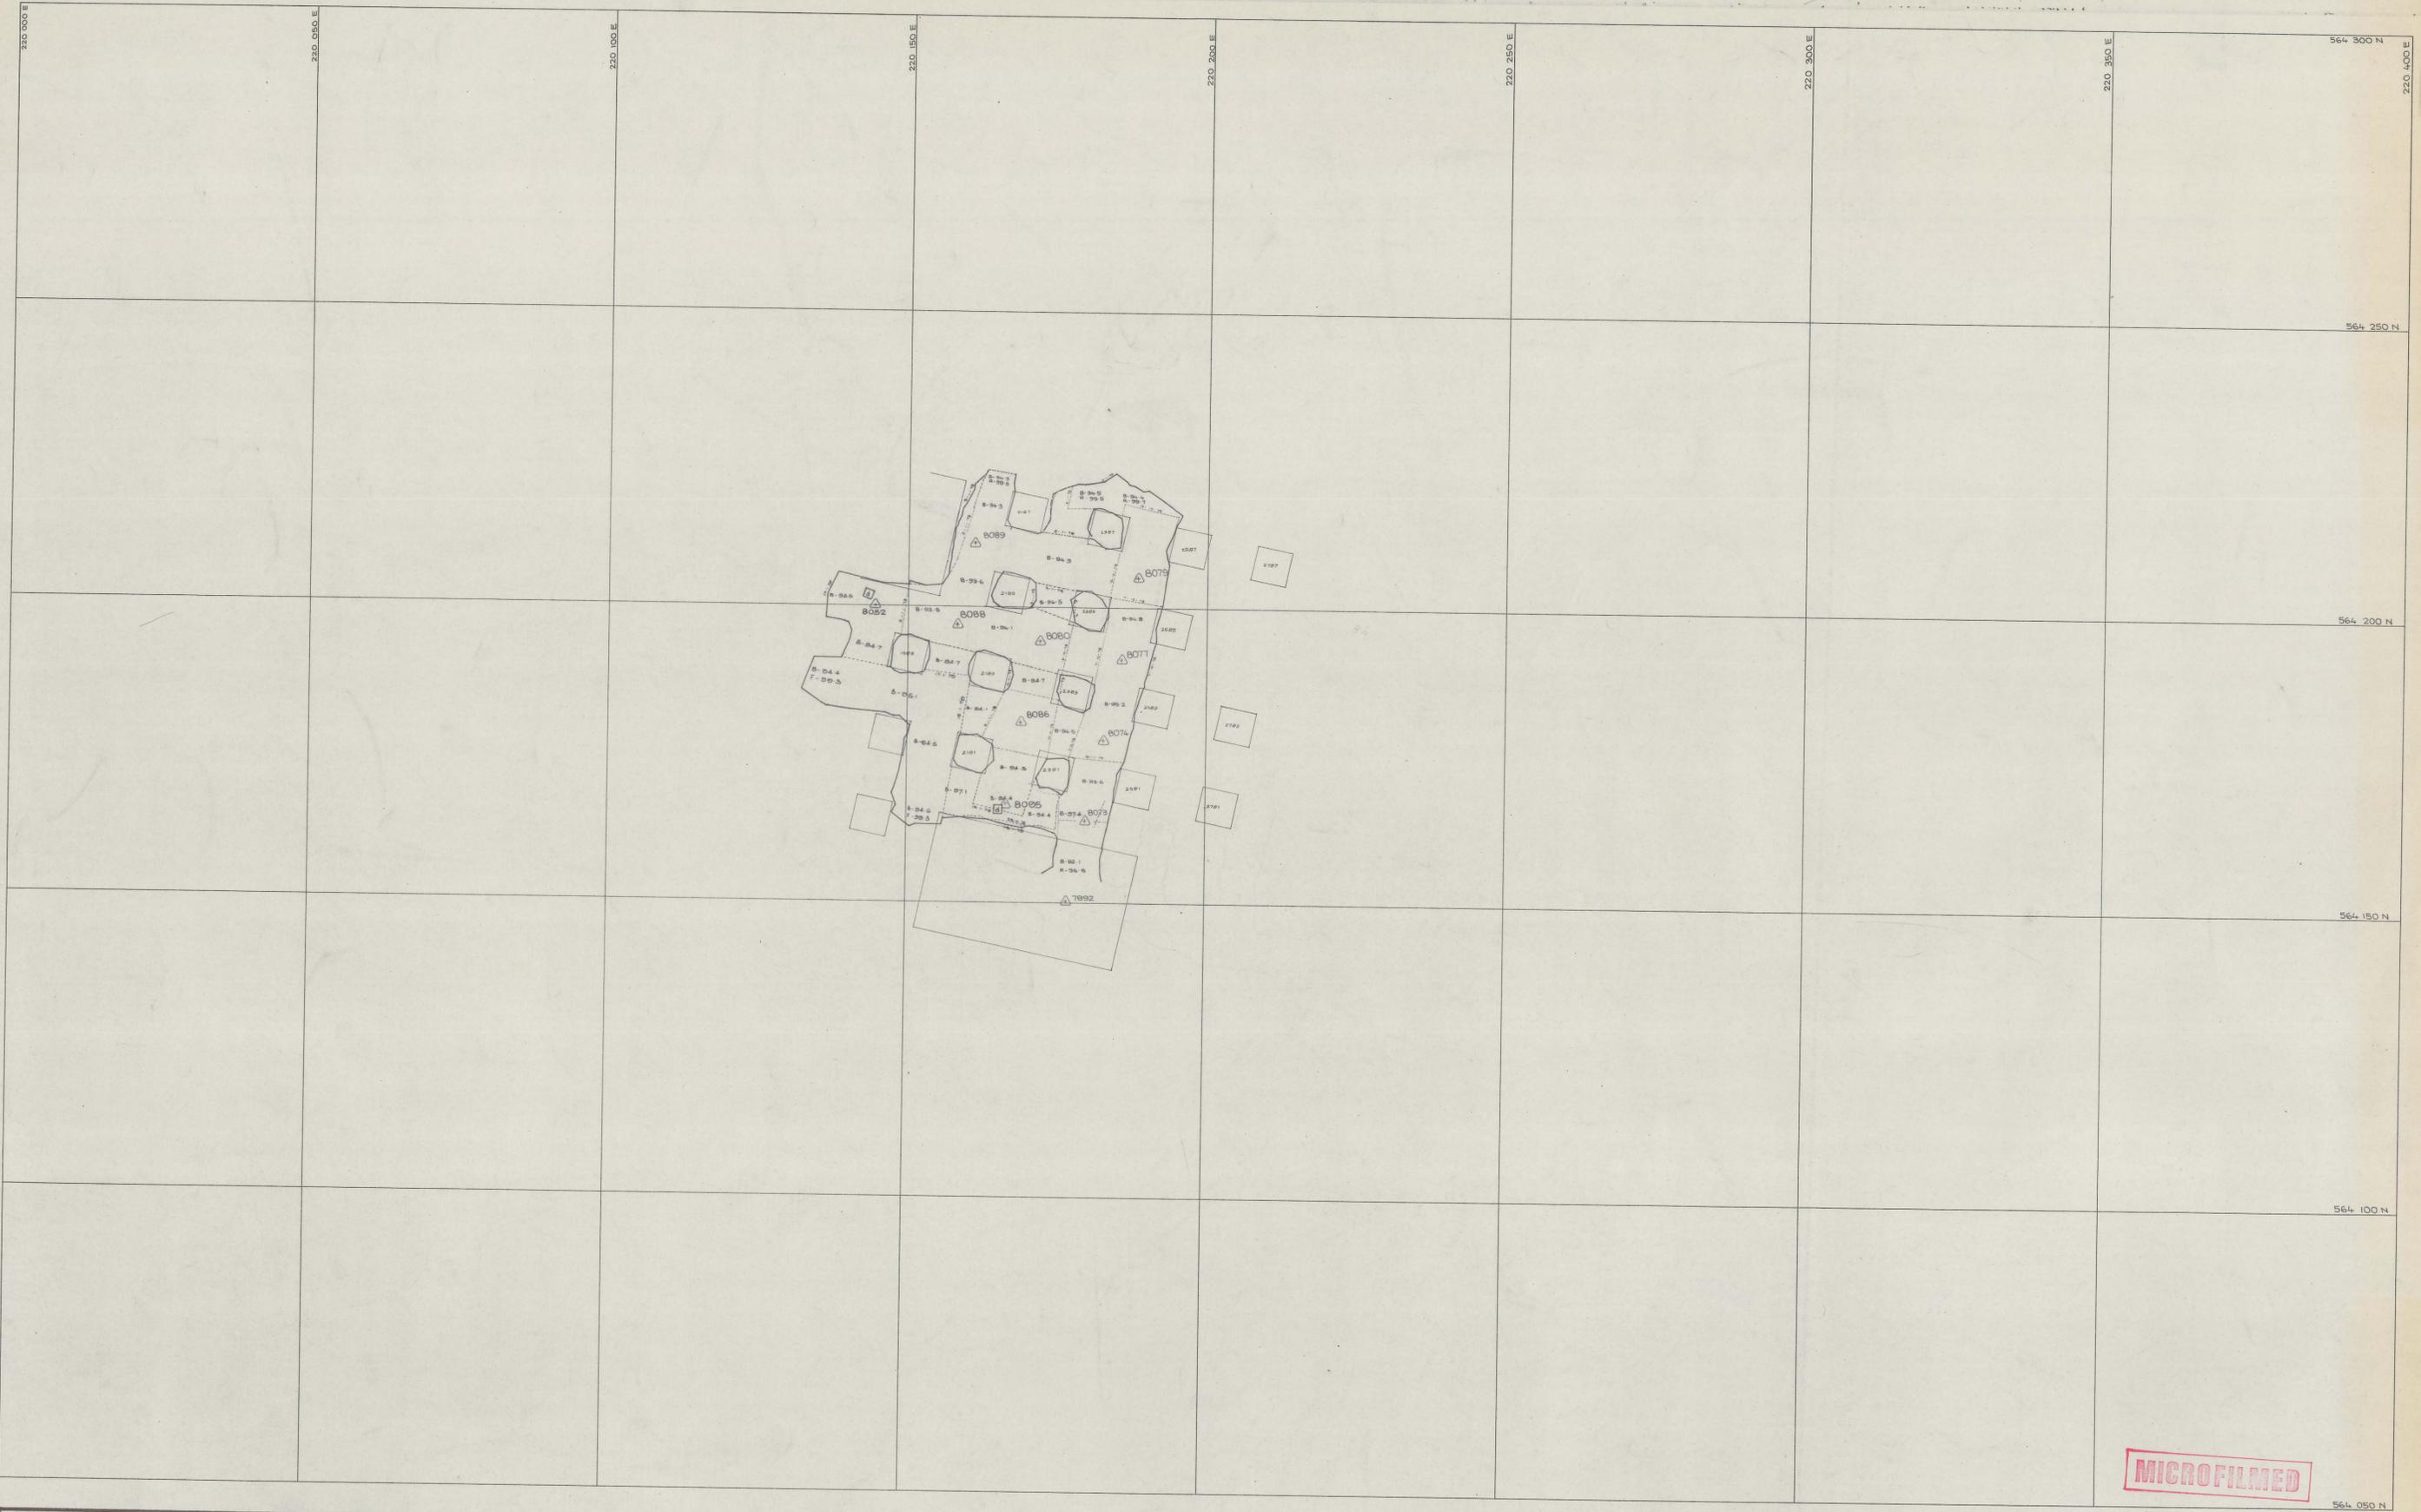

MICROFILMED

SCALE 1: 500		LOCATION DOLPHIN MINE	
		SUBJECT C WEDGE STOPE - 98m CONTOUR	
north		PLAN NUMBER 04DM15 - 1013	81125