


0374_548

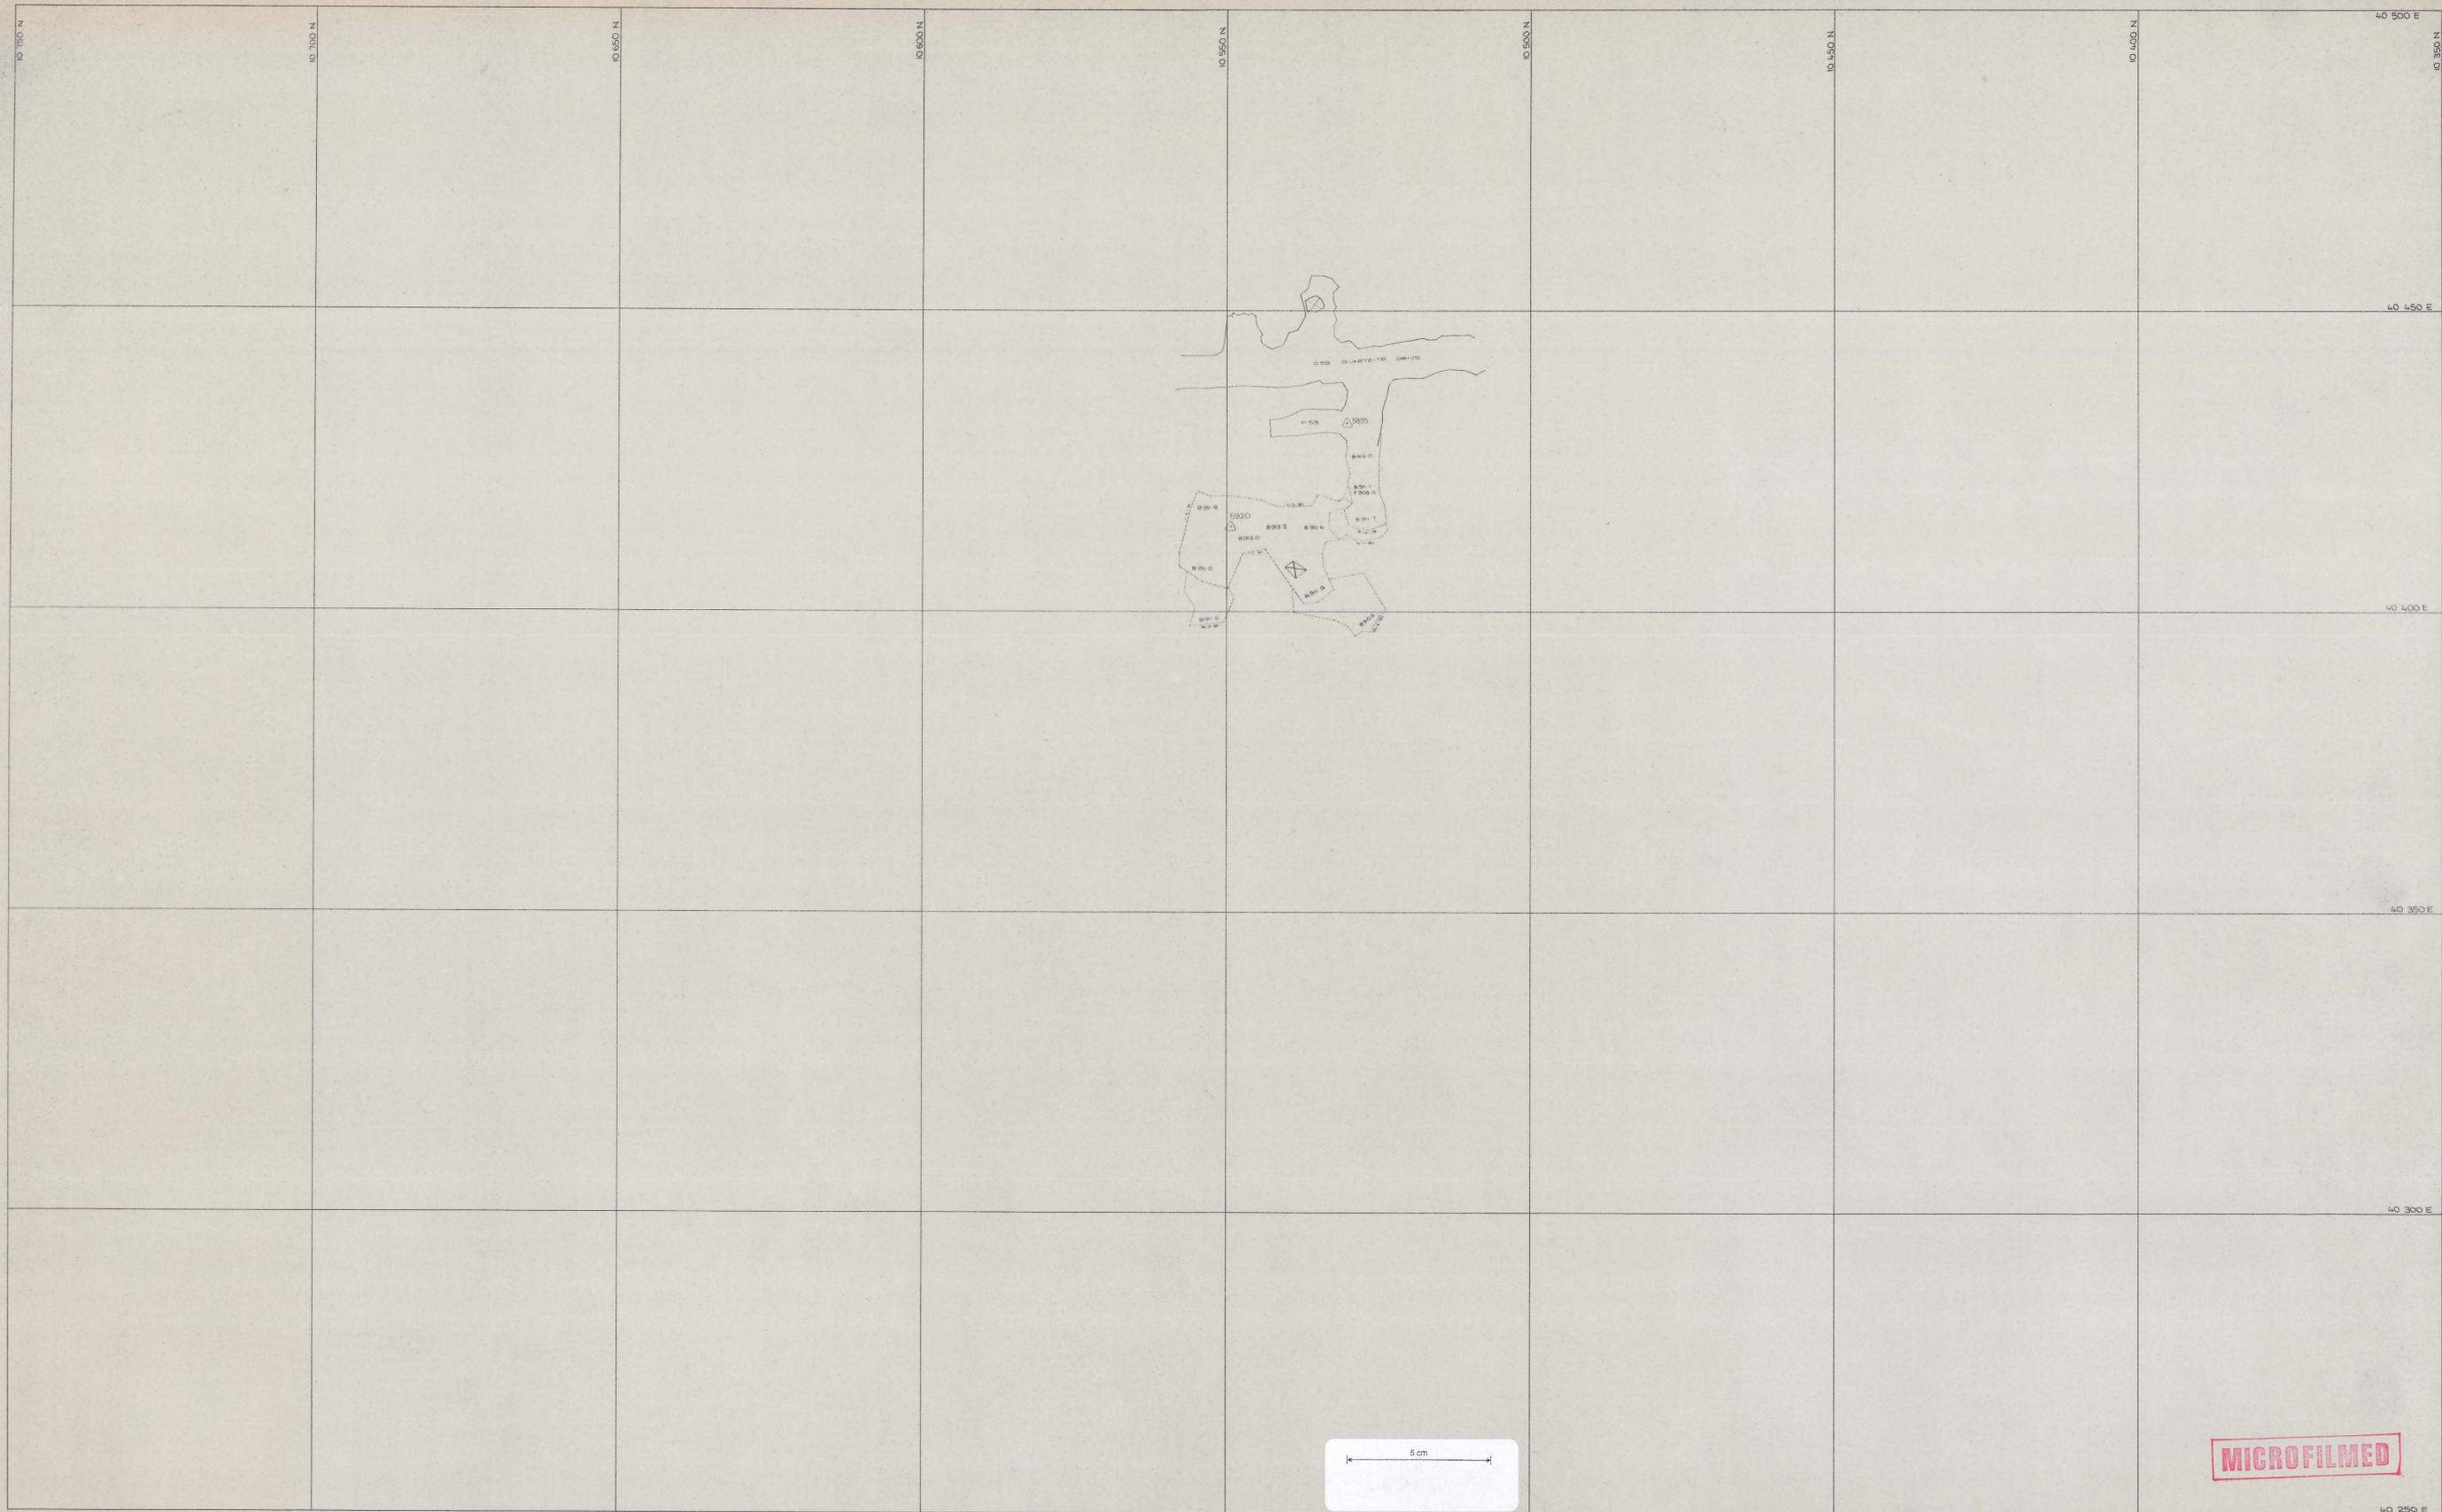

5 cm

MICROFILMED

	SCALE 1:500	LOCATION BOLD HEAD MINE	
		SUBJECT T53 1st lift	

north