
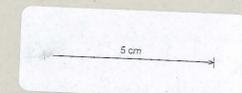


0374_552

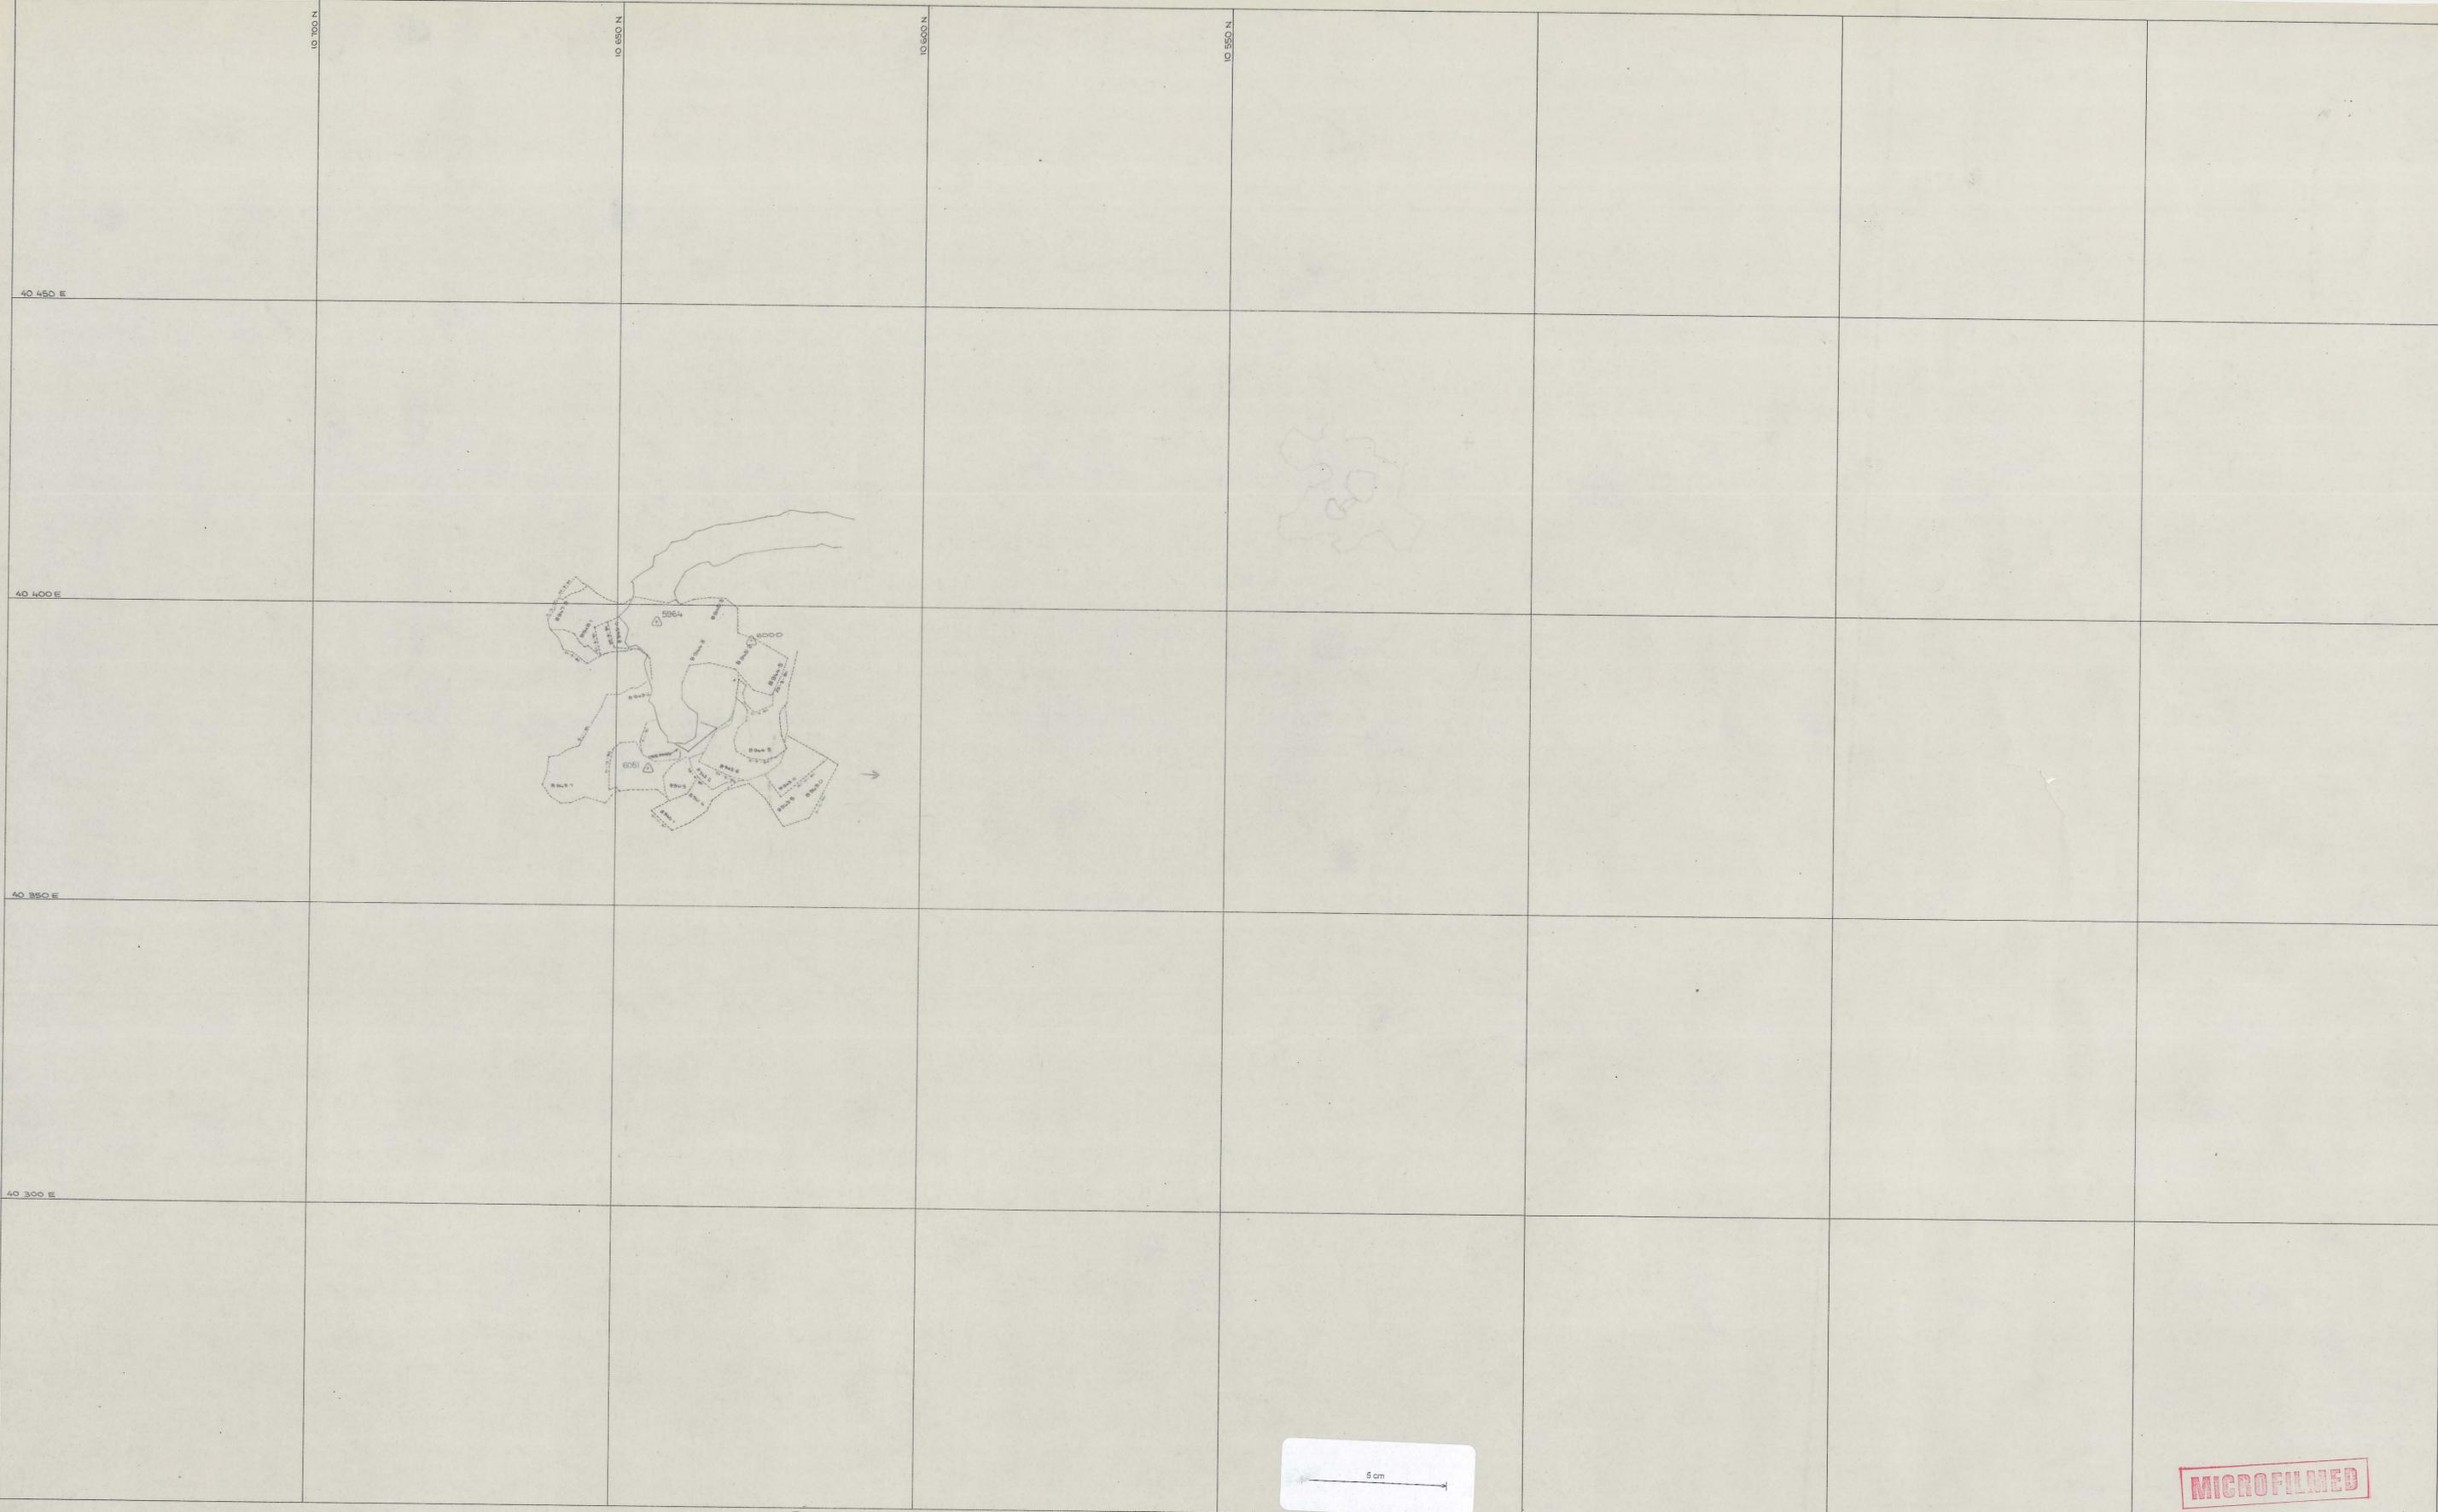

MICROFILMED

| | | | |
|--|--------------|-------------------------|--|
| | SCALE 1: 500 | LOCATION BOLD HEAD MINE | |
| | | SUBJECT R 60 - 5th lift | |
| | | north | |