
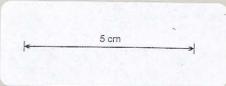


0374_553

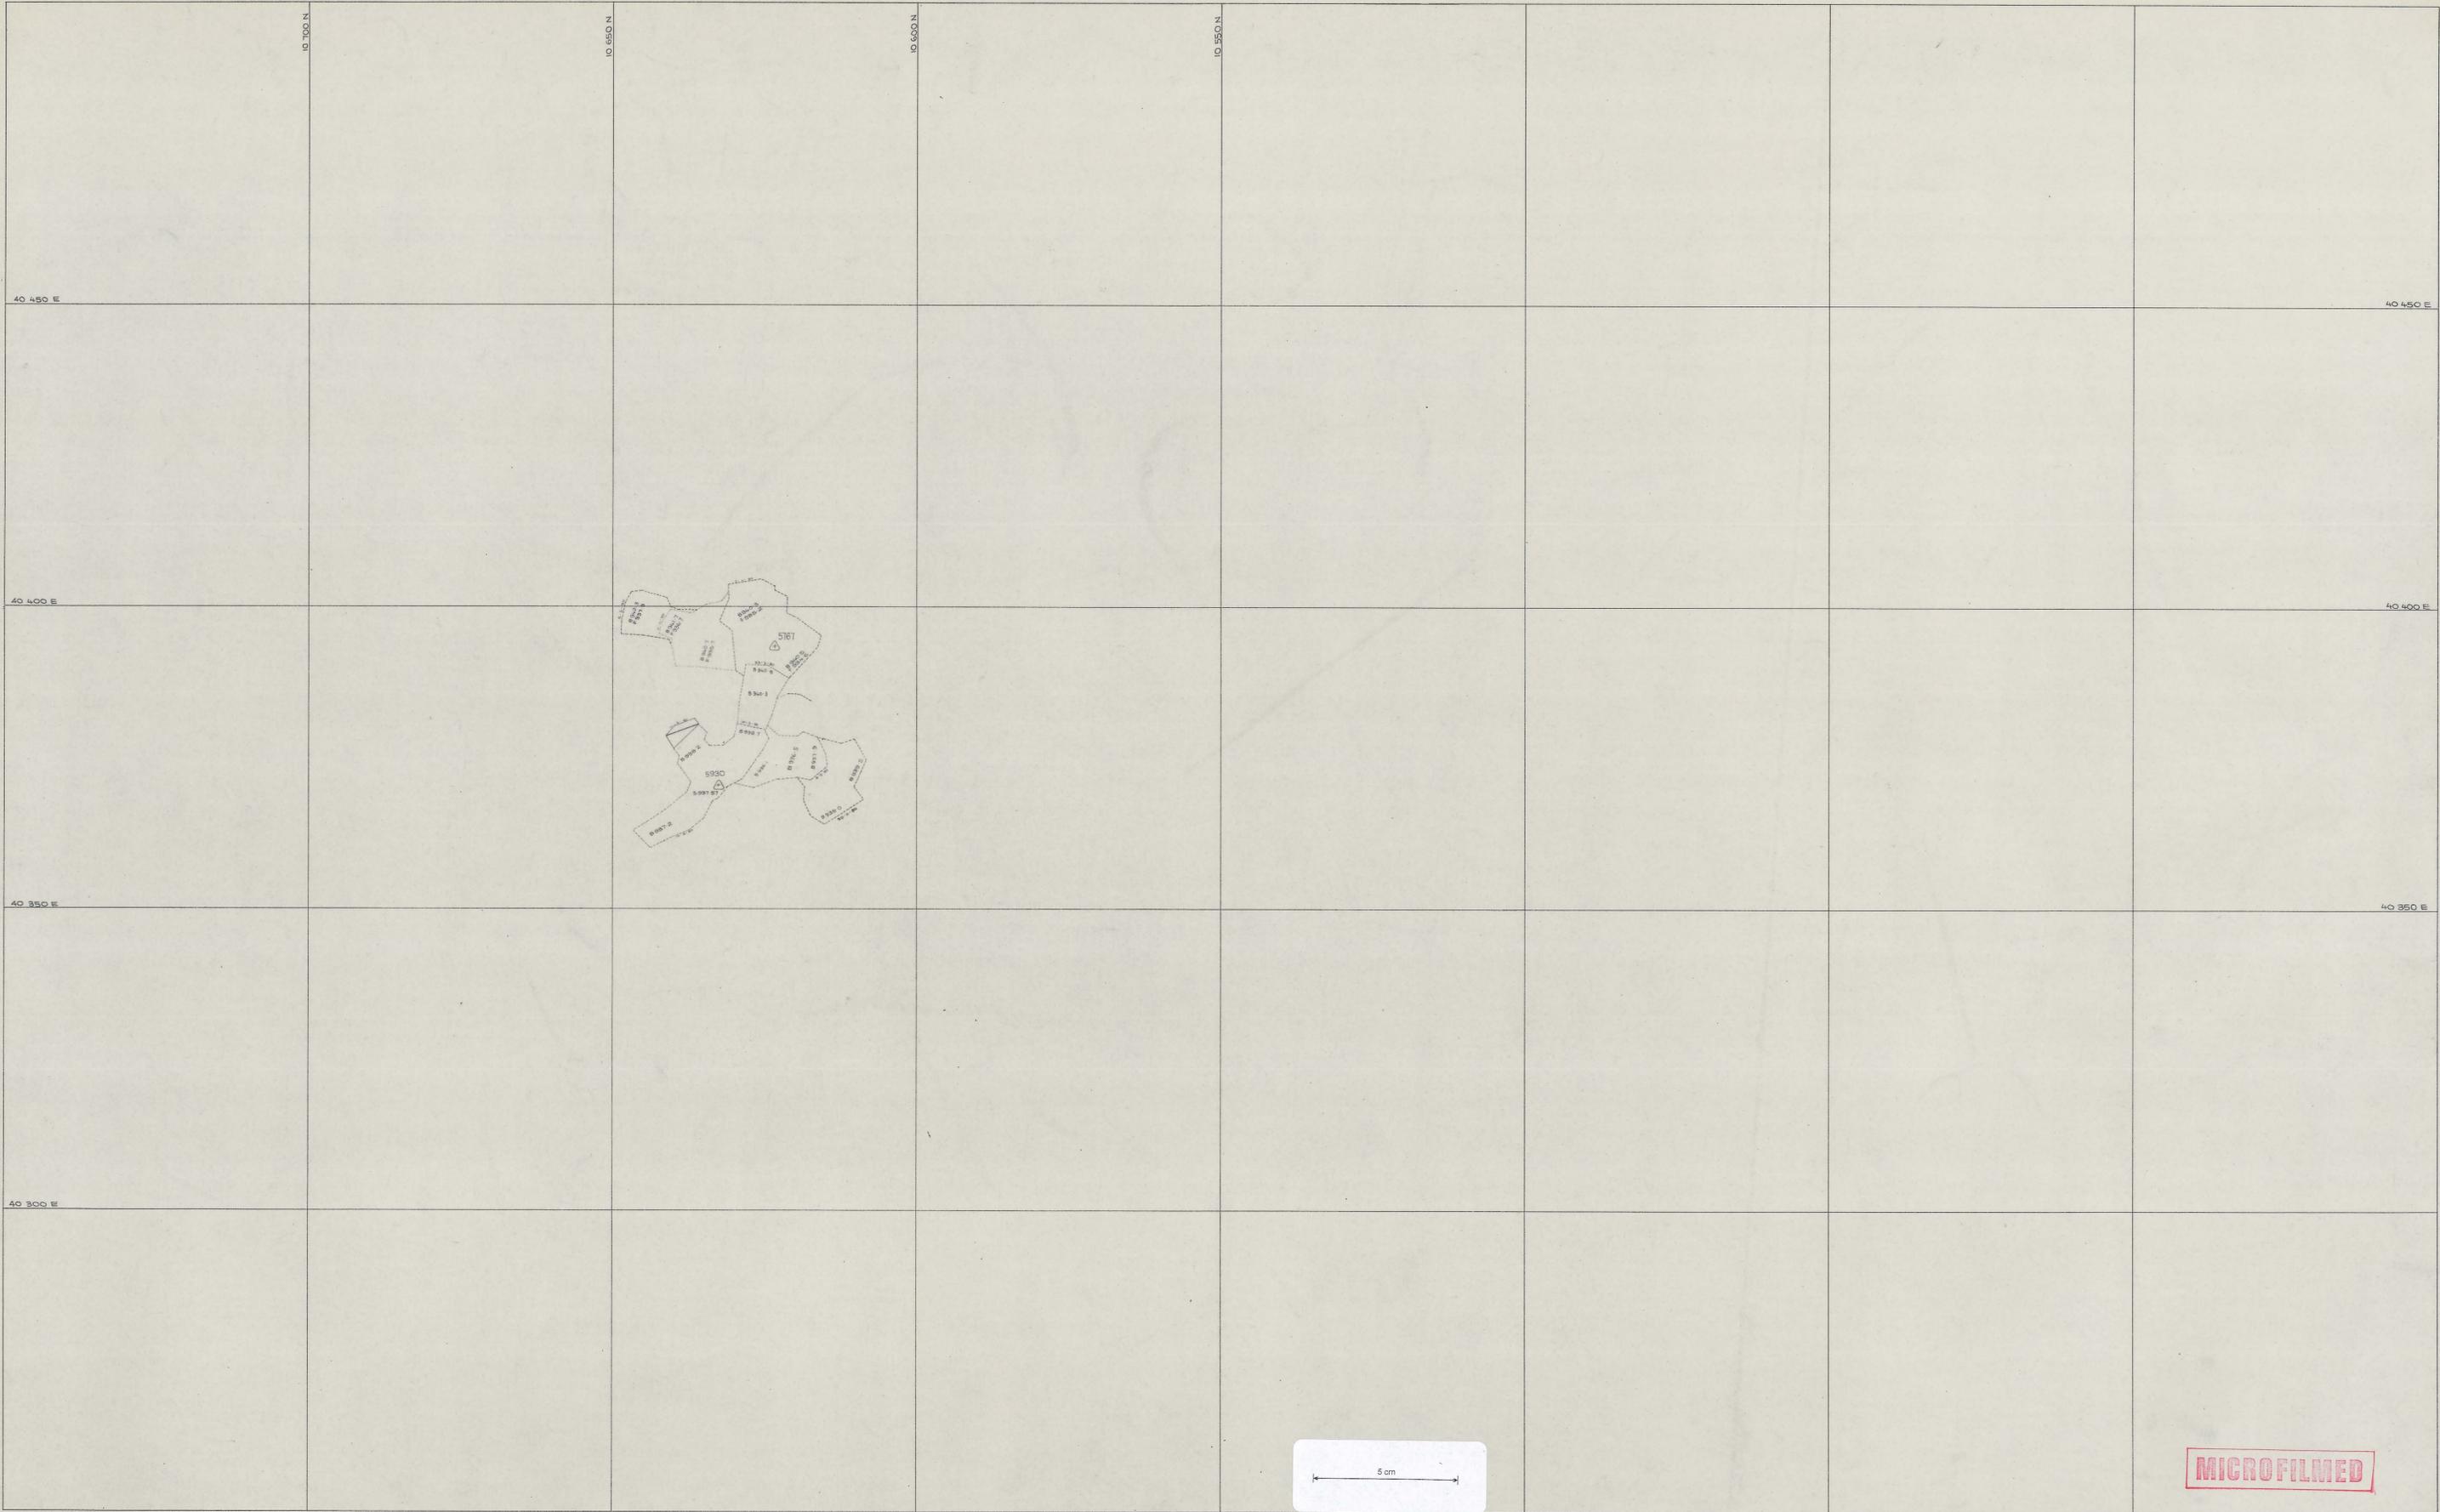

MICROFILMED

SCALE 1: 500

north

LOCATION BOLD HEAD MINE

SUBJECT R 60 - 4th lift

KIS KING ISLAND SCHEELITE
 A DIVISION OF WARMAN INTERNATIONAL
 GRASSY KING ISLAND

PLAN NUMBER 04BH15 - 1061

81092