
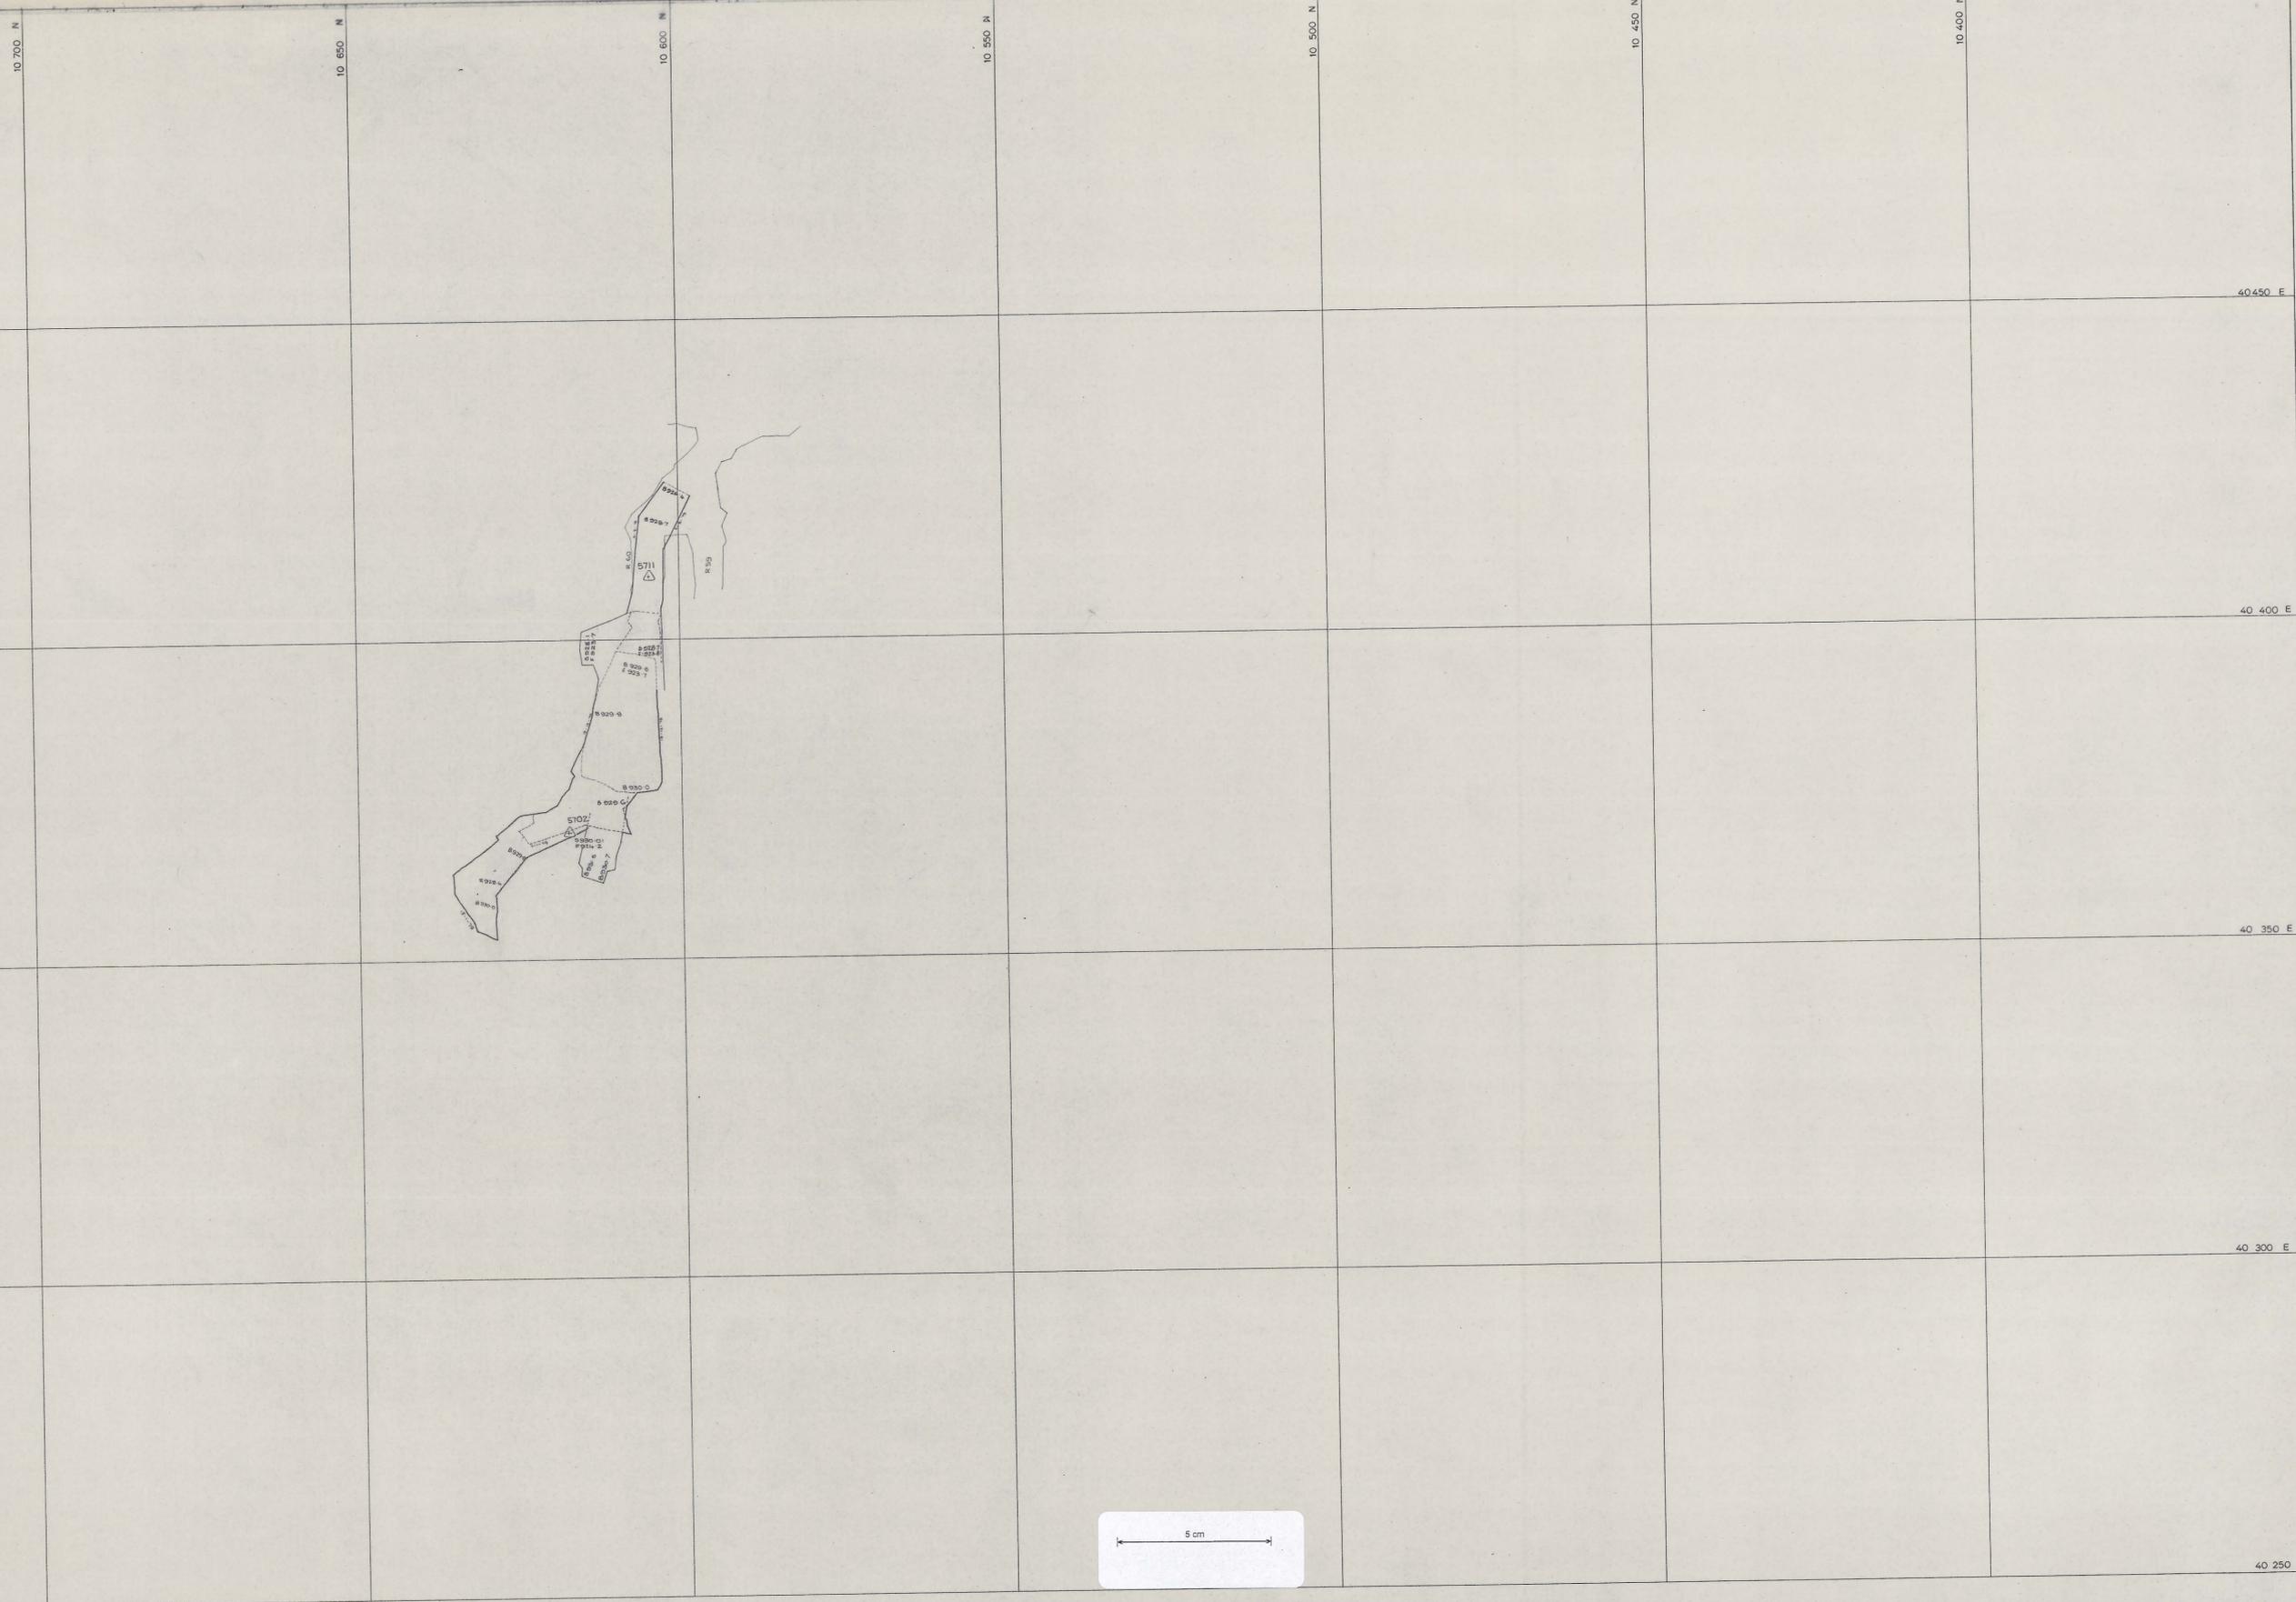
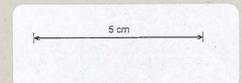


0374_556

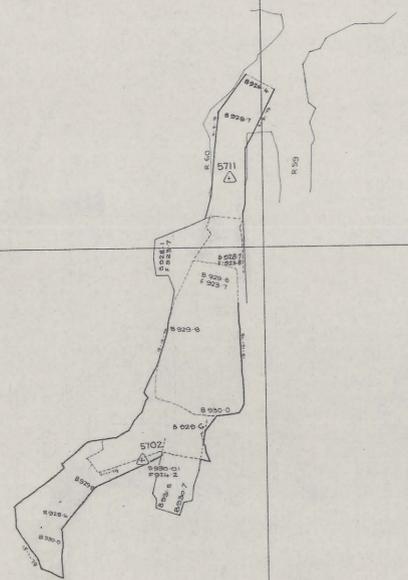

SCALE 1: 500

north

LOCATION
BOLD HEAD MINE

SUBJECT
C LENS OREBODY
R60 1st lift

KIS KING ISLAND SCHEELITE
A DIVISION OF WARMAN INTERNATIONAL

GRASSY KING ISLAND

PLAN NUMBER 04BH15 - 1064 81095