
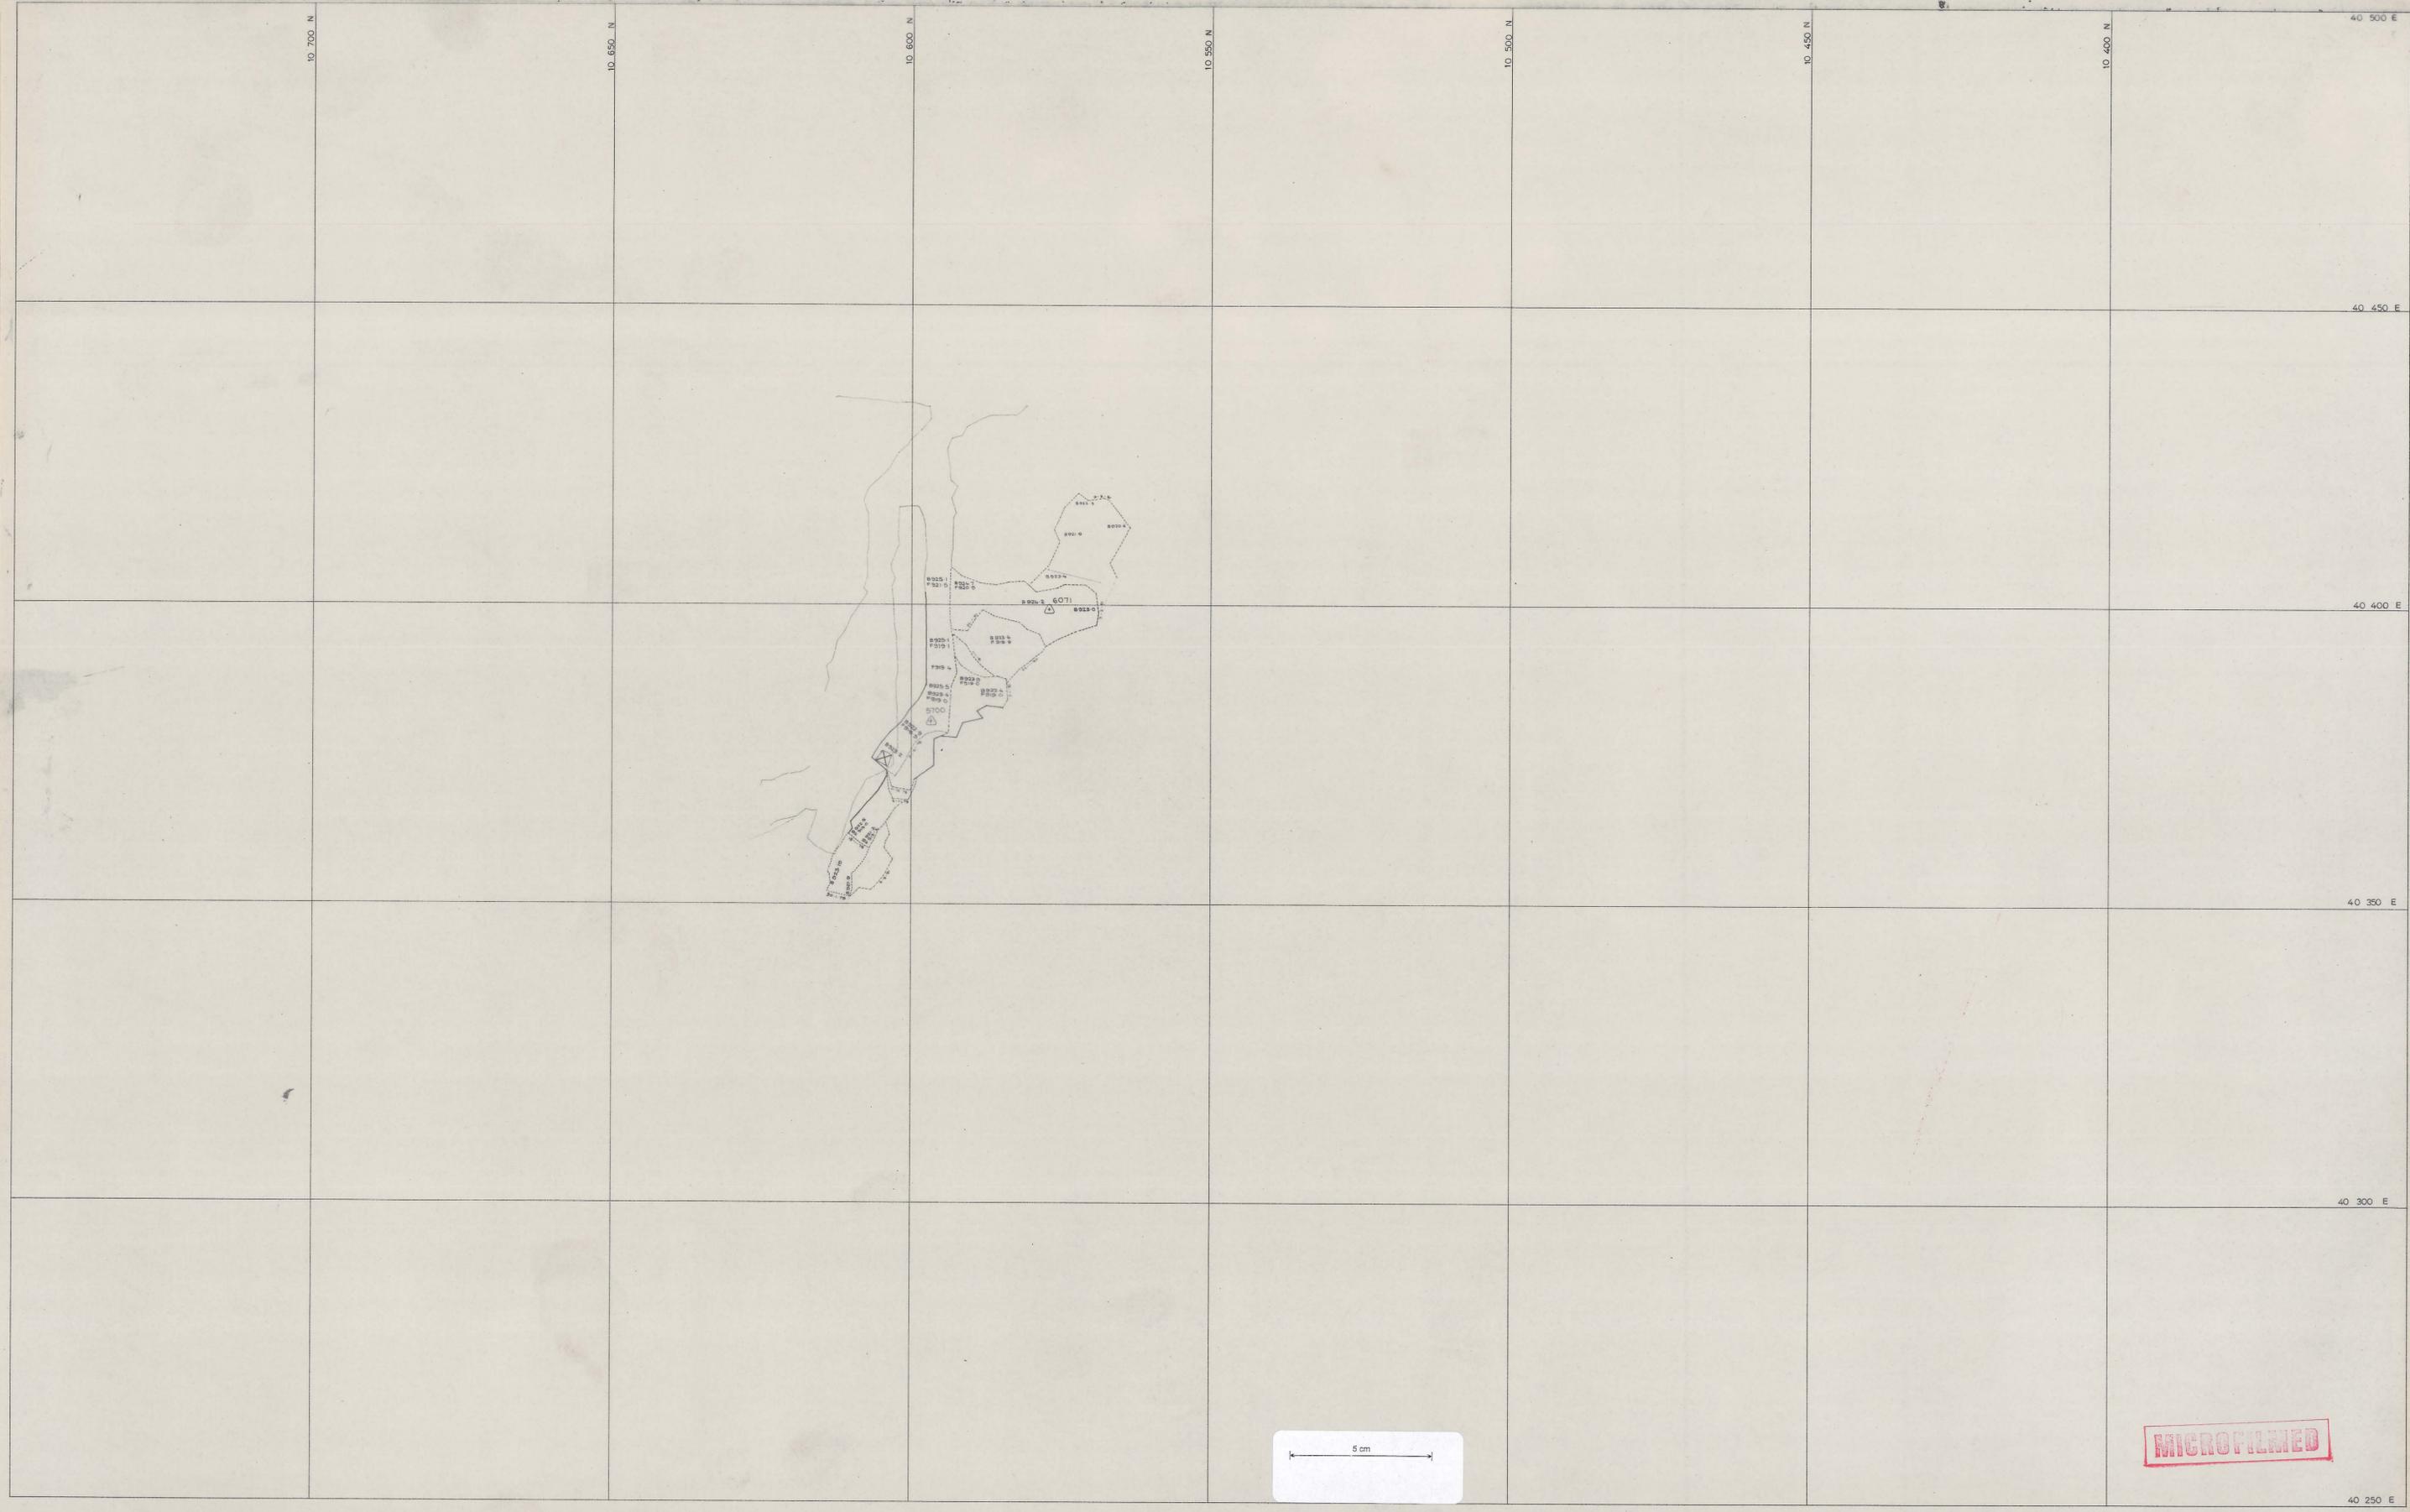


0374_557

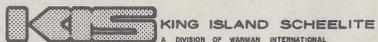

5 cm

MICROFILMED

SCALE 1: 500	LOCATION	BOLD HEAD MINE	
north	SUBJECT	C ₂ LENS OREBODY R59 BENCHING	