


0374\_560

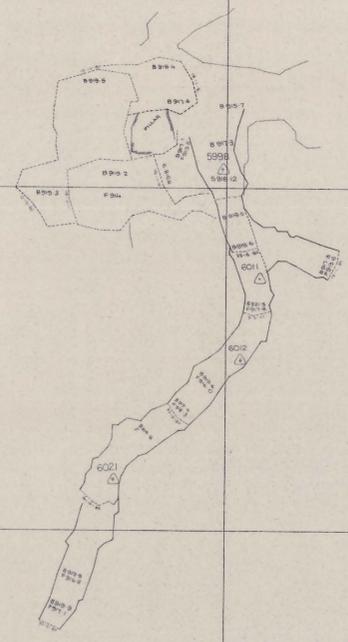

5 cm

**MICROFILMED**

SCALE 1:500	LOCATION BOLD HEAD MINE	
north	SUBJECT P55 SUB LEVEL	
		PLAN NUMBER 04BH15 - 1073