
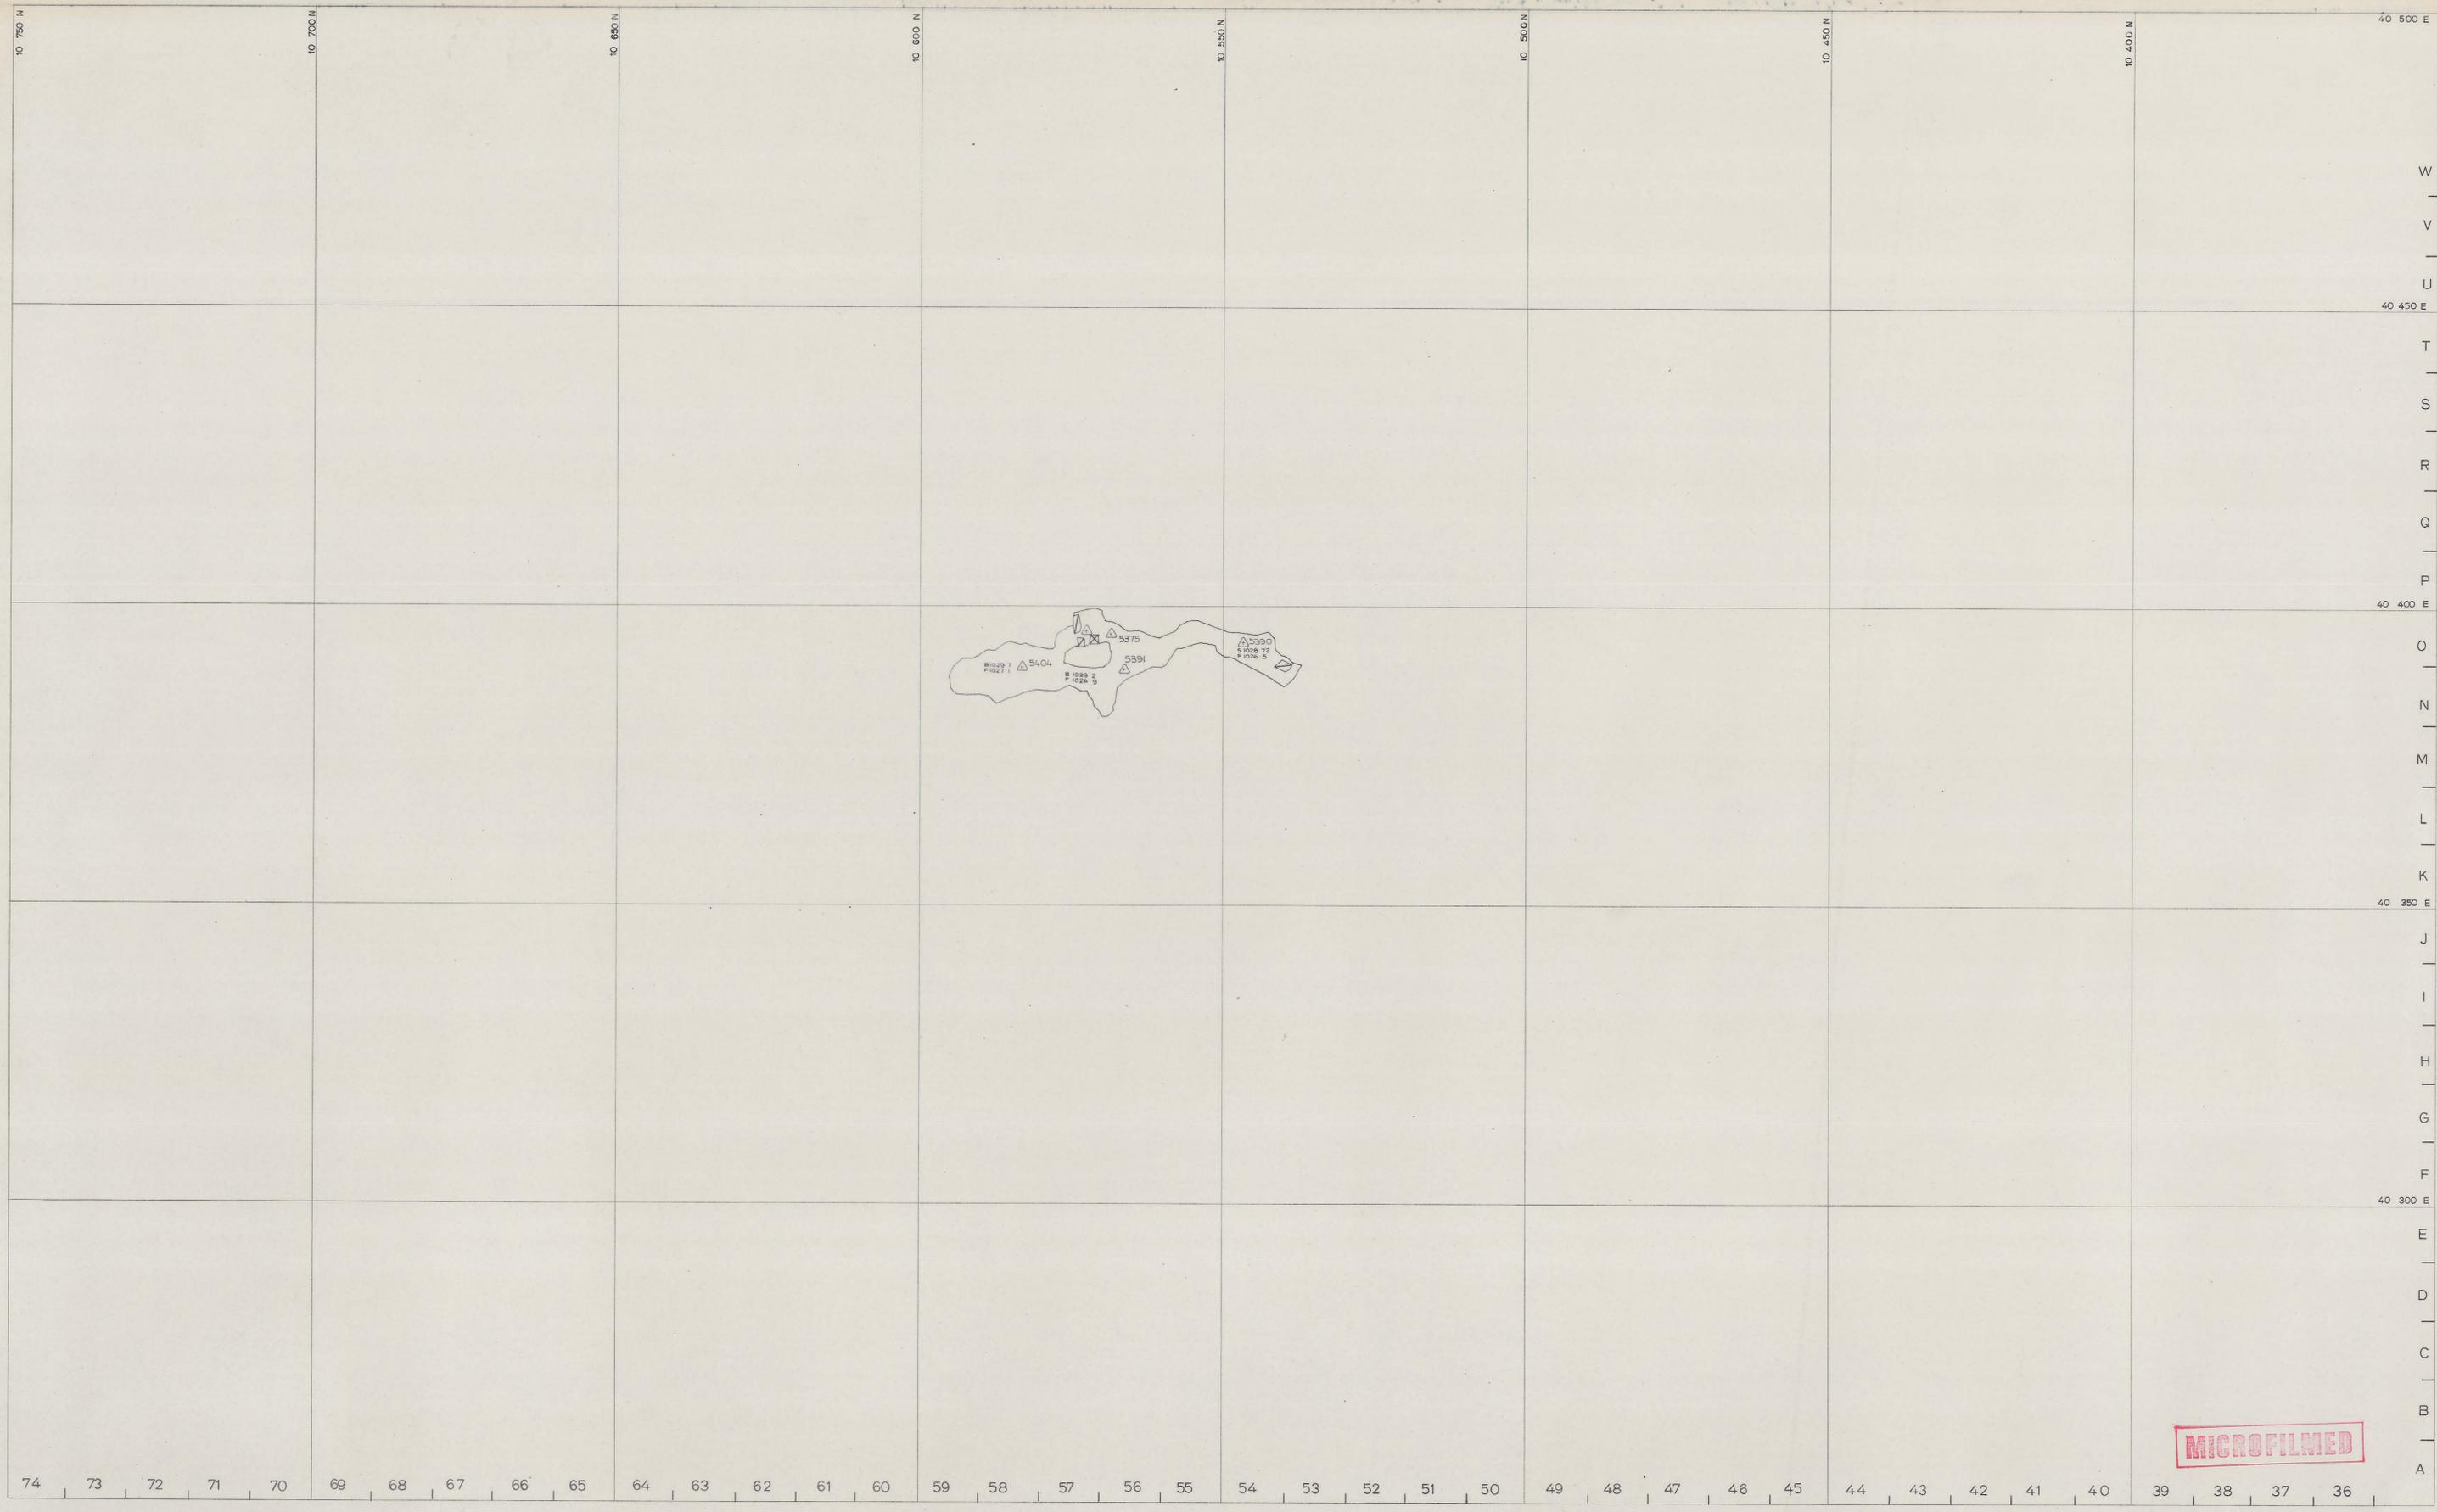


0374_562

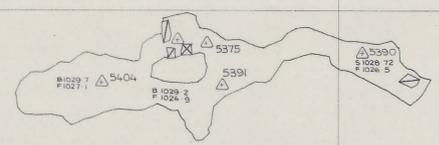

MICROFILMED

	SCALE 1:500 5 cm	north	LOCATION BOLD HEAD MINE	 KING ISLAND SCHEELITE <small>A DIVISION OF WARMAN INTERNATIONAL</small>
			SUBJECT P 57 STOPE [Undercut]	