
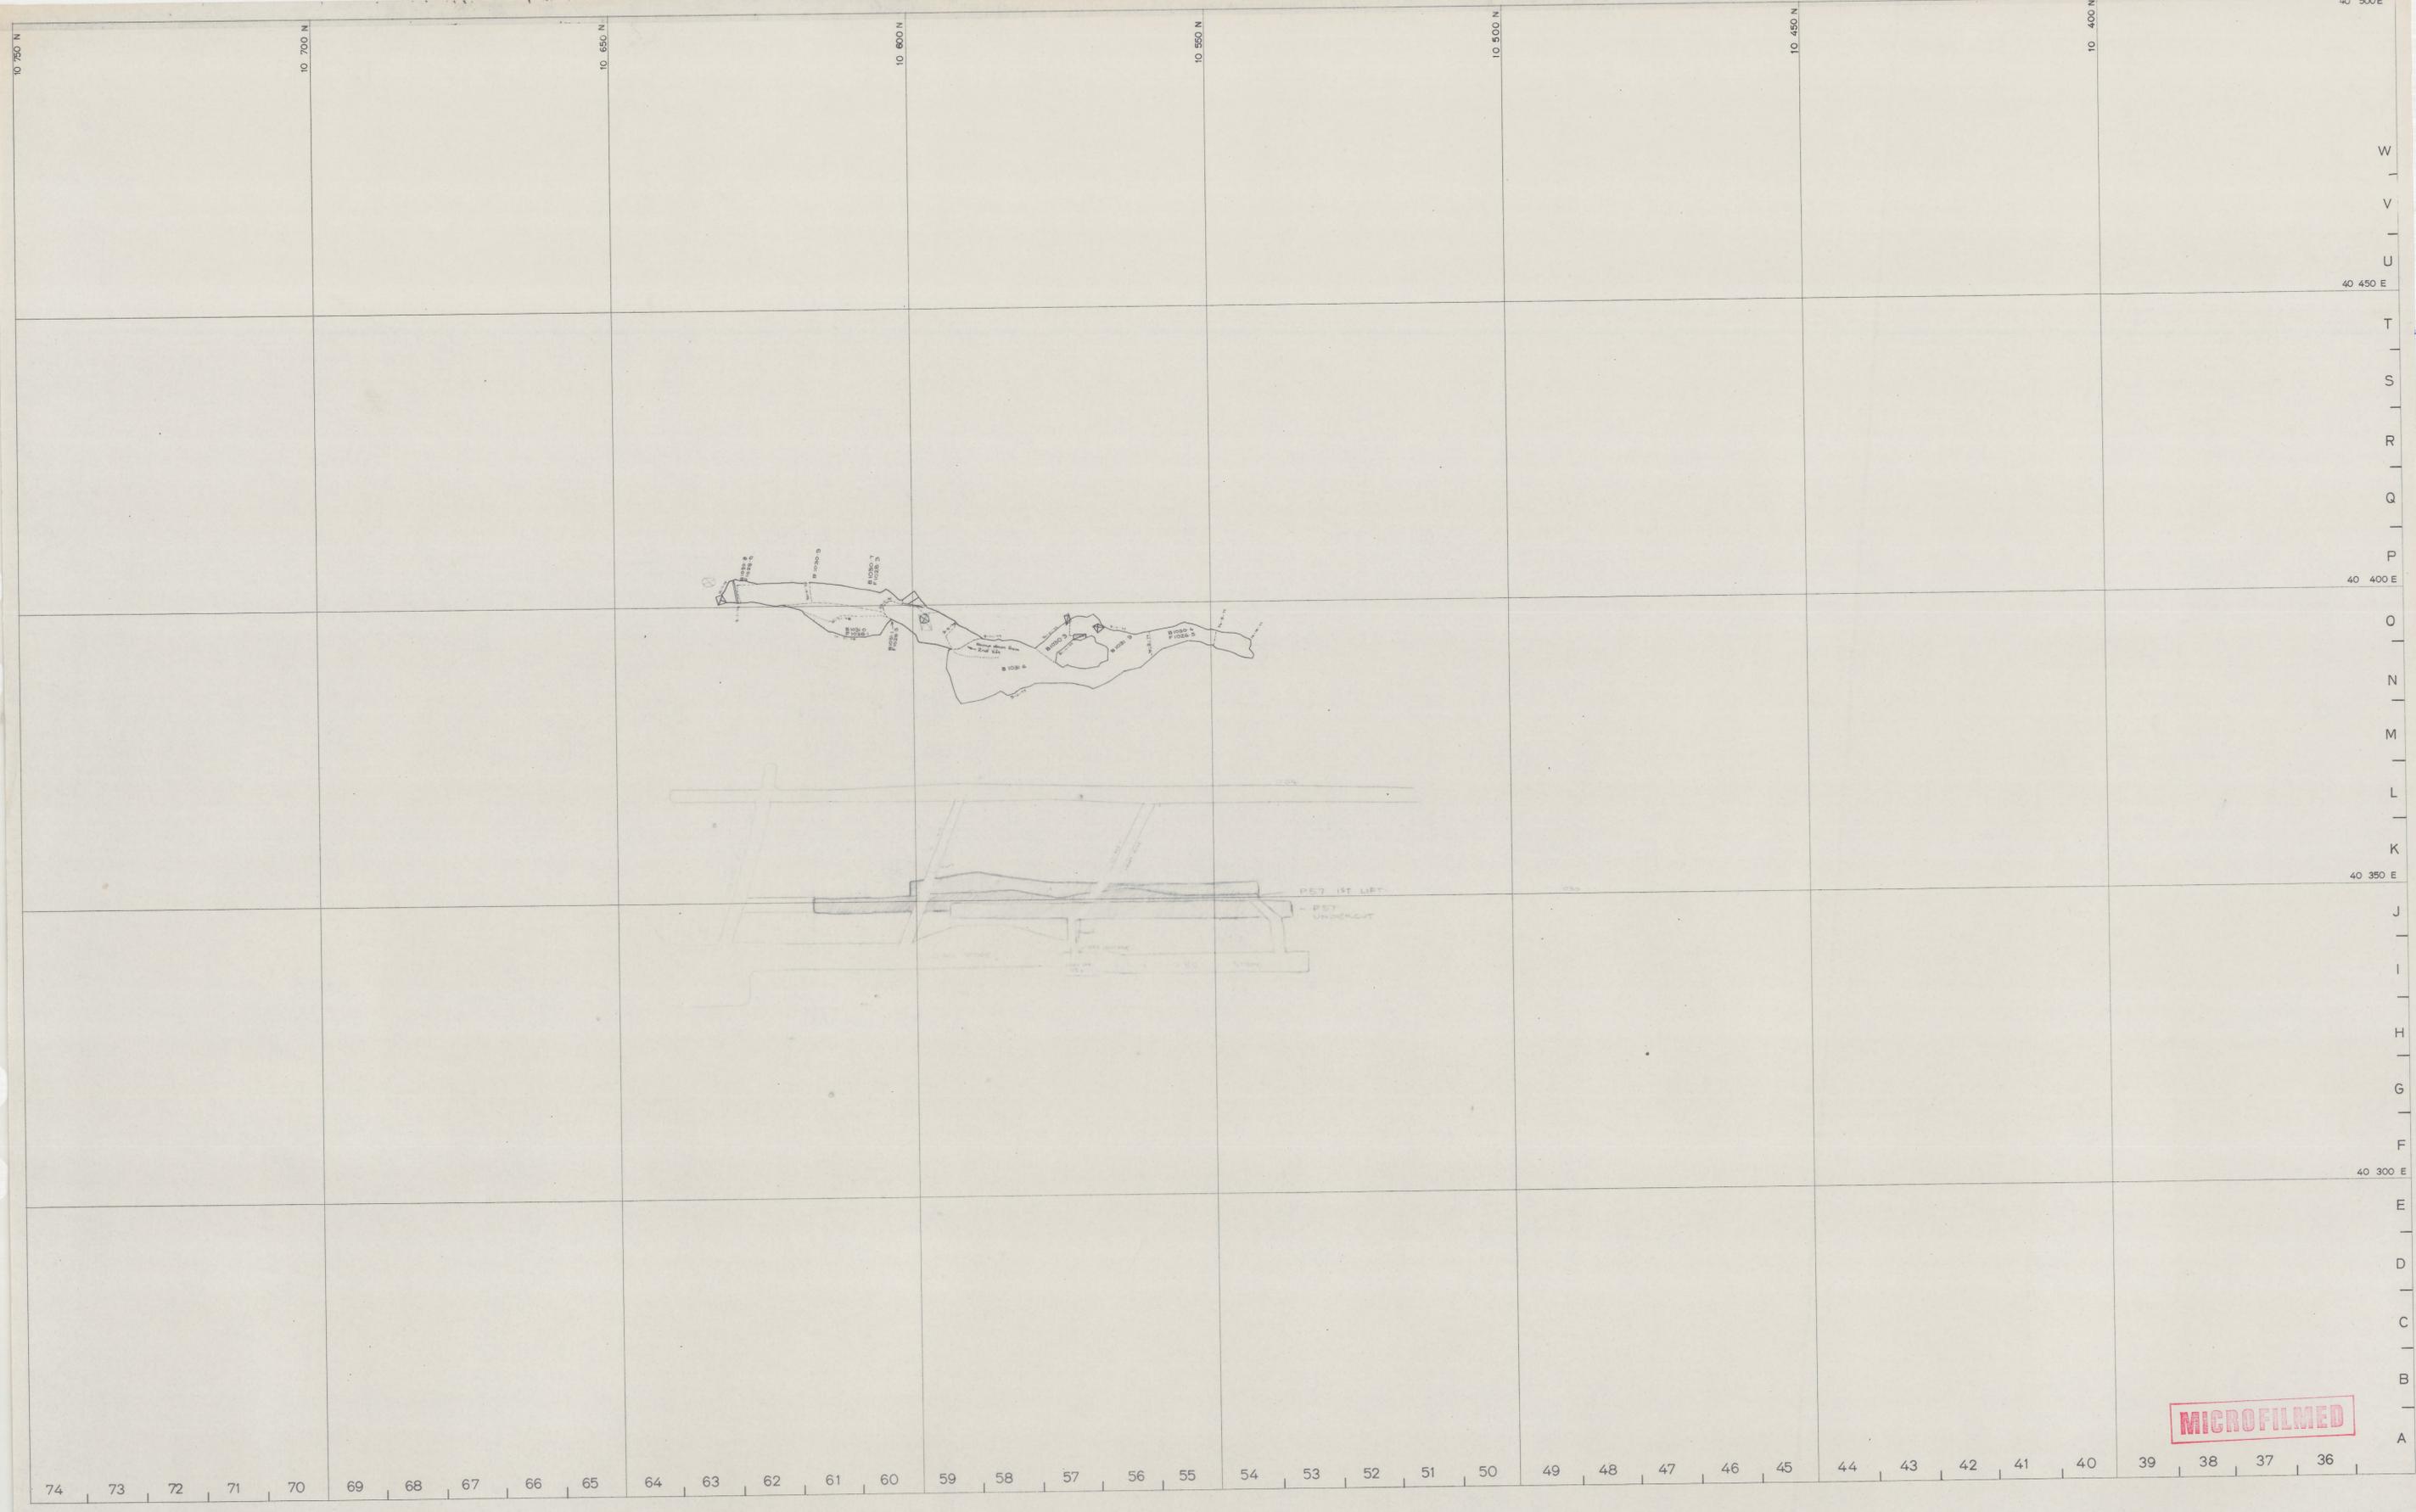


0374_563

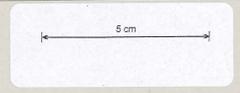

MICROFILMED

74 73 72 71 70 69 68 67 66 65 64 63 62 61 60 59 58 57 56 55 54 53 52 51 50 49 48 47 46 45 44 43 42 41 40 39 38 37 36

<p>SCALE 1:500</p> 	<p>LOCATION BOLD HEAD MINE</p>	<p>SUBJECT P 57 STOPE [1st Lift]</p>	<p>LOCATION GRASSY KING ISLAND</p>

north

81079