



0374_566

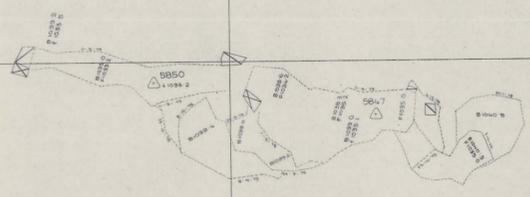

MICROFILMED

SCALE 1:500

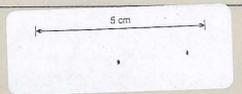

north

LOCATION	BOLD HEAD MINE
SUBJECT	P57 STOPE [4th Lift]

KIS KING ISLAND SCHEELITE
A DIVISION OF WARMAN INTERNATIONAL

GRASSY KING ISLAND

PLAN NUMBER 04BH15 - 1044 81082