


0374\_568



MICROFILMED

SCALE 1:500

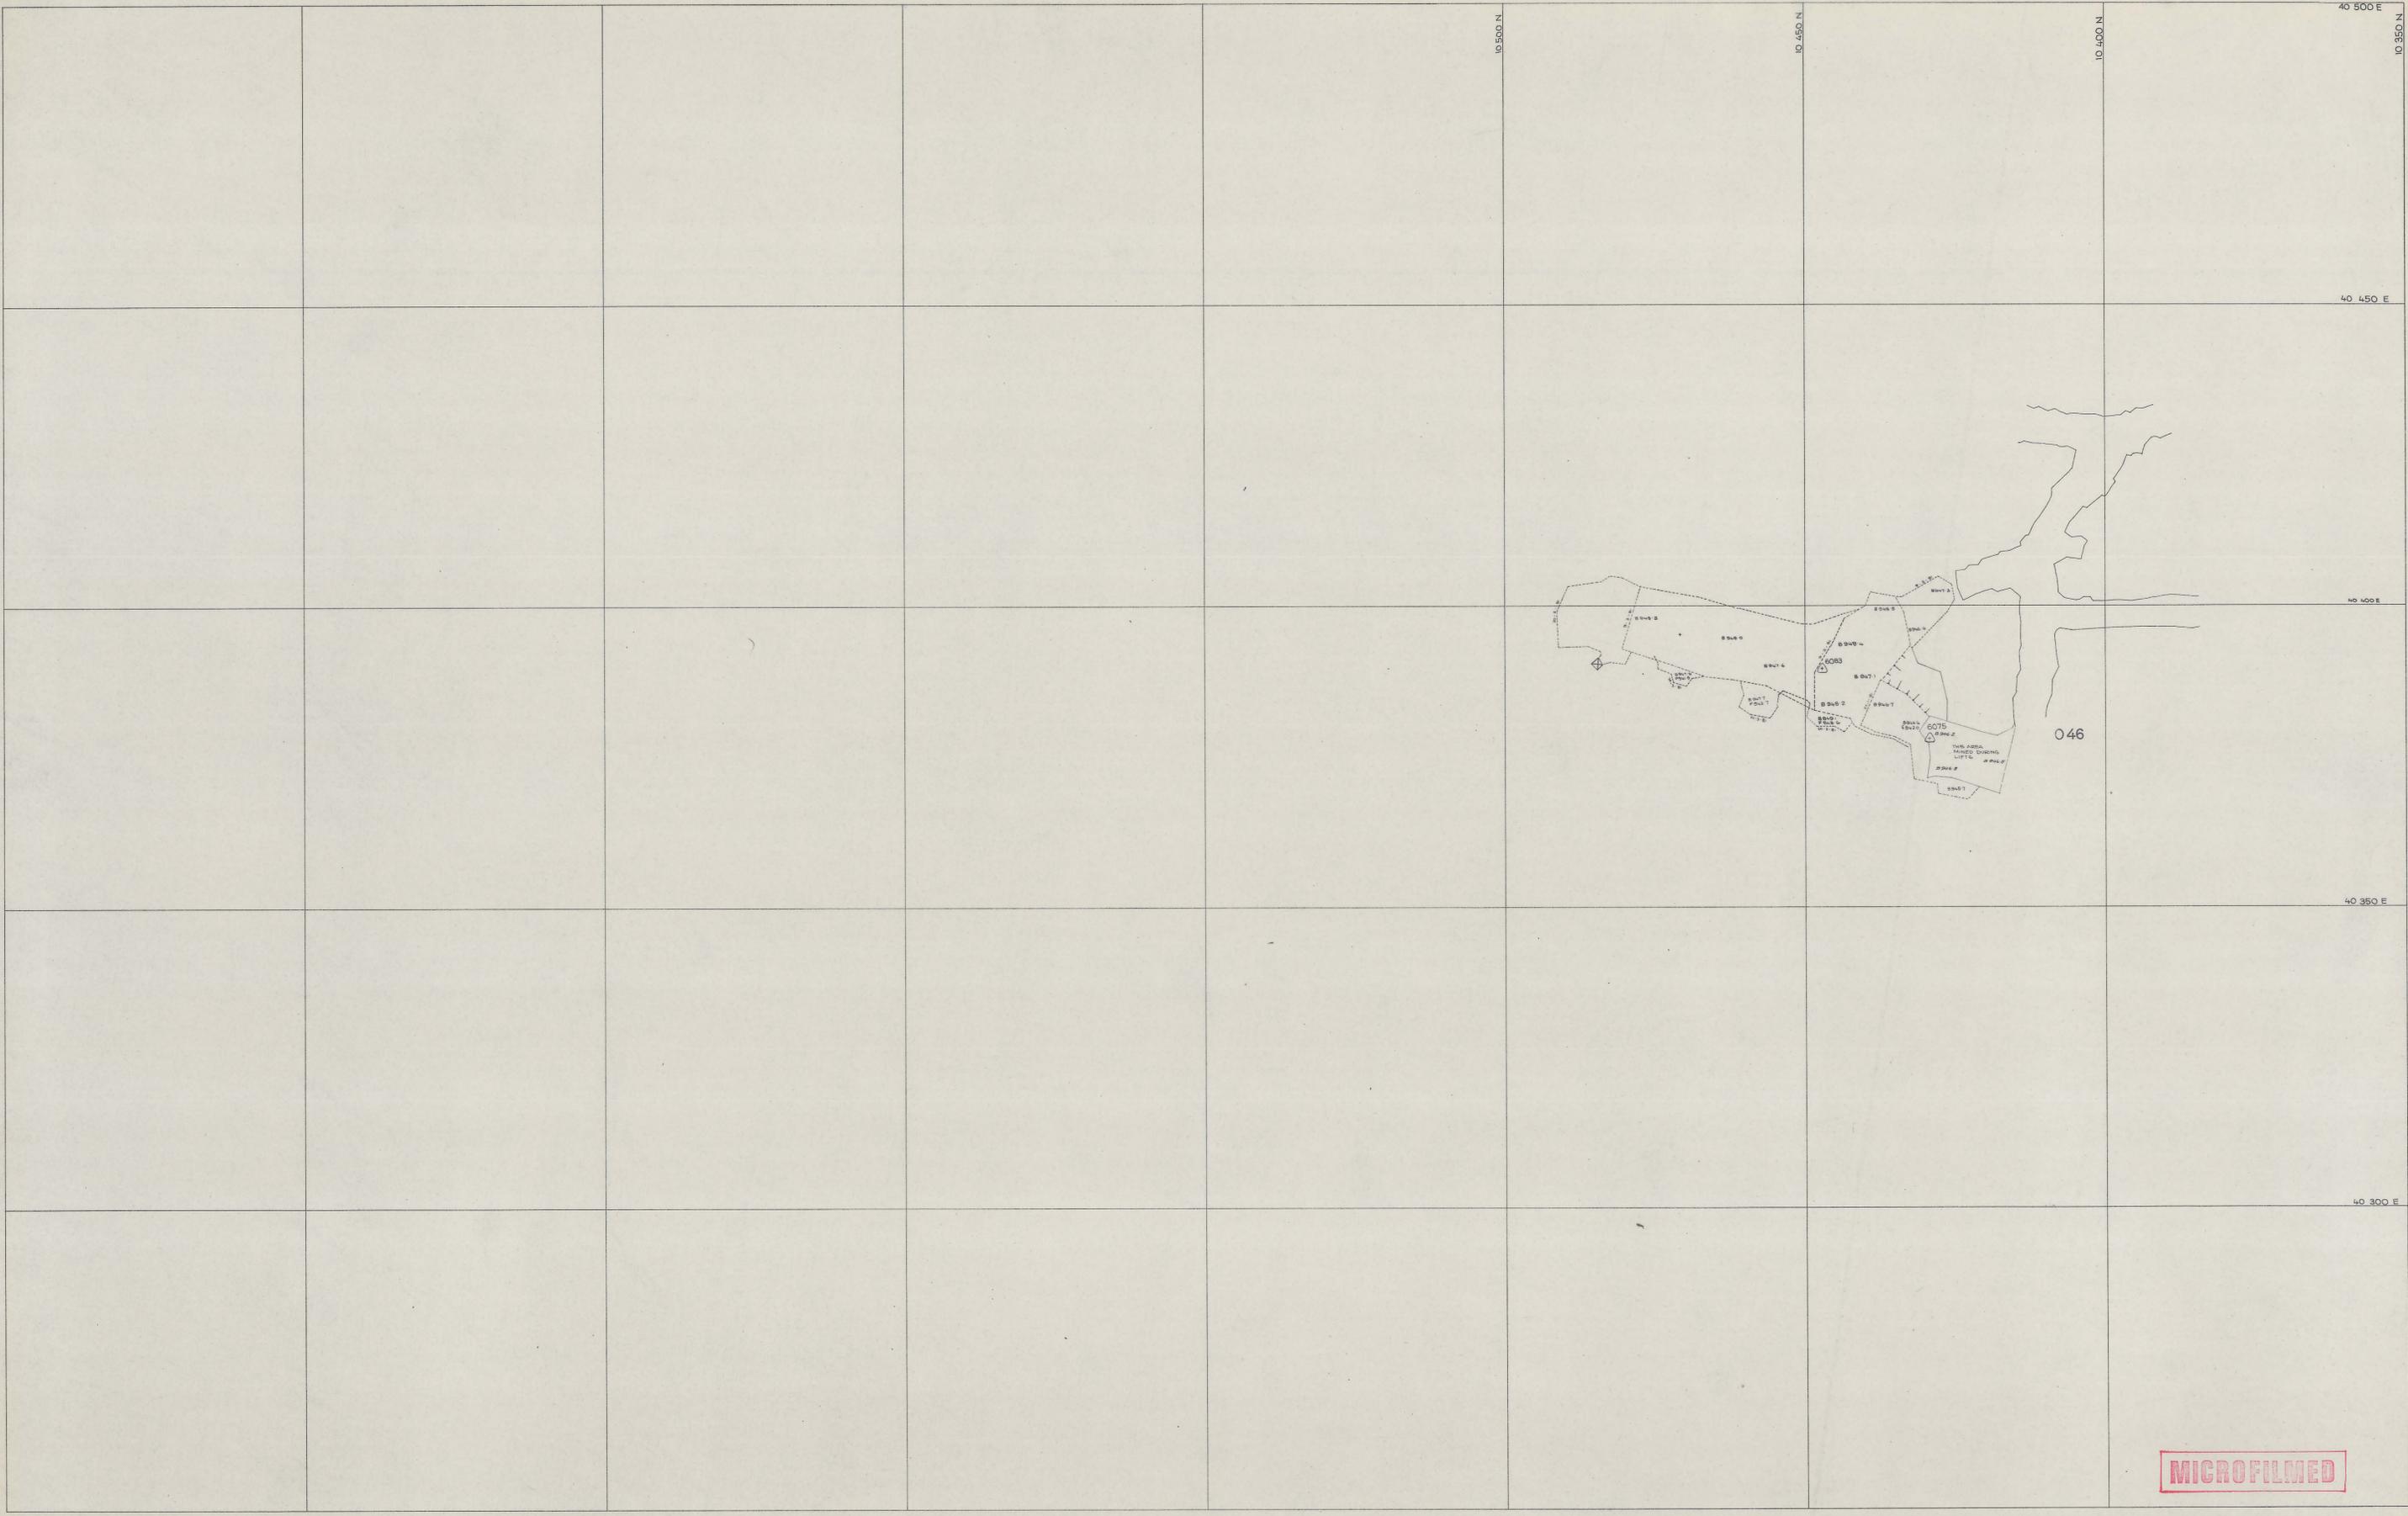

north

LOCATION  
BOLD HEAD MINE

SUBJECT  
037 & 043 STOPES  
7th lift

**KIS** KING ISLAND SCHEELITE  
A DIVISION OF WARMAN INTERNATIONAL

GRASSY KING ISLAND

PLAN NUMBER 04BH15 - 1052 81084