


0374\_570



MICROFILMED

SCALE 1:500

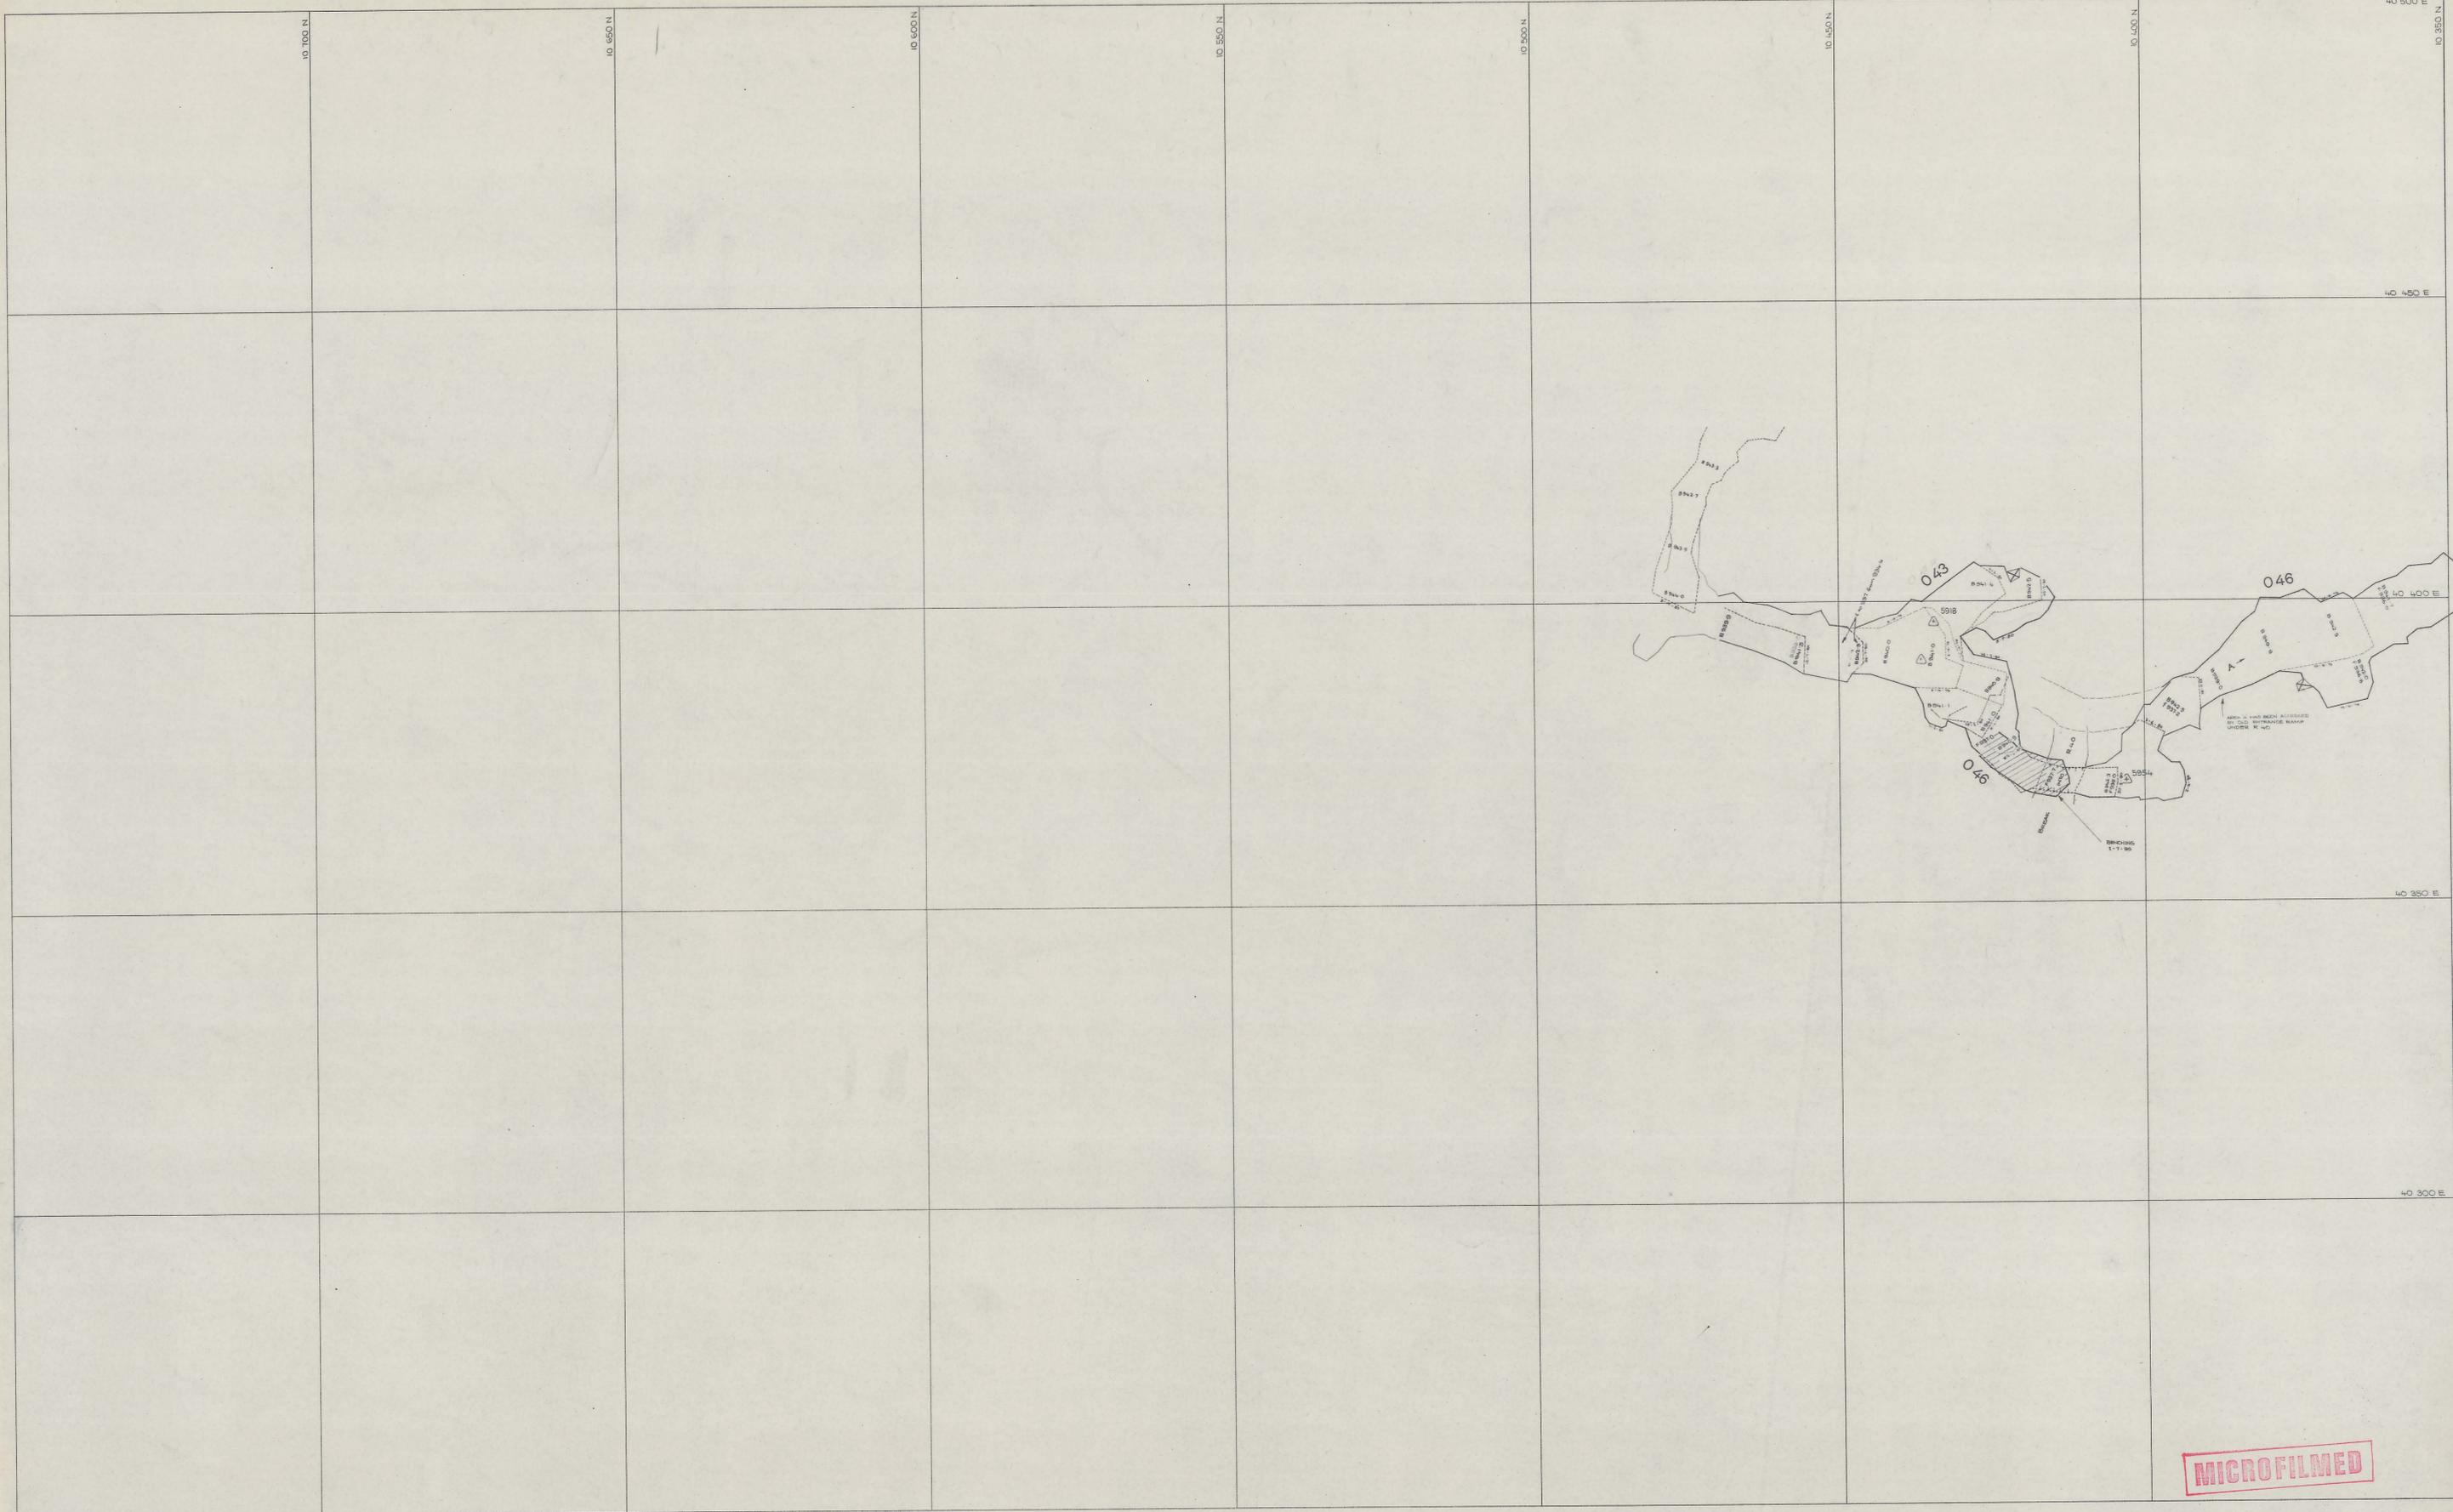

north

LOCATION BOLD HEAD MINE

SUBJECT 0 37 & 043 STOPES  
5th lift

**KIS** KING ISLAND SCHEELITE  
A DIVISION OF WARMAN INTERNATIONAL

GRASSY KING ISLAND

PLAN NUMBER 04BH15 - 1054 81086