



0374_571

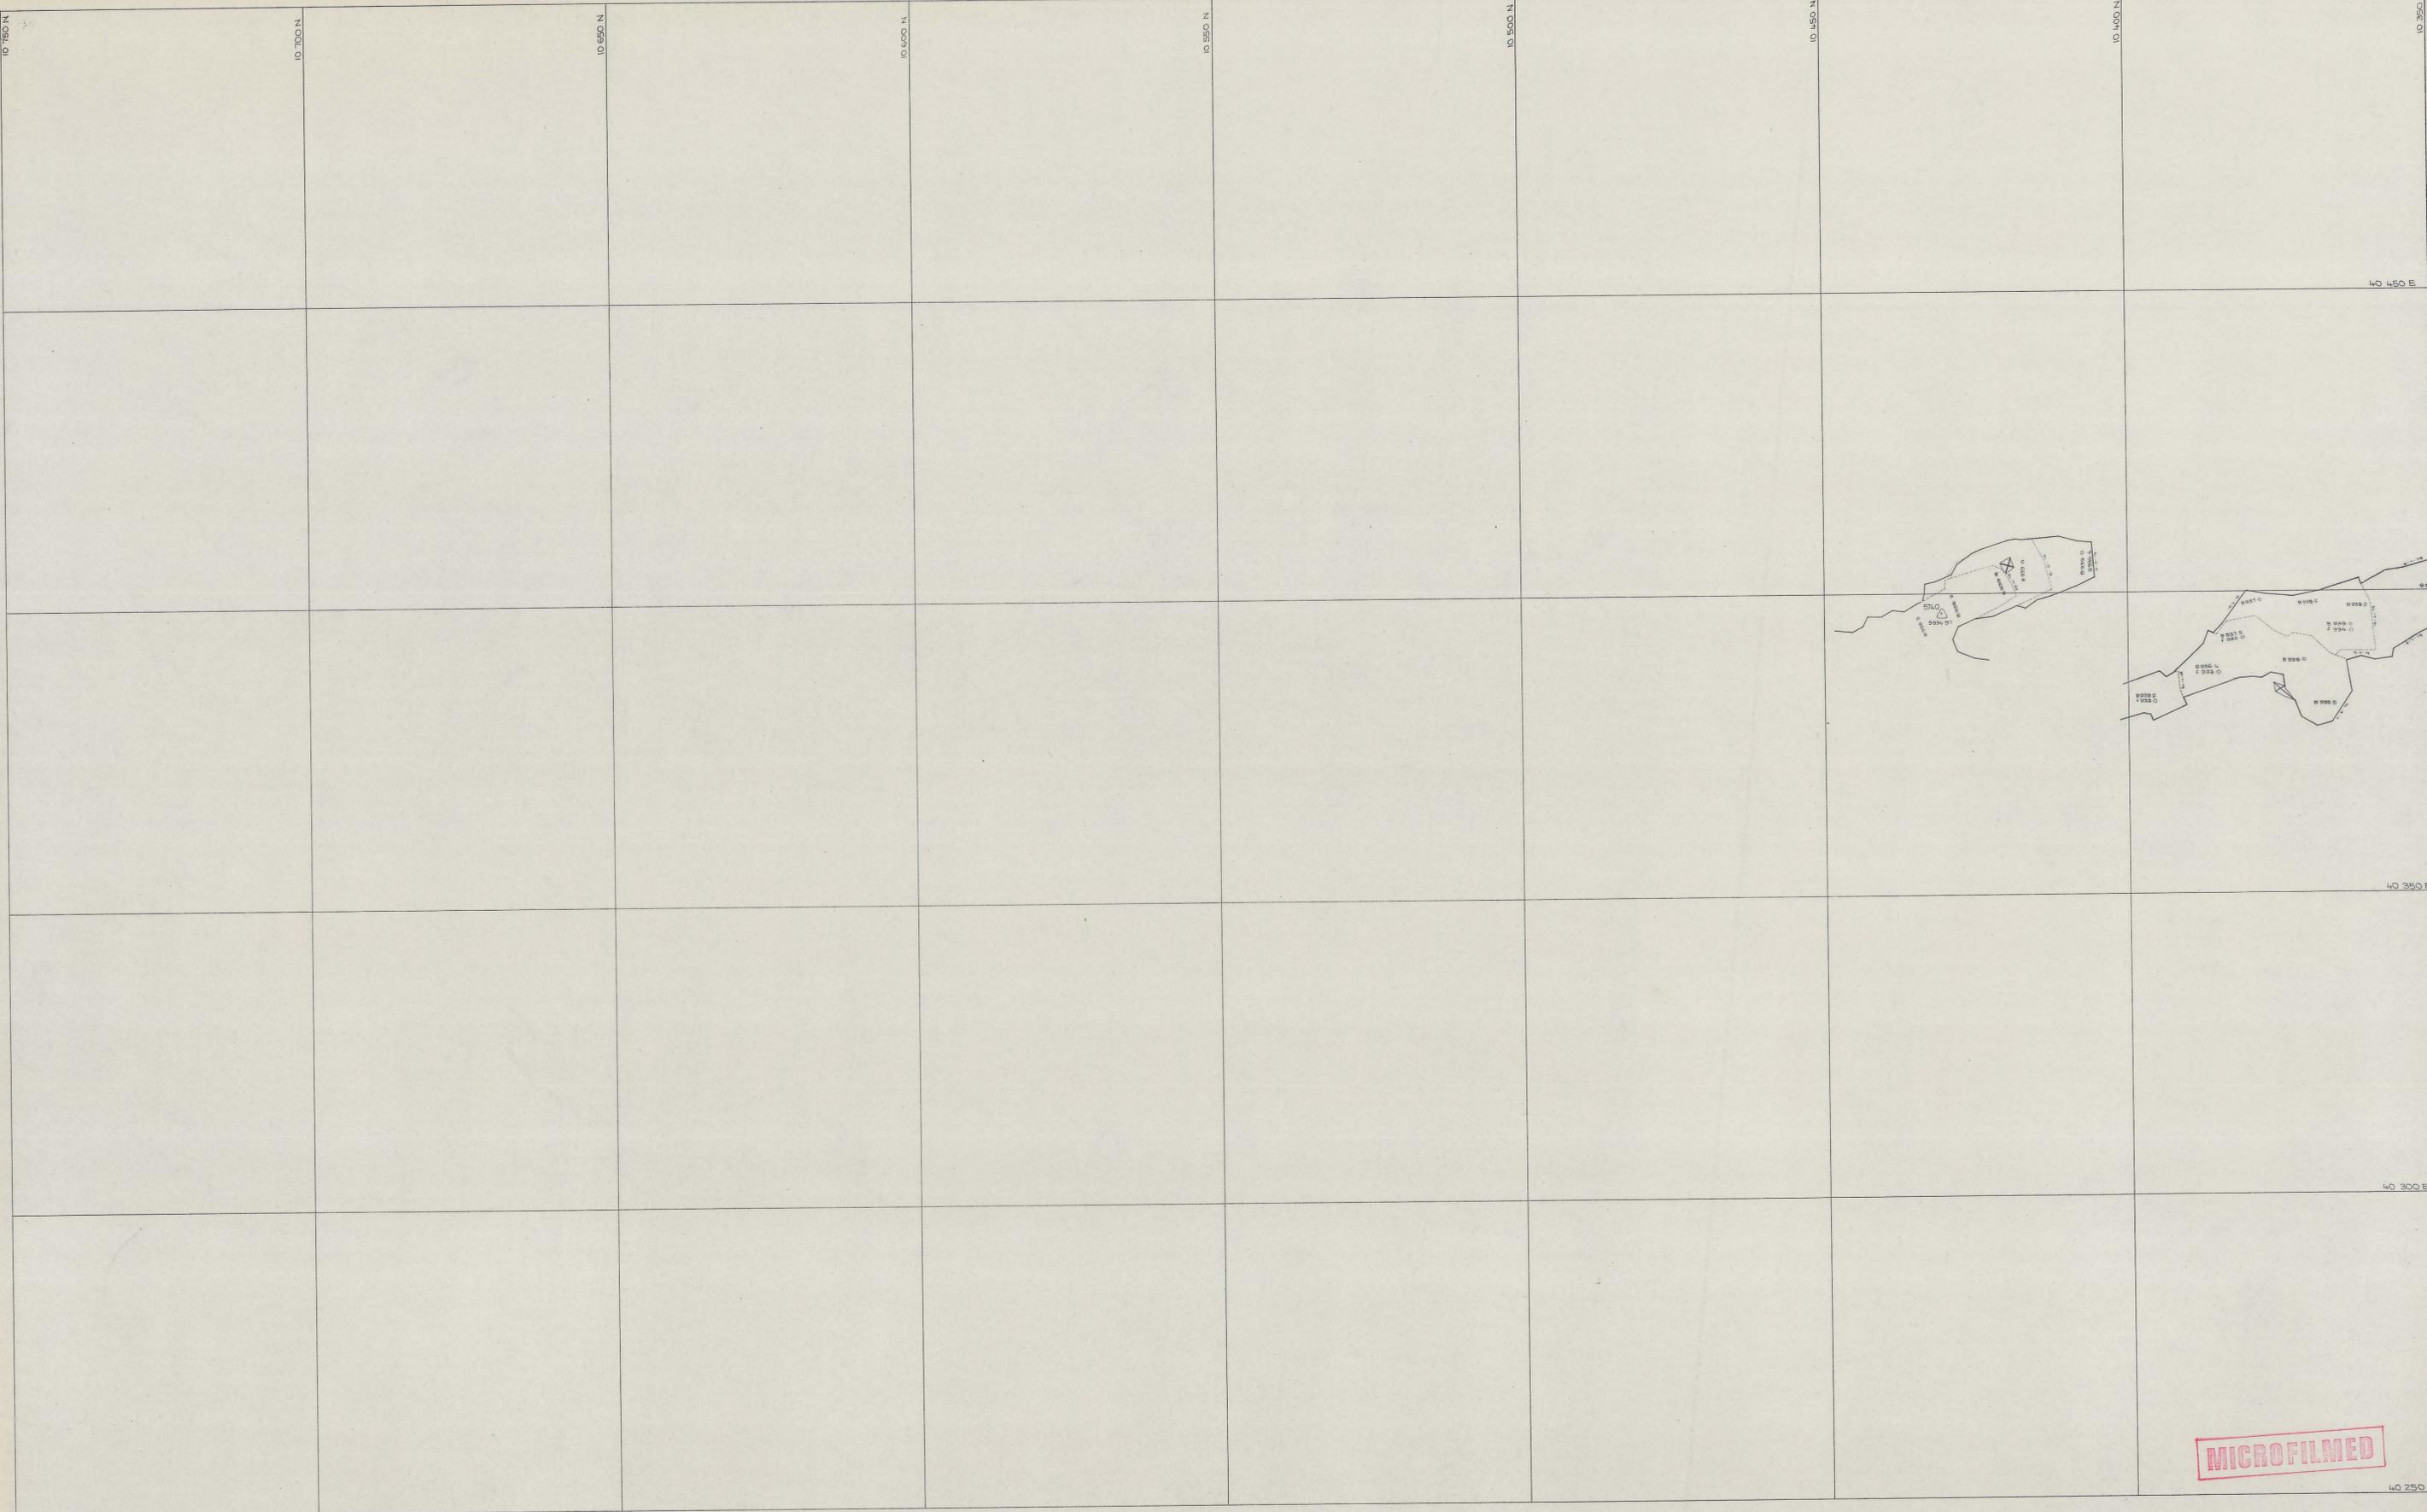

MICROFILMED

SCALE 1:500

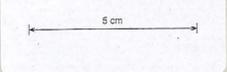

north

LOCATION BOLD HEAD MINE

SUBJECT
 043 & 037 STOPES
 4th lift

KIS KING ISLAND SCHEELITE
 A DIVISION OF WARMAN INTERNATIONAL

GRASSY KING ISLAND

PLAN NUMBER 04BH15 - 1055 8/057