



0374\_572

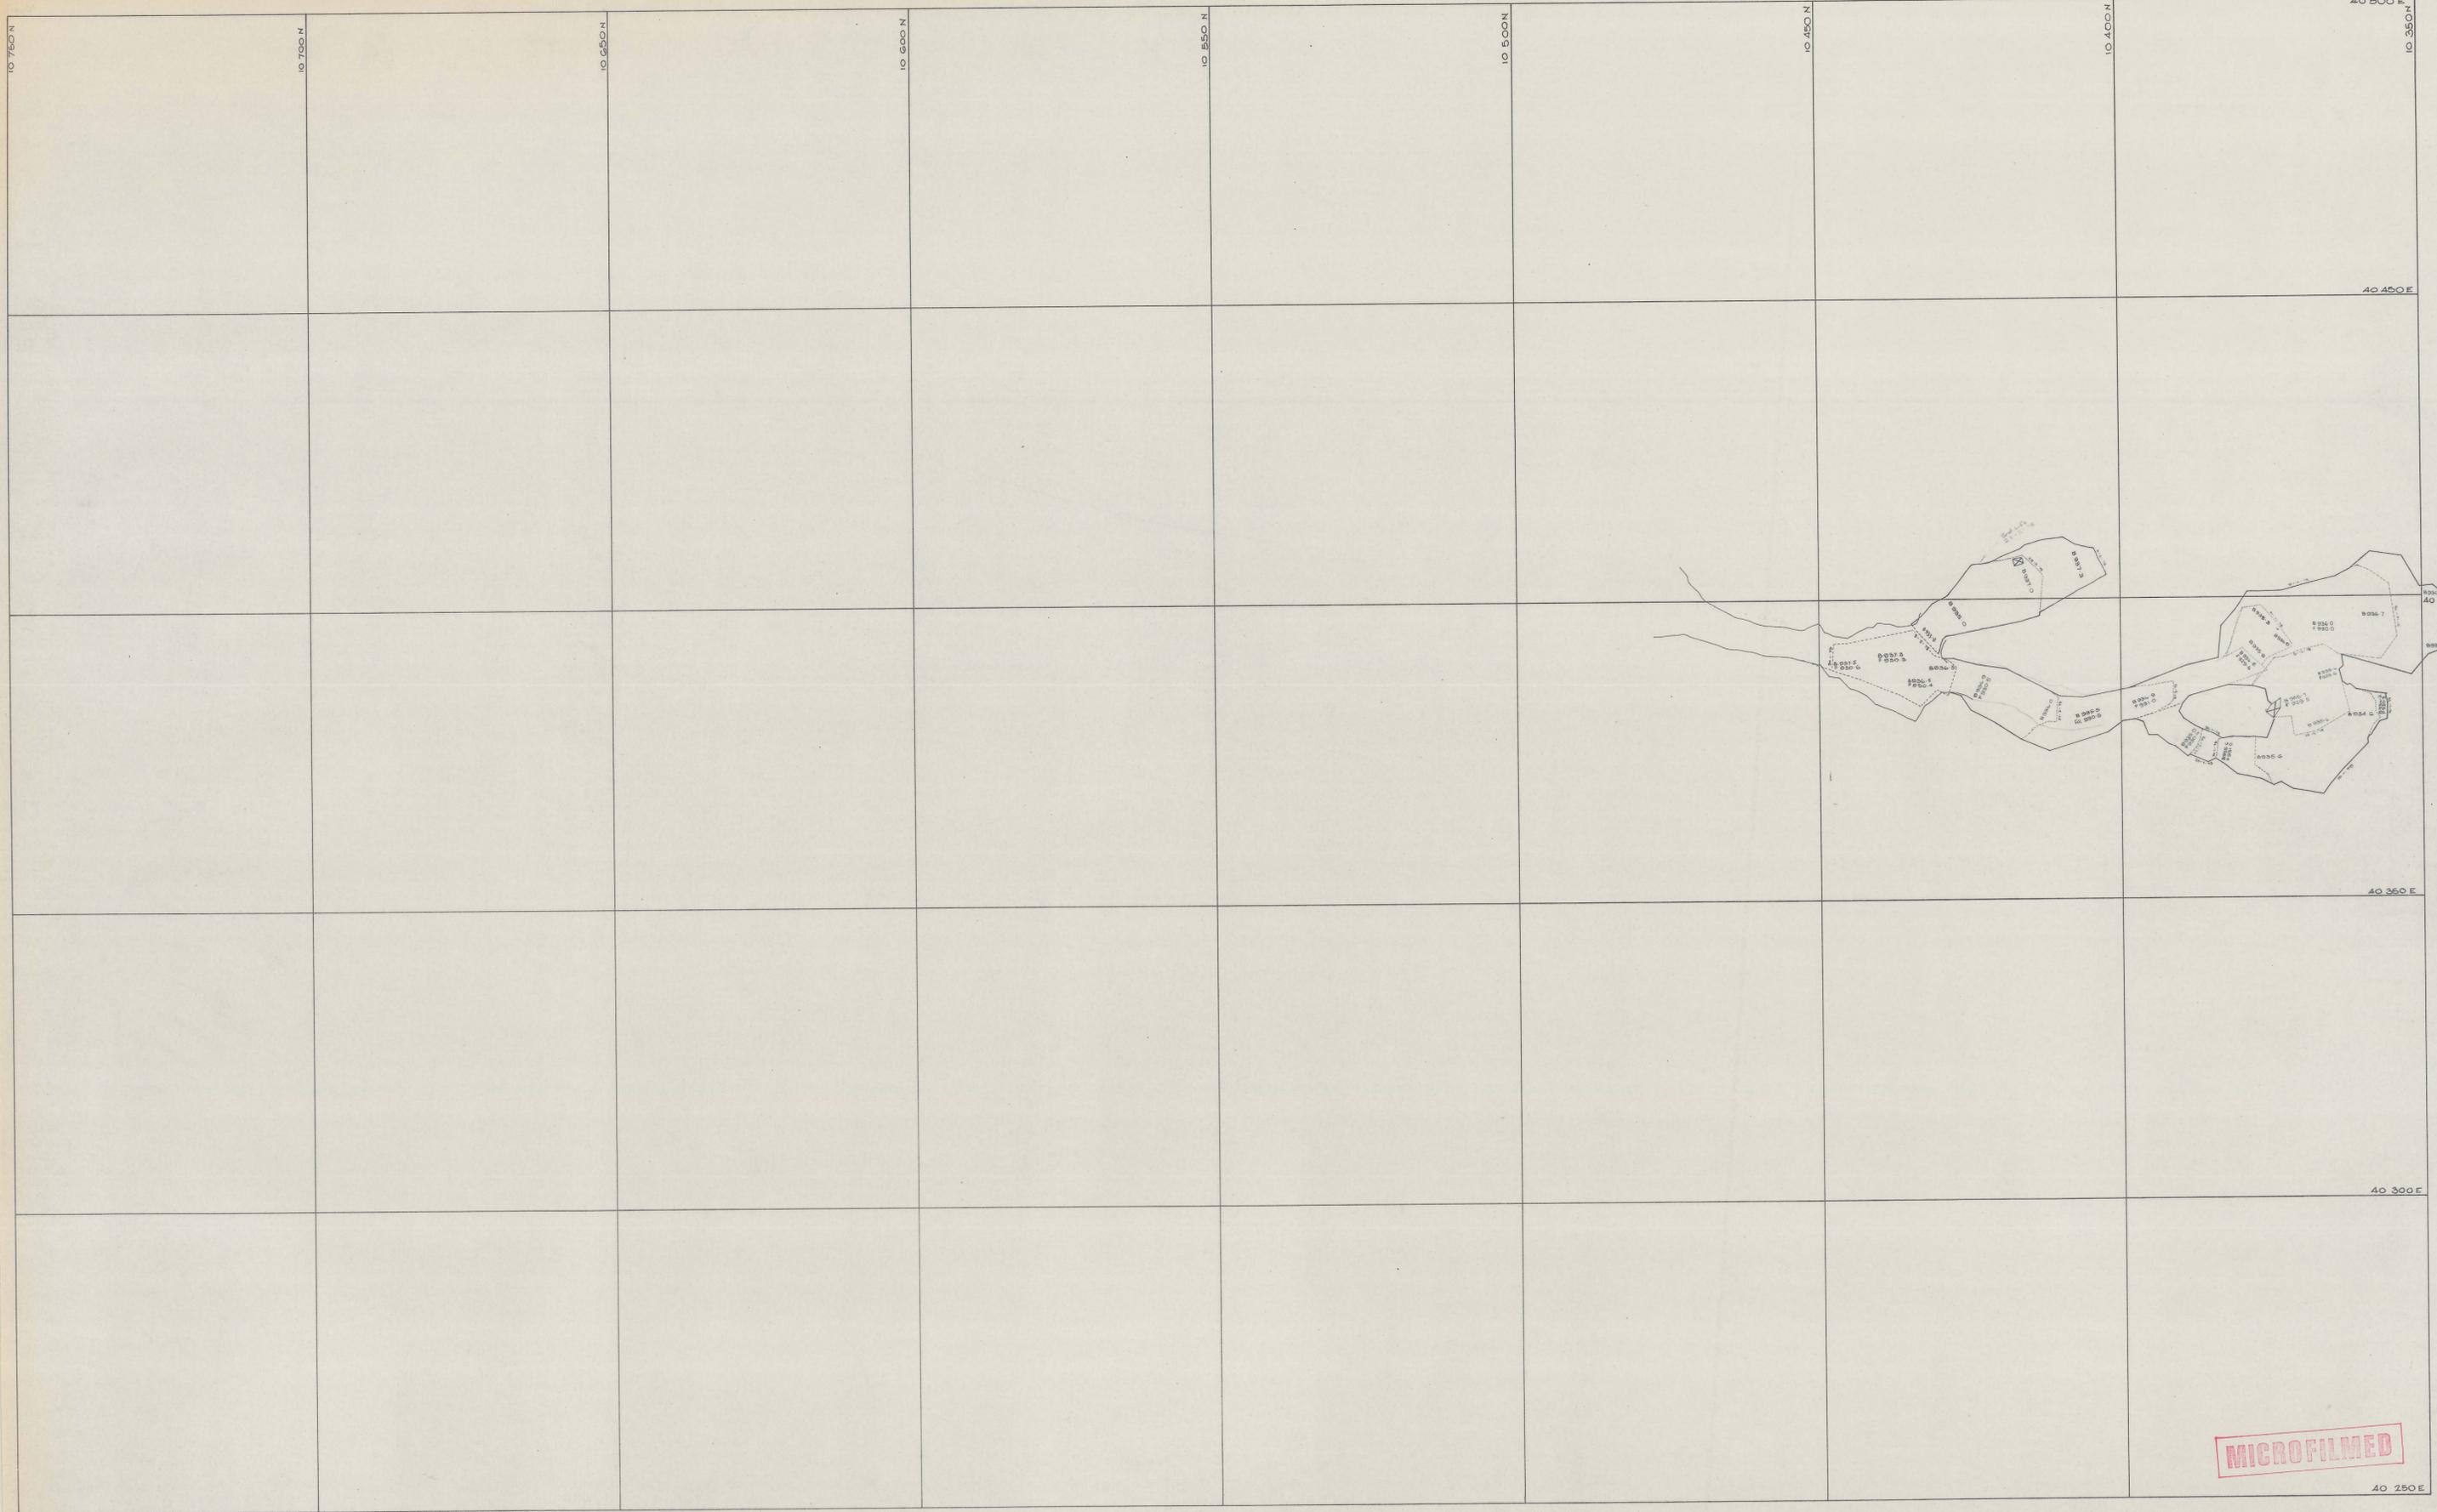

MICROFILMED

SCALE 1:500

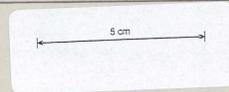

north

LOCATION BOLD HEAD MINE  
 SUBJECT O 43  
 3rd lift

**KIS** KING ISLAND SCHEELITE  
 A DIVISION OF WARMAN INTERNATIONAL  
 GRASSY KING ISLAND  
 PLAN NUMBER 04BH15 - 1056 8/058