



0374_573

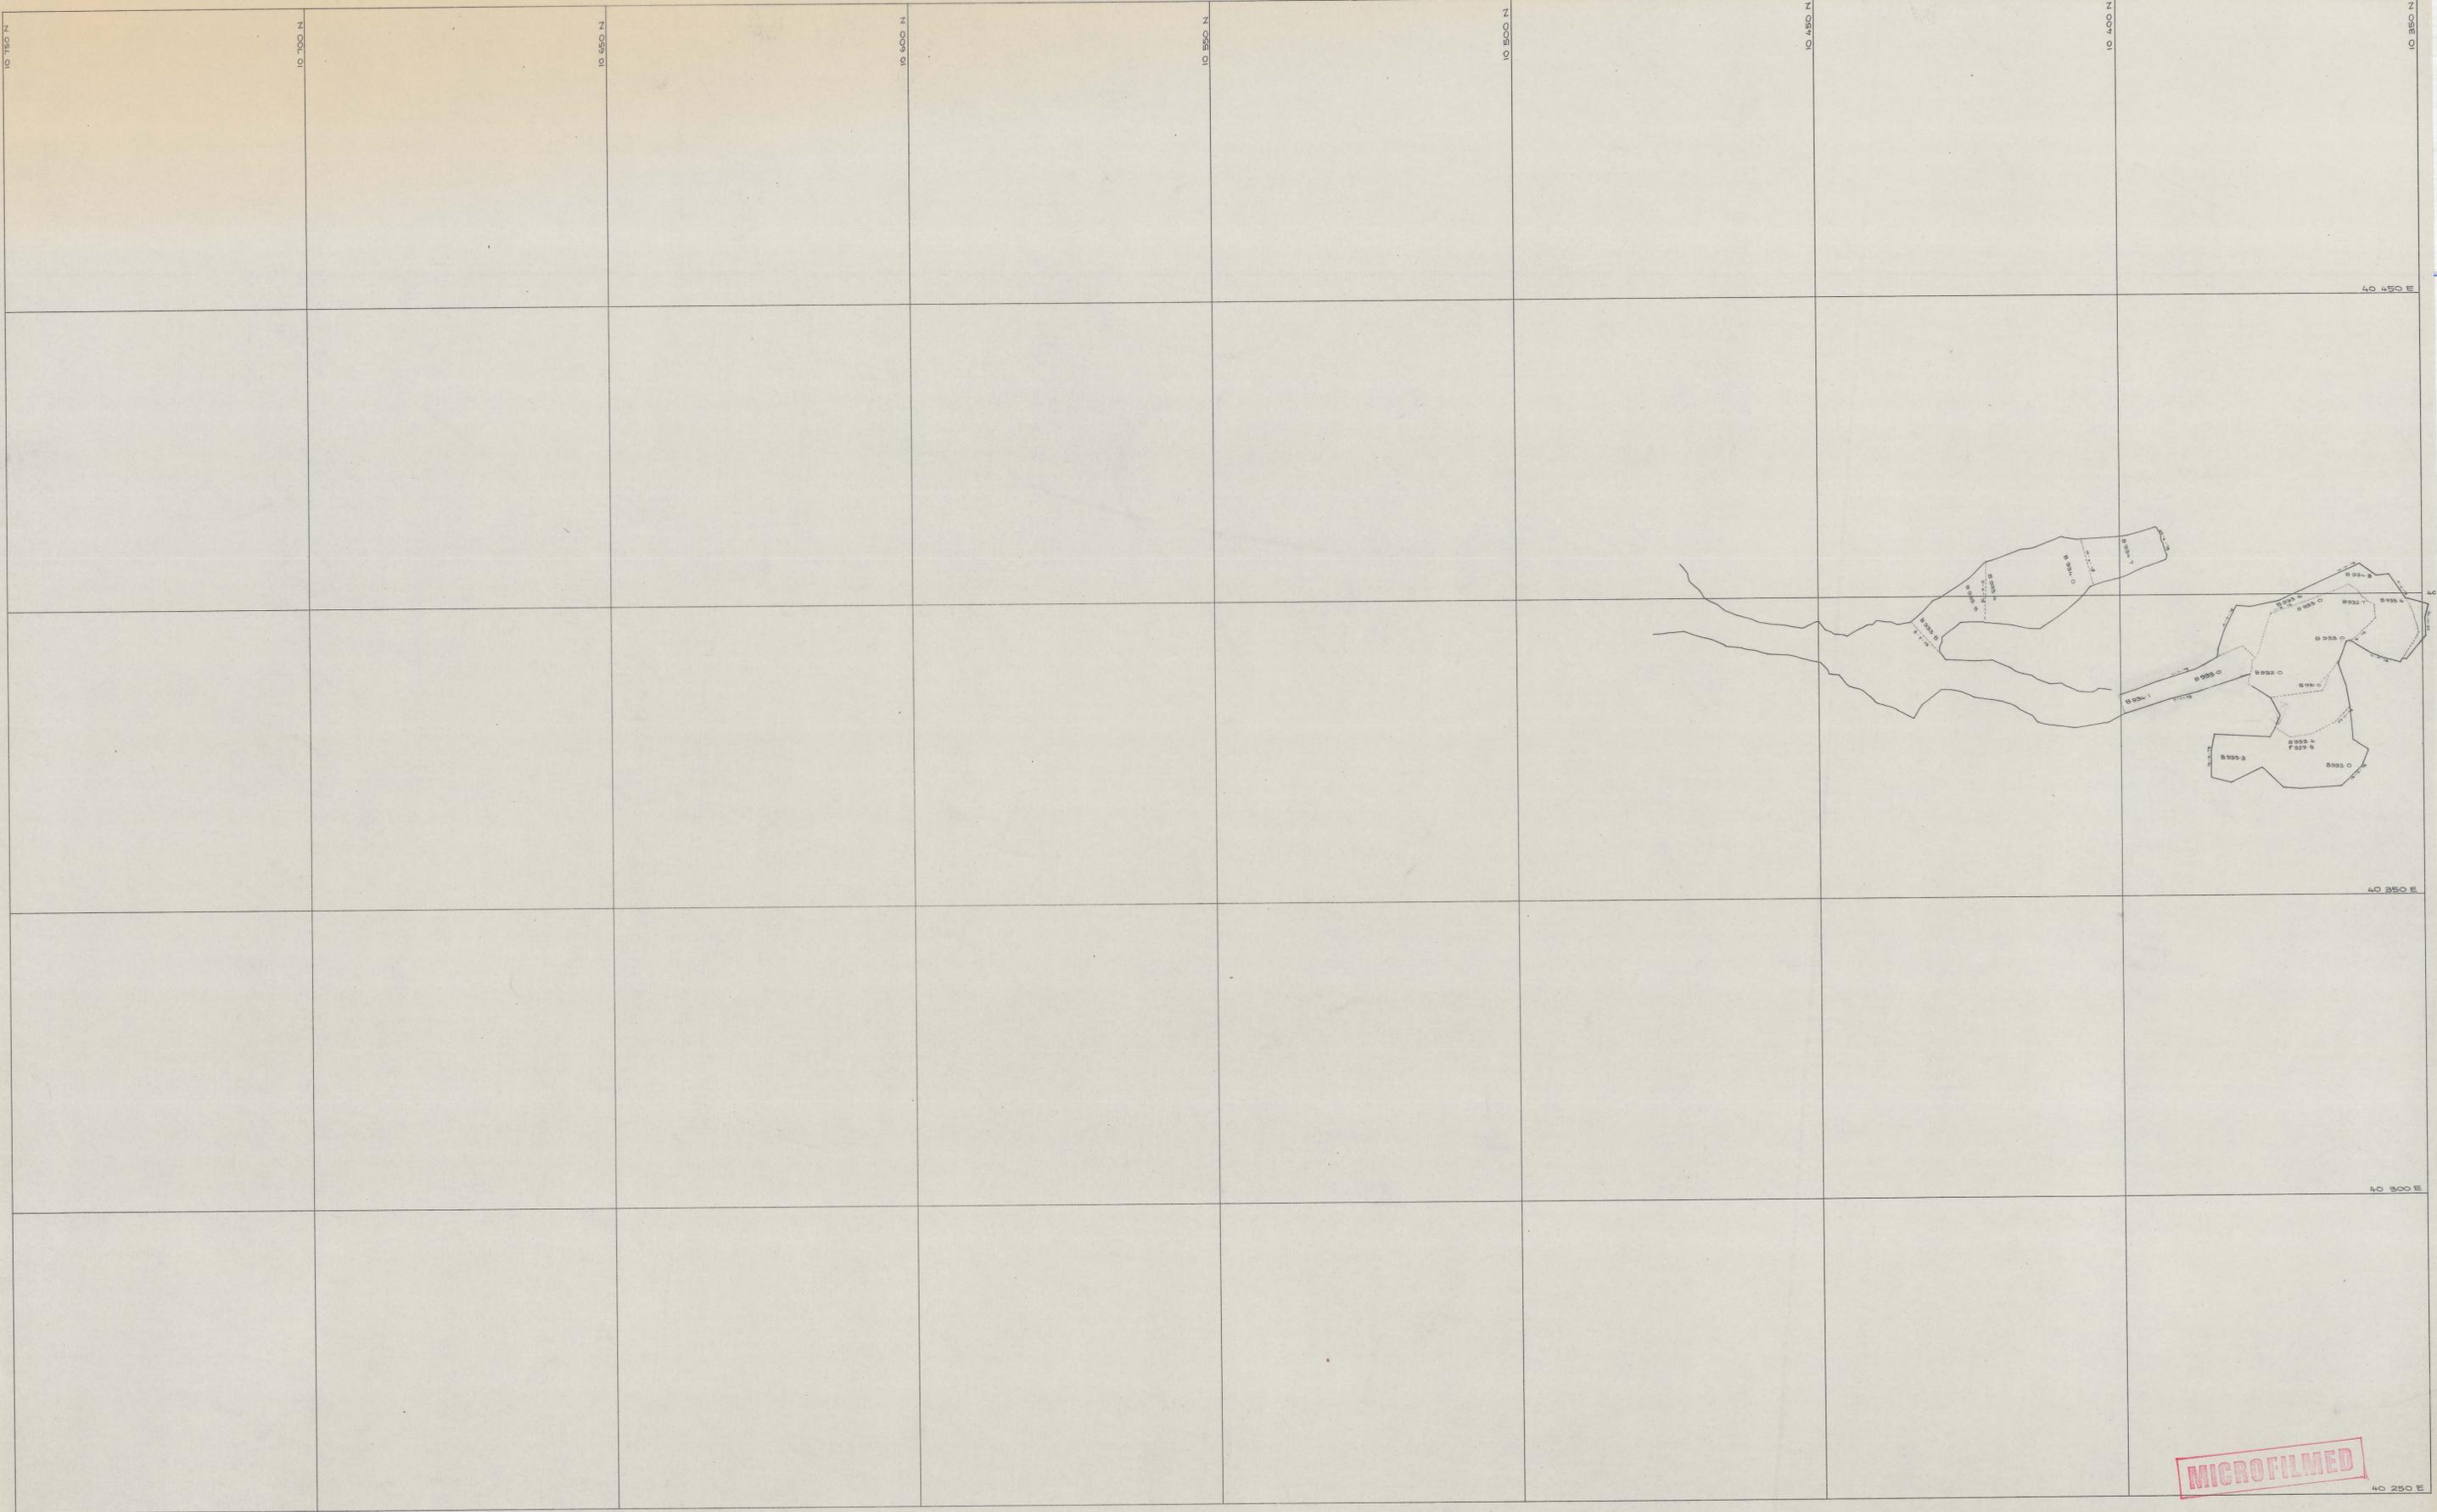

MICROFILMED

SCALE 1:500

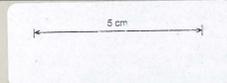

north

LOCATION BOLD HEAD MINE
 SUBJECT 0 37, 043 STOPES
 2nd lift

KIS KING ISLAND SCHEELITE
 A DIVISION OF WARMAN INTERNATIONAL
 GRASSY KING ISLAND
 PLAN NUMBER 04BH15 - 1057 31089