



0374\_574

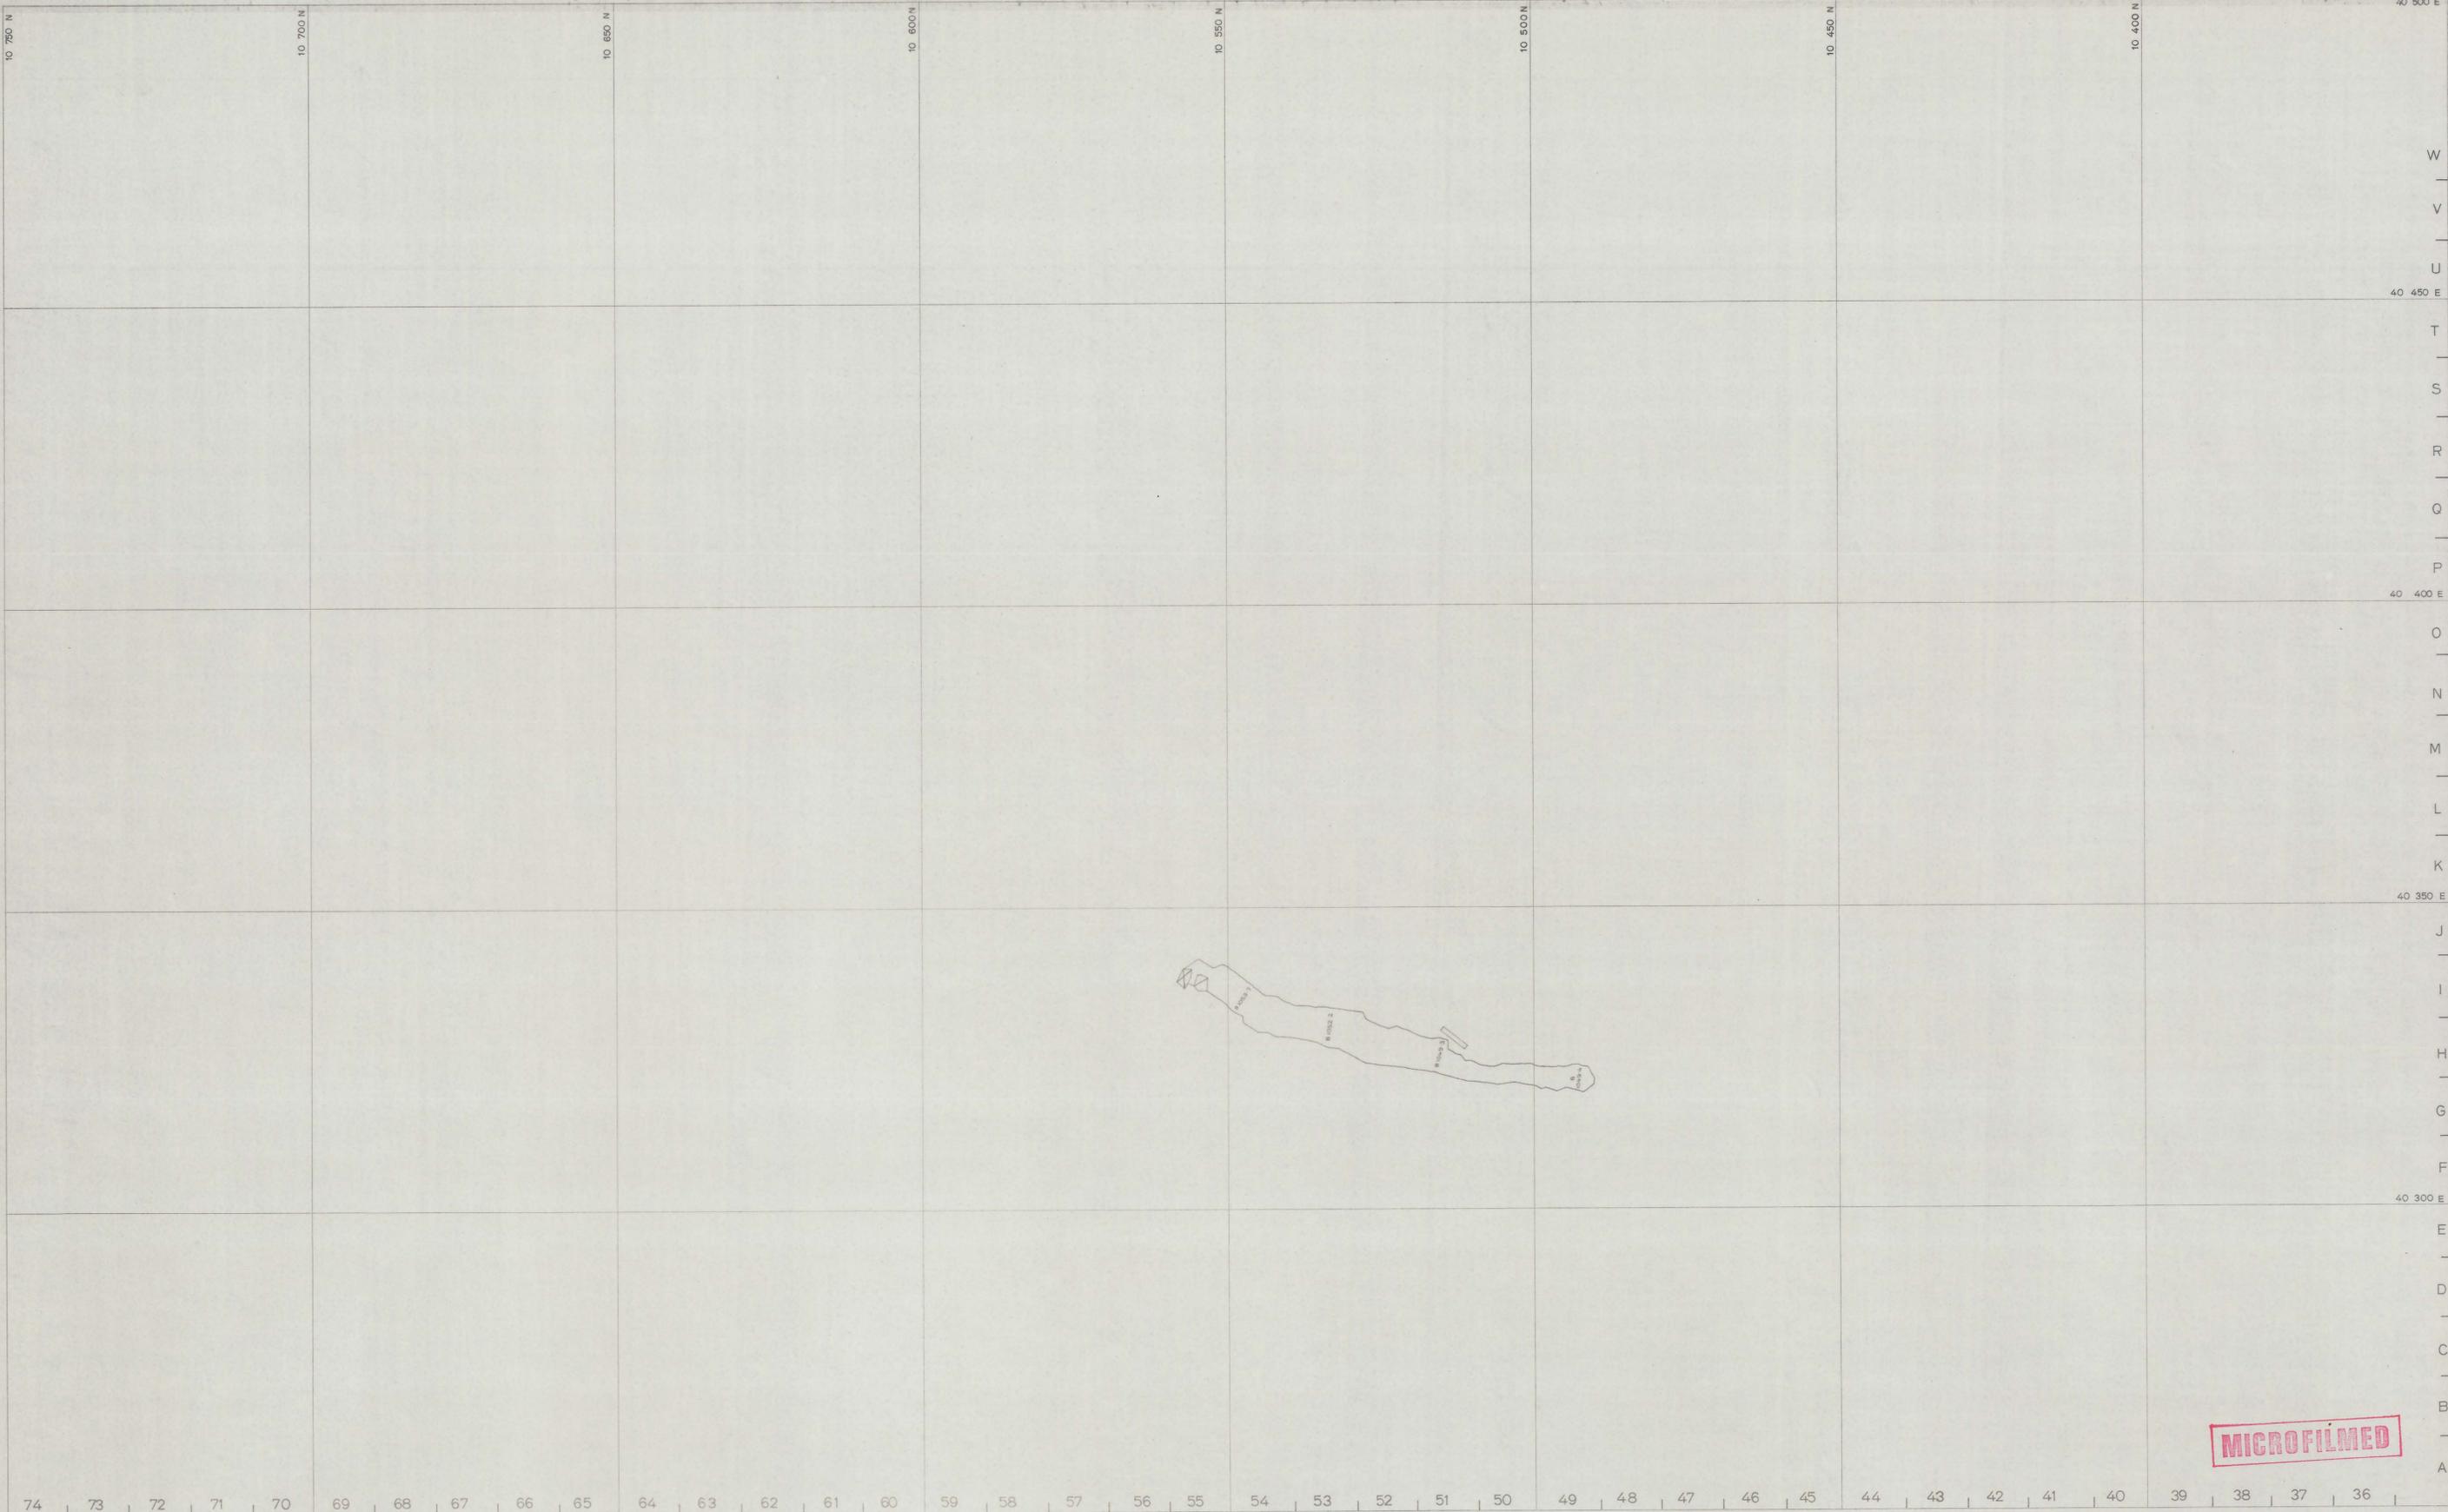

MICROFILMED

SCALE 1:500

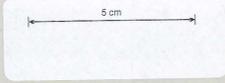

north

LOCATION

BOLD HEAD MINE

SUBJECT

H 50  
A LENS CAVO STOPE  
[1st Lift]

**KIS** KING ISLAND SCHEELITE  
A DIVISION OF WARMAN INTERNATIONAL  
GRASSY KING ISLAND

PLAN NUMBER 04BH15-1020

81065