


0374\_576

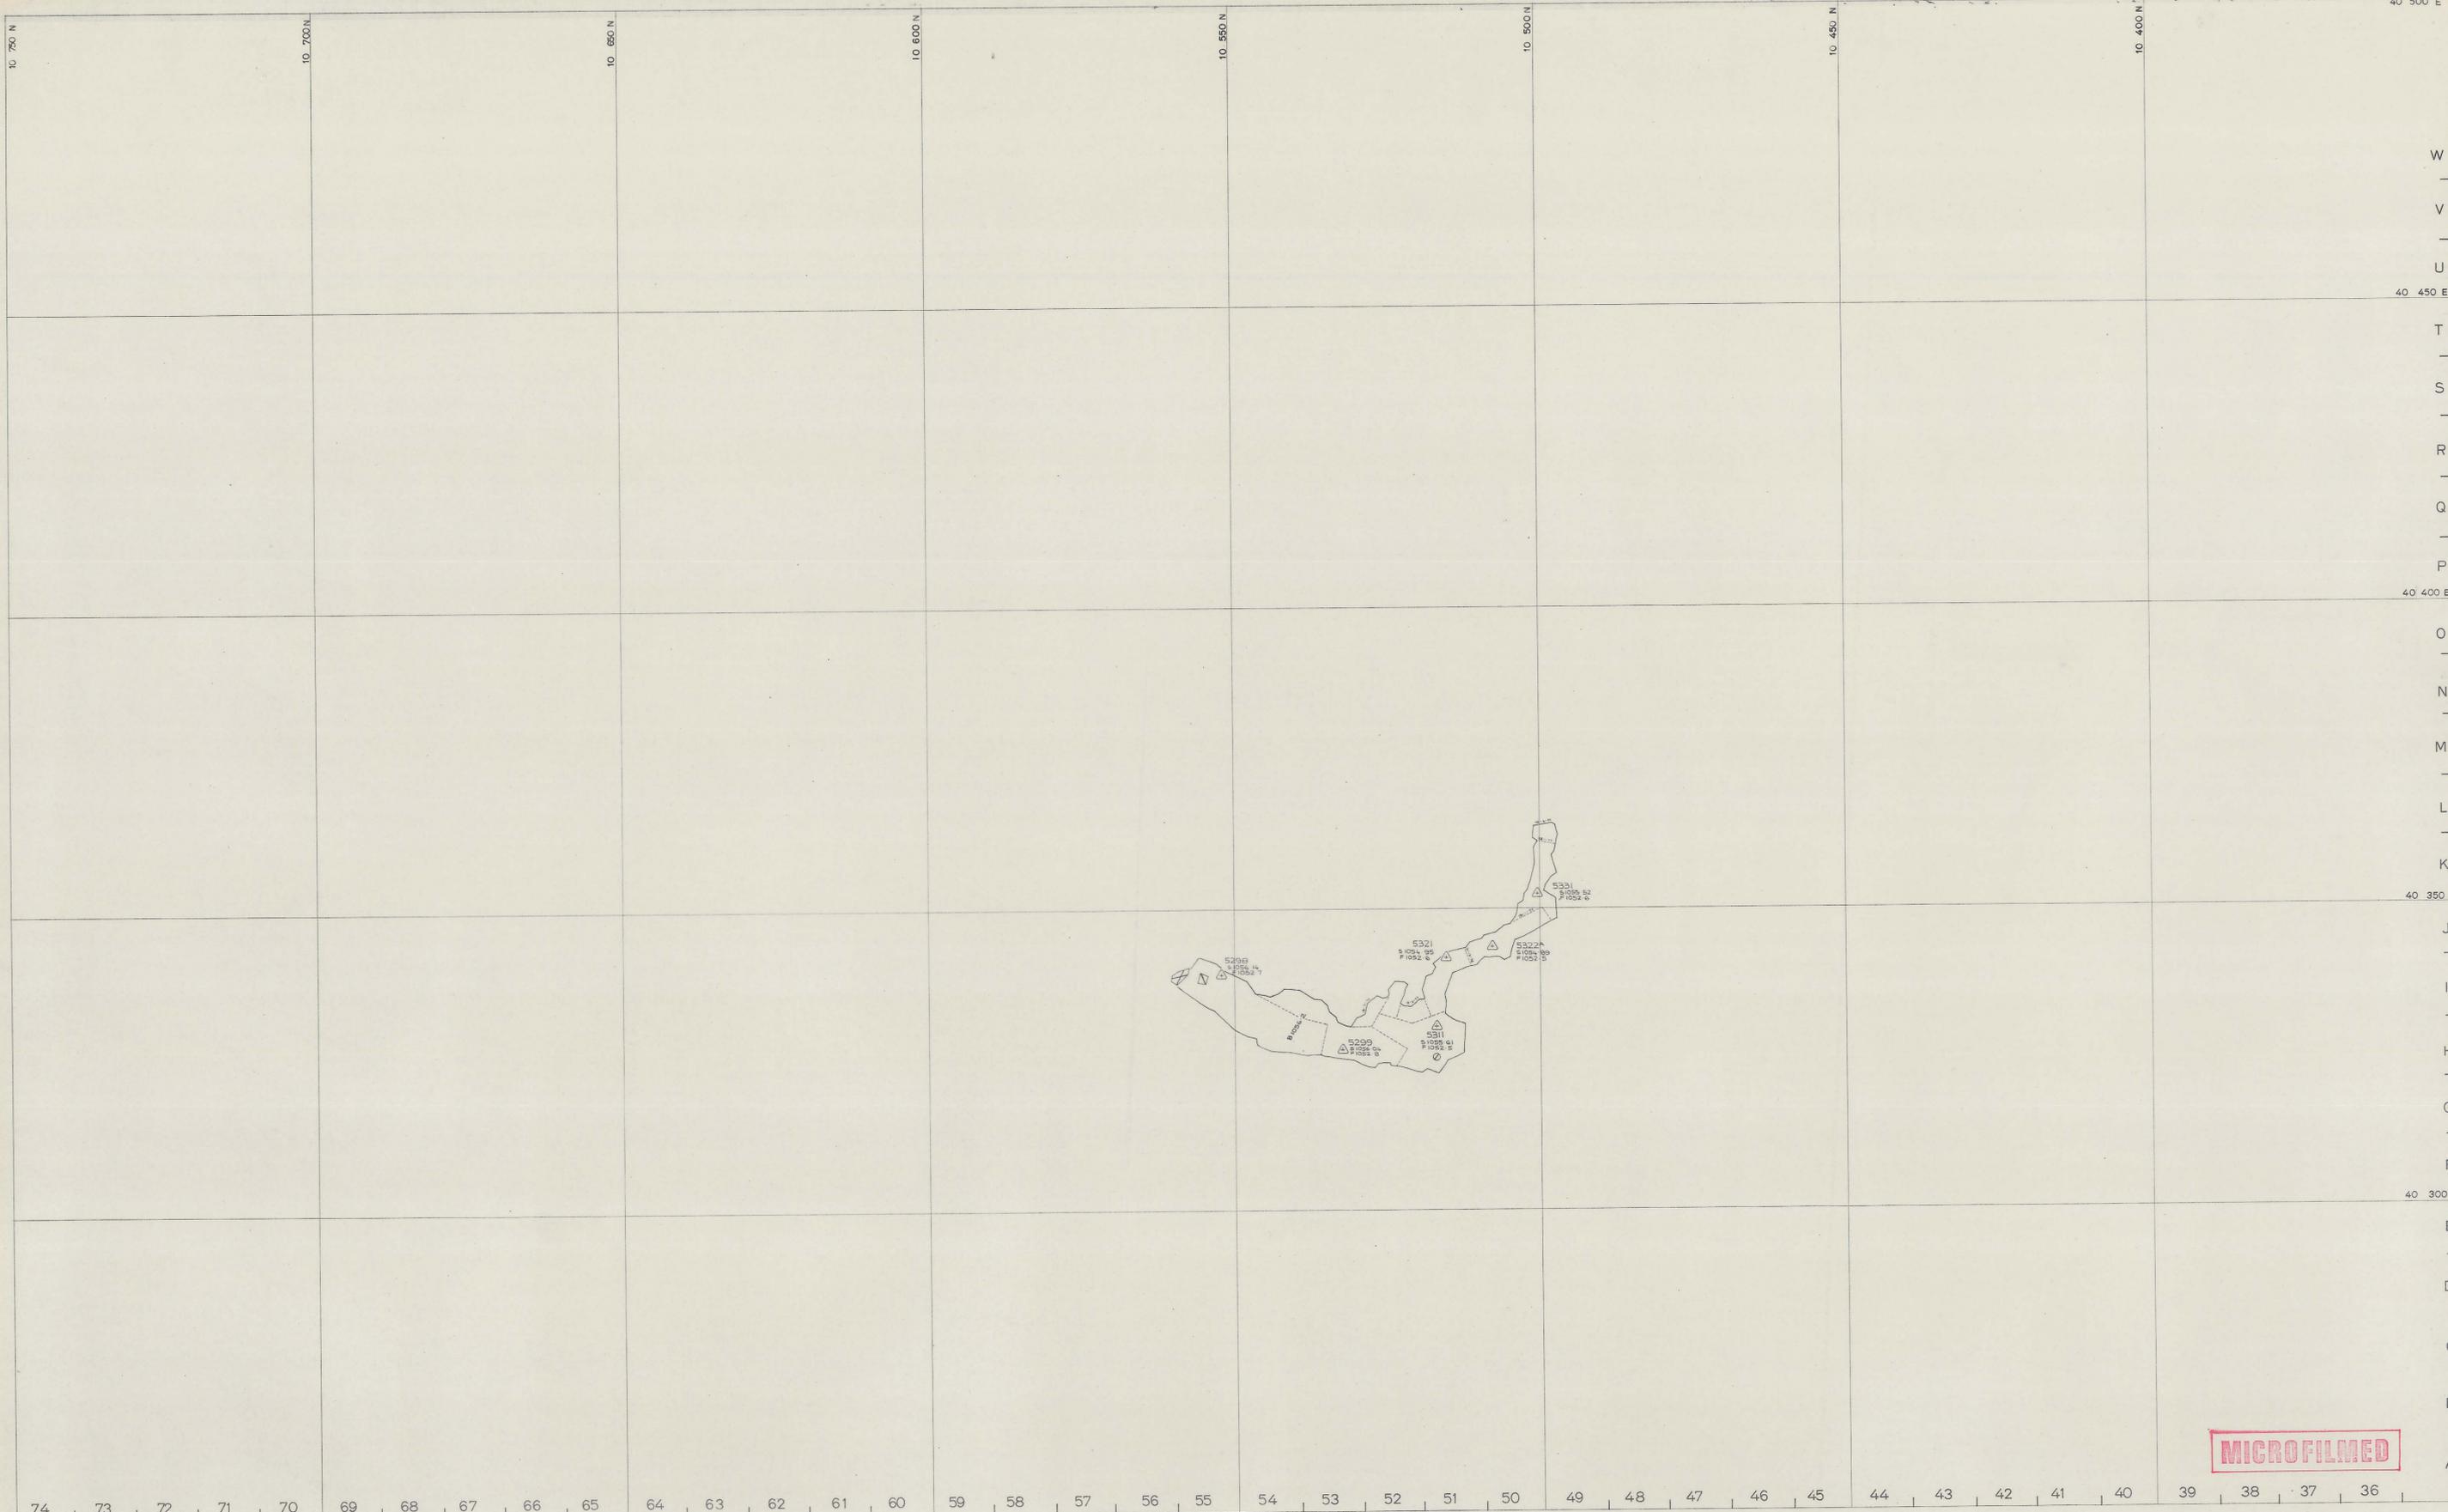

MICROFILMED

74 73 72 71 70 69 68 67 66 65 64 63 62 61 60 59 58 57 56 55 54 53 52 51 50 49 48 47 46 45 44 43 42 41 40 39 38 37 36

SCALE 1:500 	LOCATION BOLD HEAD MINE	
	SUBJECT H 50 A LENS CAVO STOPE [3rd Lift]	
north		