


0374_577

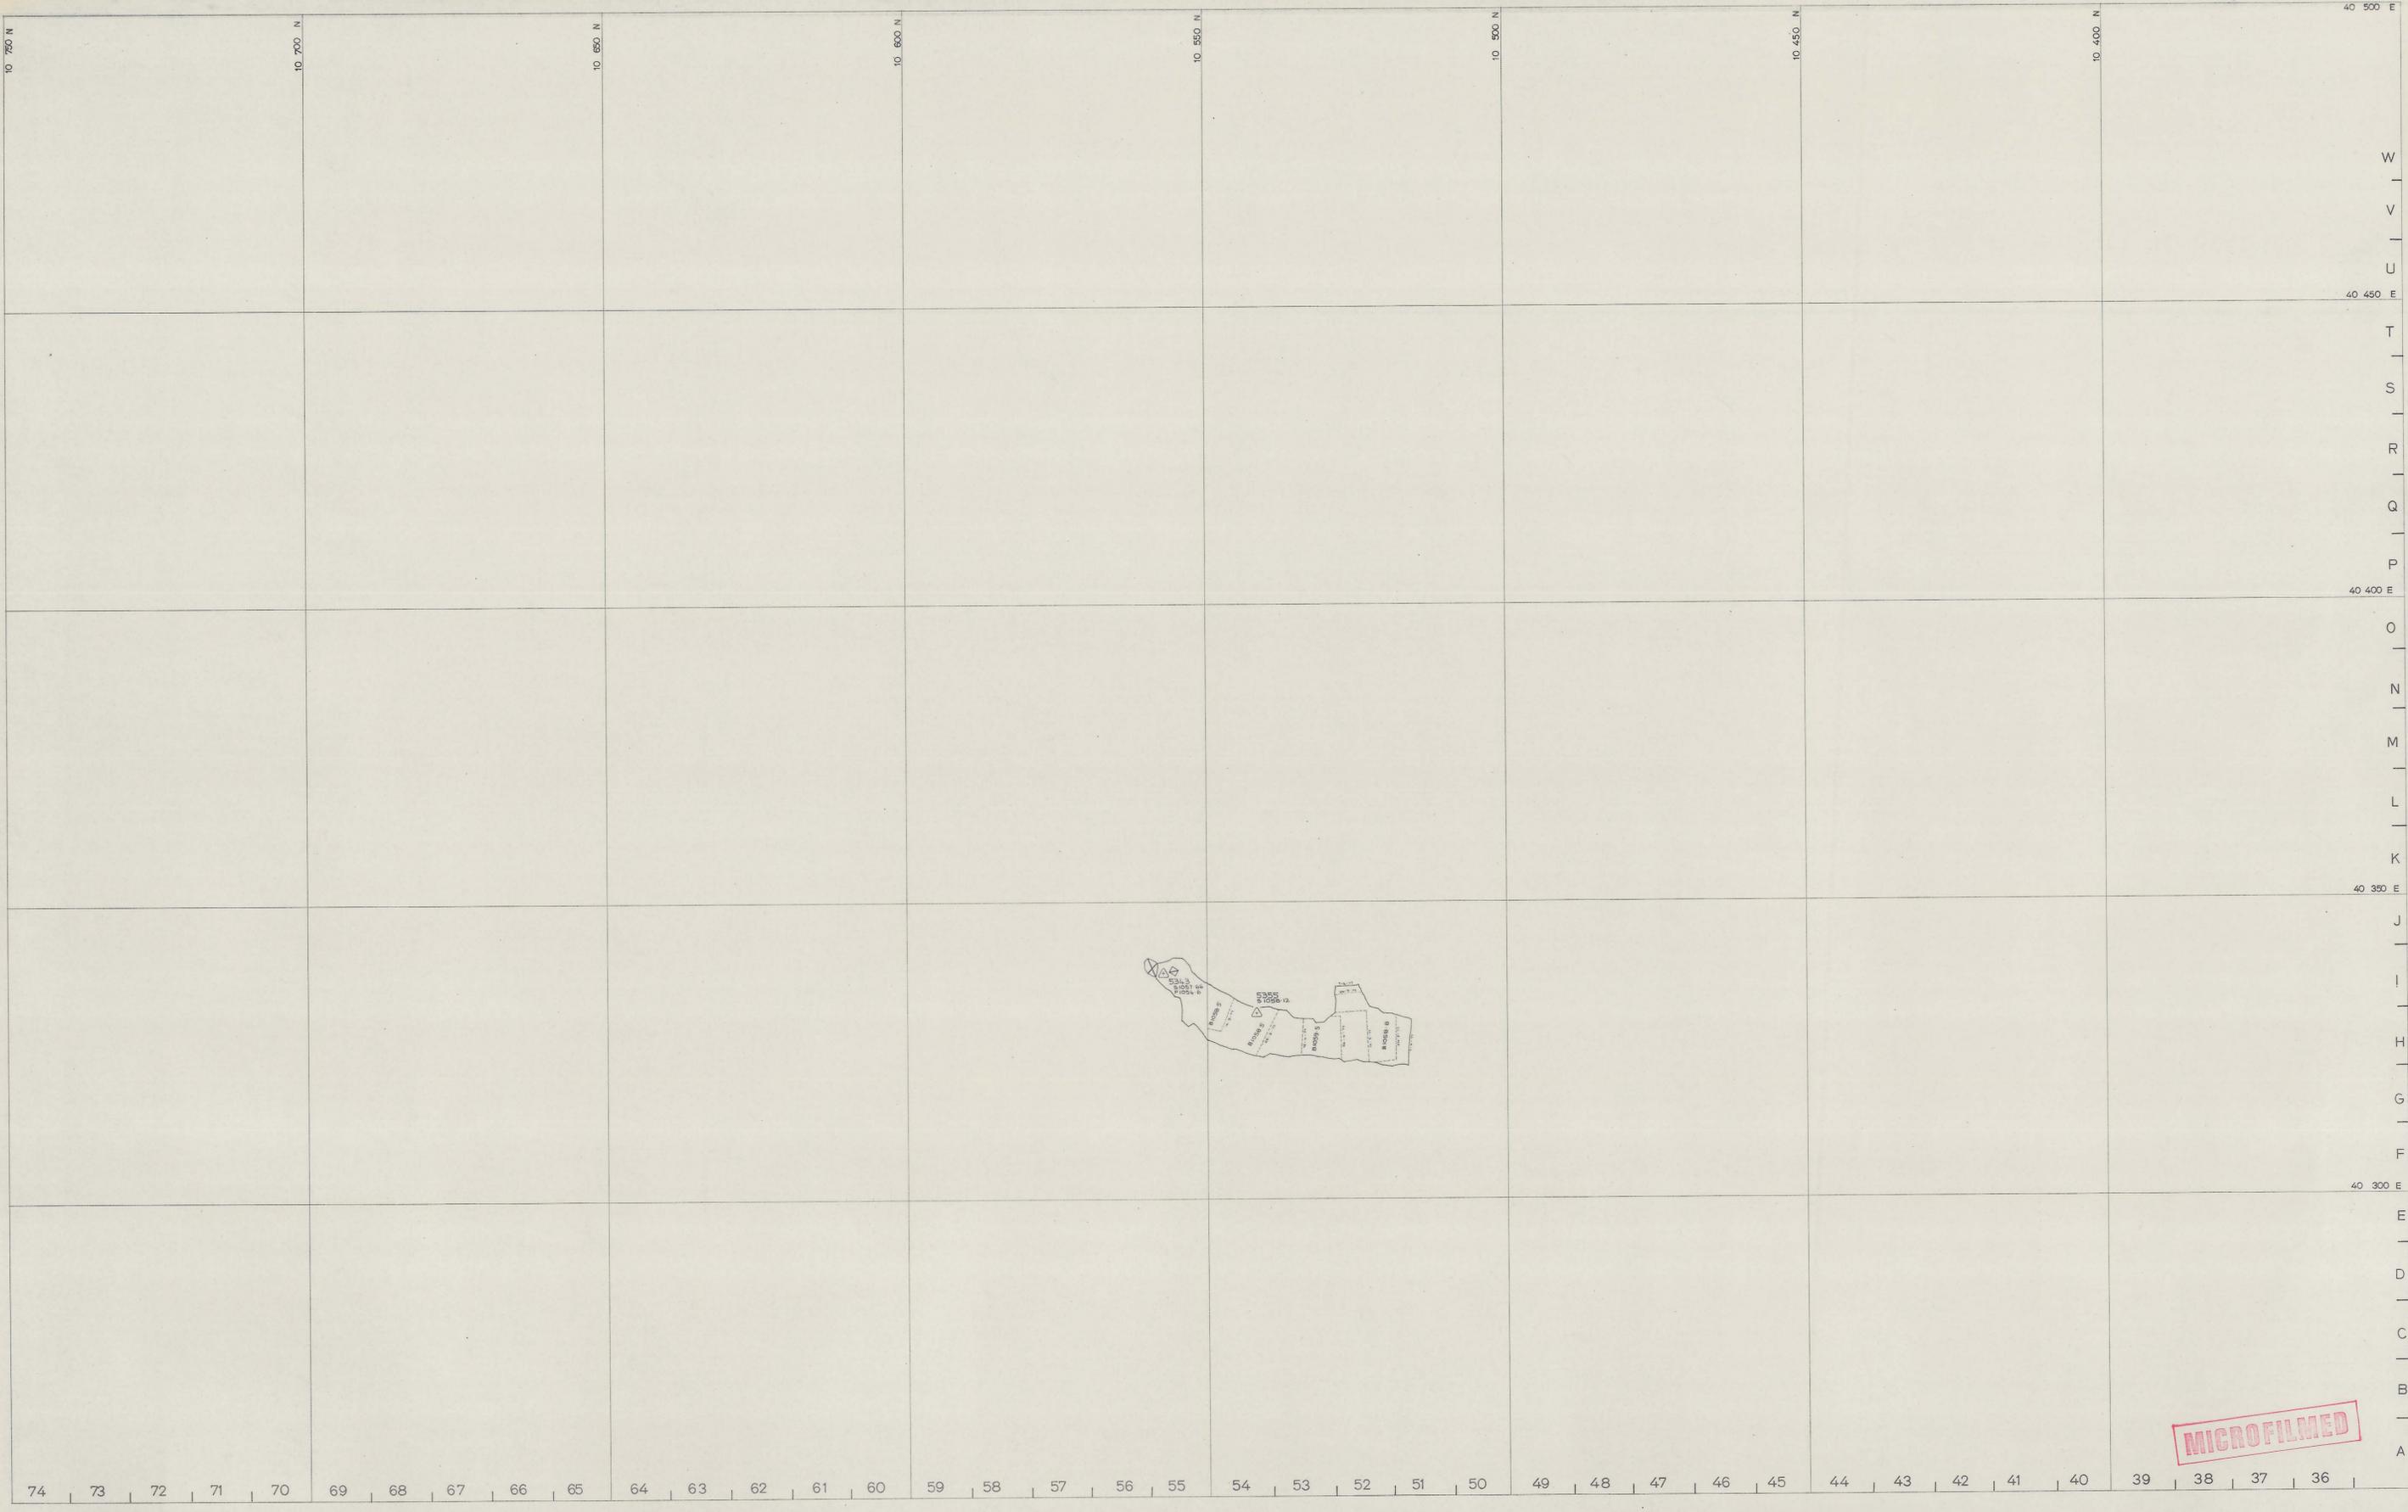

MICROFILMED

	<p>SCALE 1:500</p> <p>5 cm</p>	<p>north</p>	<p>LOCATION BOLD HEAD MINE</p> <p>SUBJECT H 50 A LENS CAVO STOPE [4th Lift]</p>	<p>KIS KING ISLAND SCHEELITE A DIVISION OF WARMAN INTERNATIONAL</p> <p>GRASSY KING ISLAND</p> <p>PLAN NUMBER 04BH15-1023</p> <p>87068</p>
--	--------------------------------	--------------	---	--