
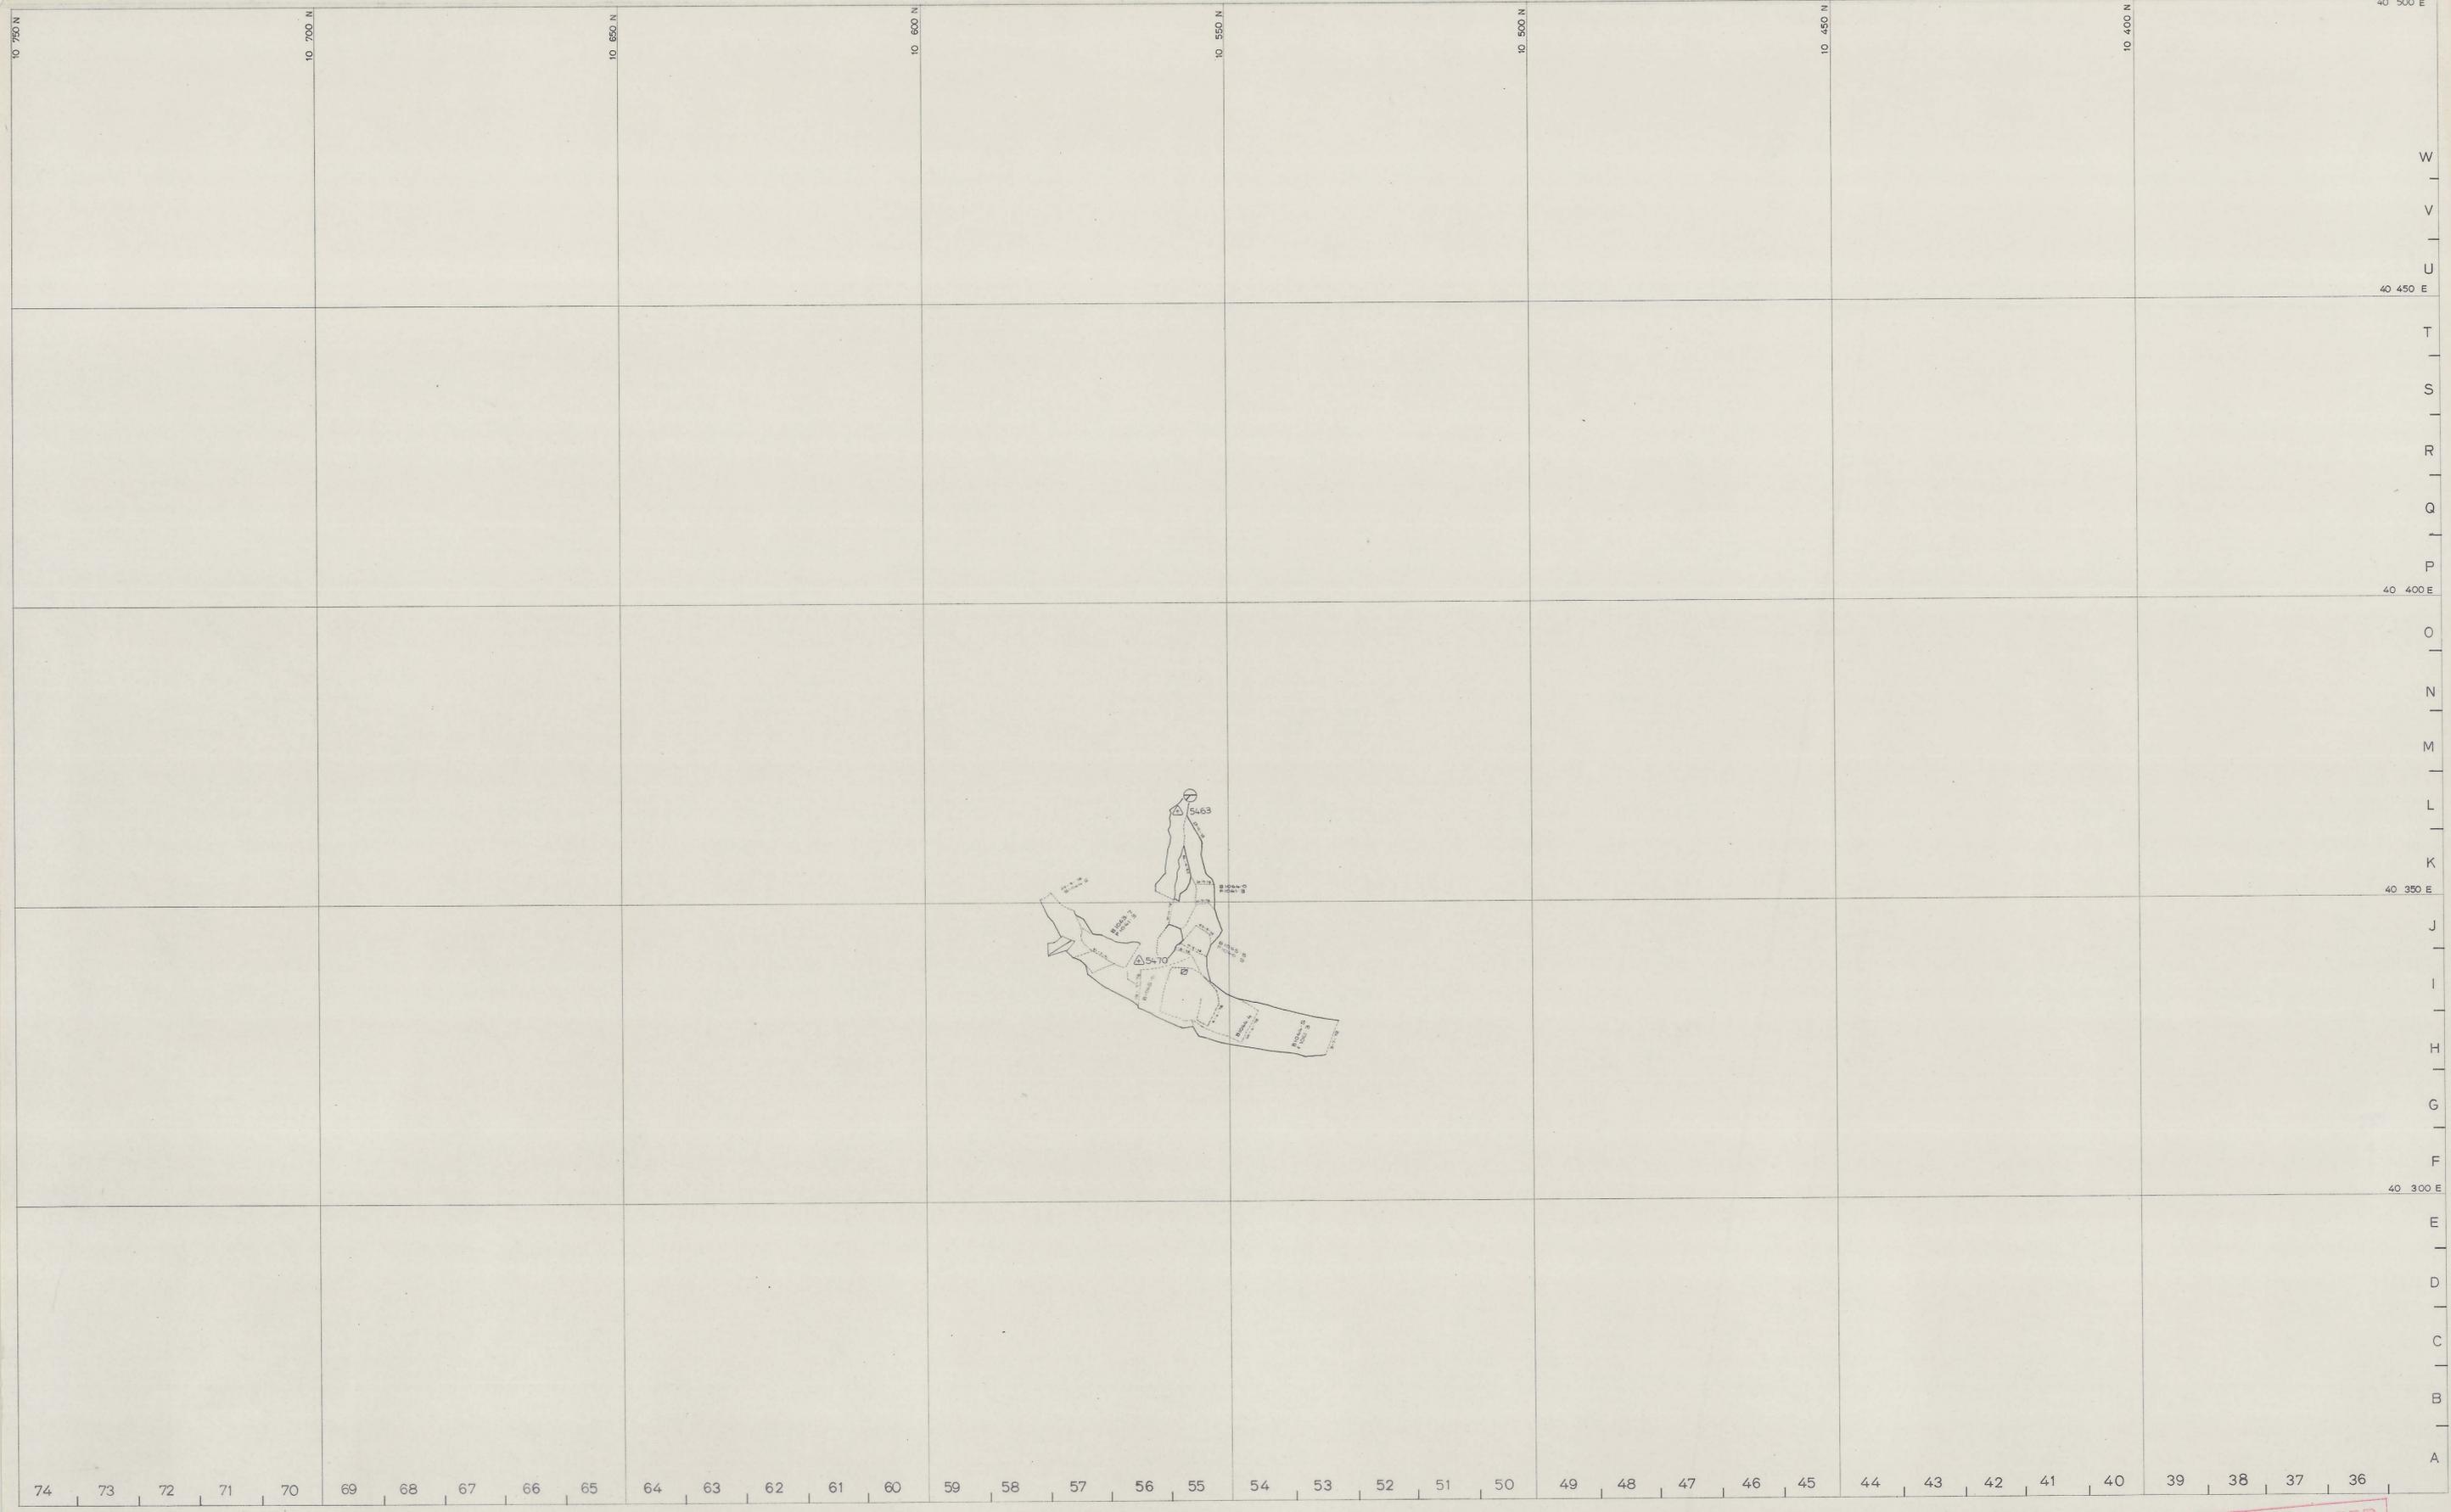


0374_580

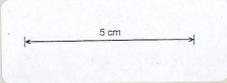

MICROFILMED

	SCALE 1:500		LOCATION BOLD HEAD MINE
		north	SUBJECT H 50 A LENS CAVO STOPE [7th Lift]
			 <small>A DIVISION OF WARMAN INTERNATIONAL</small> GRASSY KING ISLAND PLAN NUMBER 04BH15-1026 8/071