


0374_581

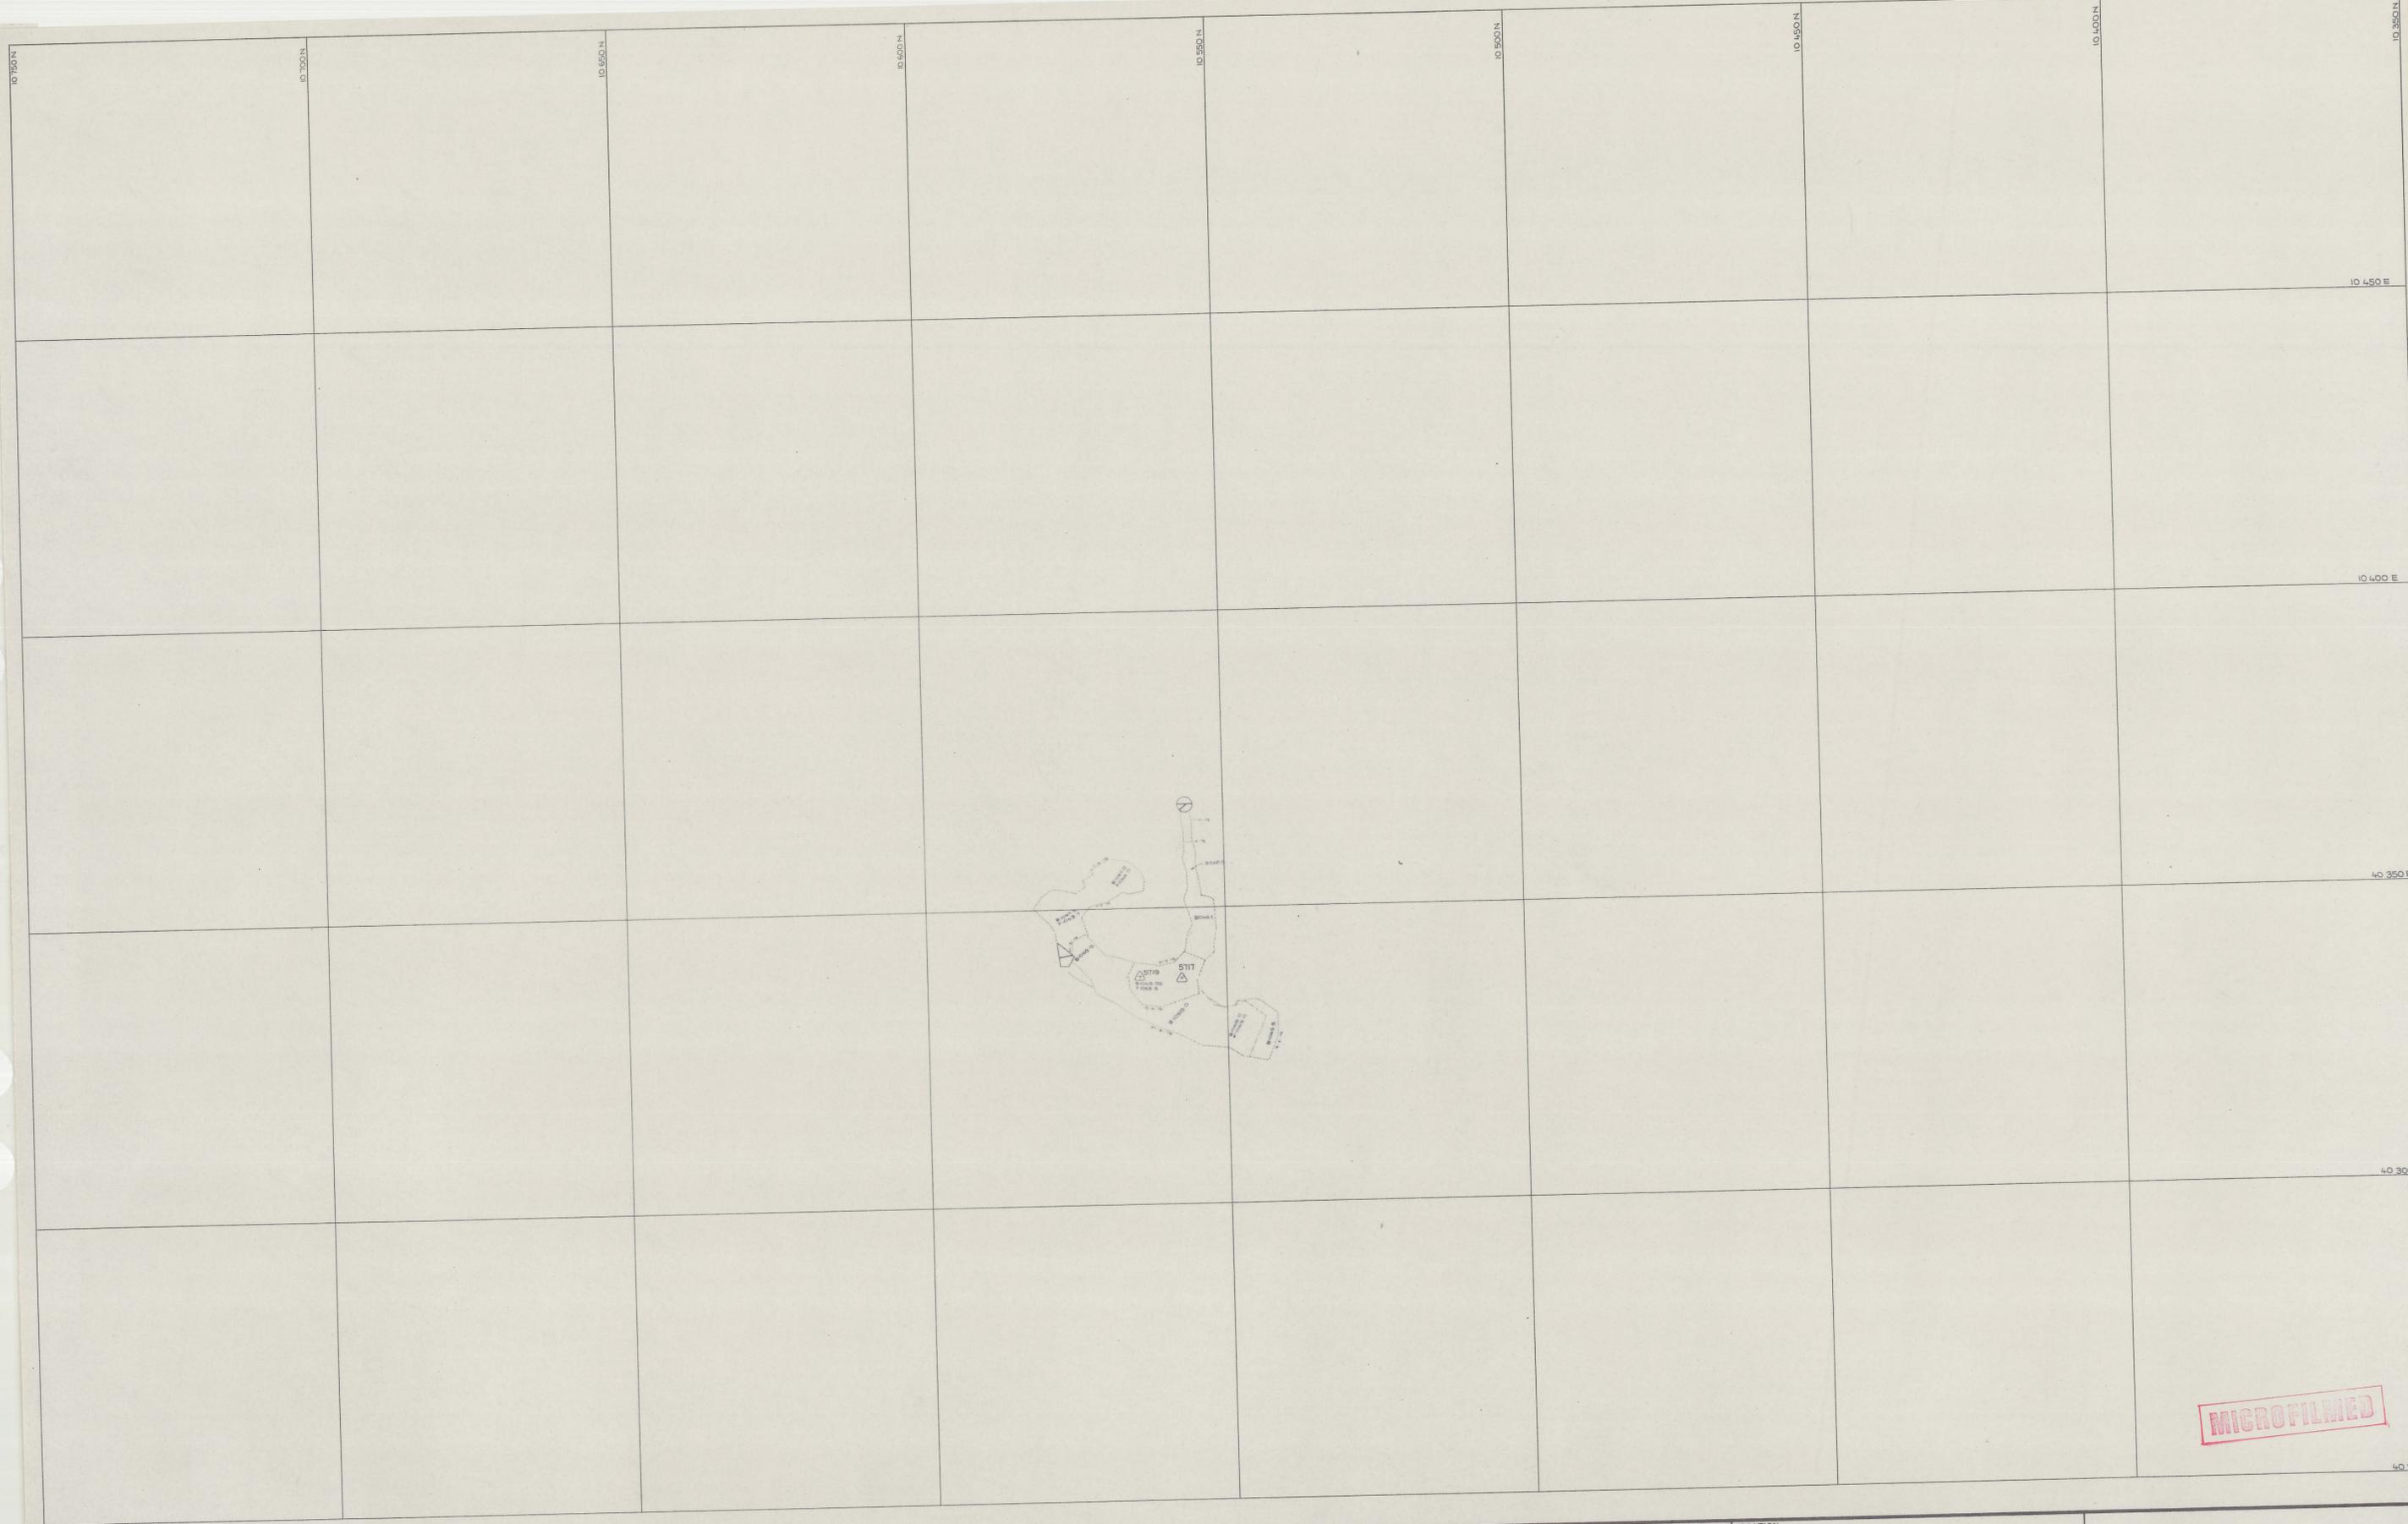

MICROFILMED

SCALE 1:500

5 cm

LOCATION BOLD HEAD MINE

SUBJECT H 50
A LENS CAVO STOPE
[9th lift]

north

KIS KING ISLAND SCHEELITE
A DIVISION OF WARMAN INTERNATIONAL

GRASSY KING ISLAND

PLAN NUMBER 04BH15 - 1028 81073