



0374_586

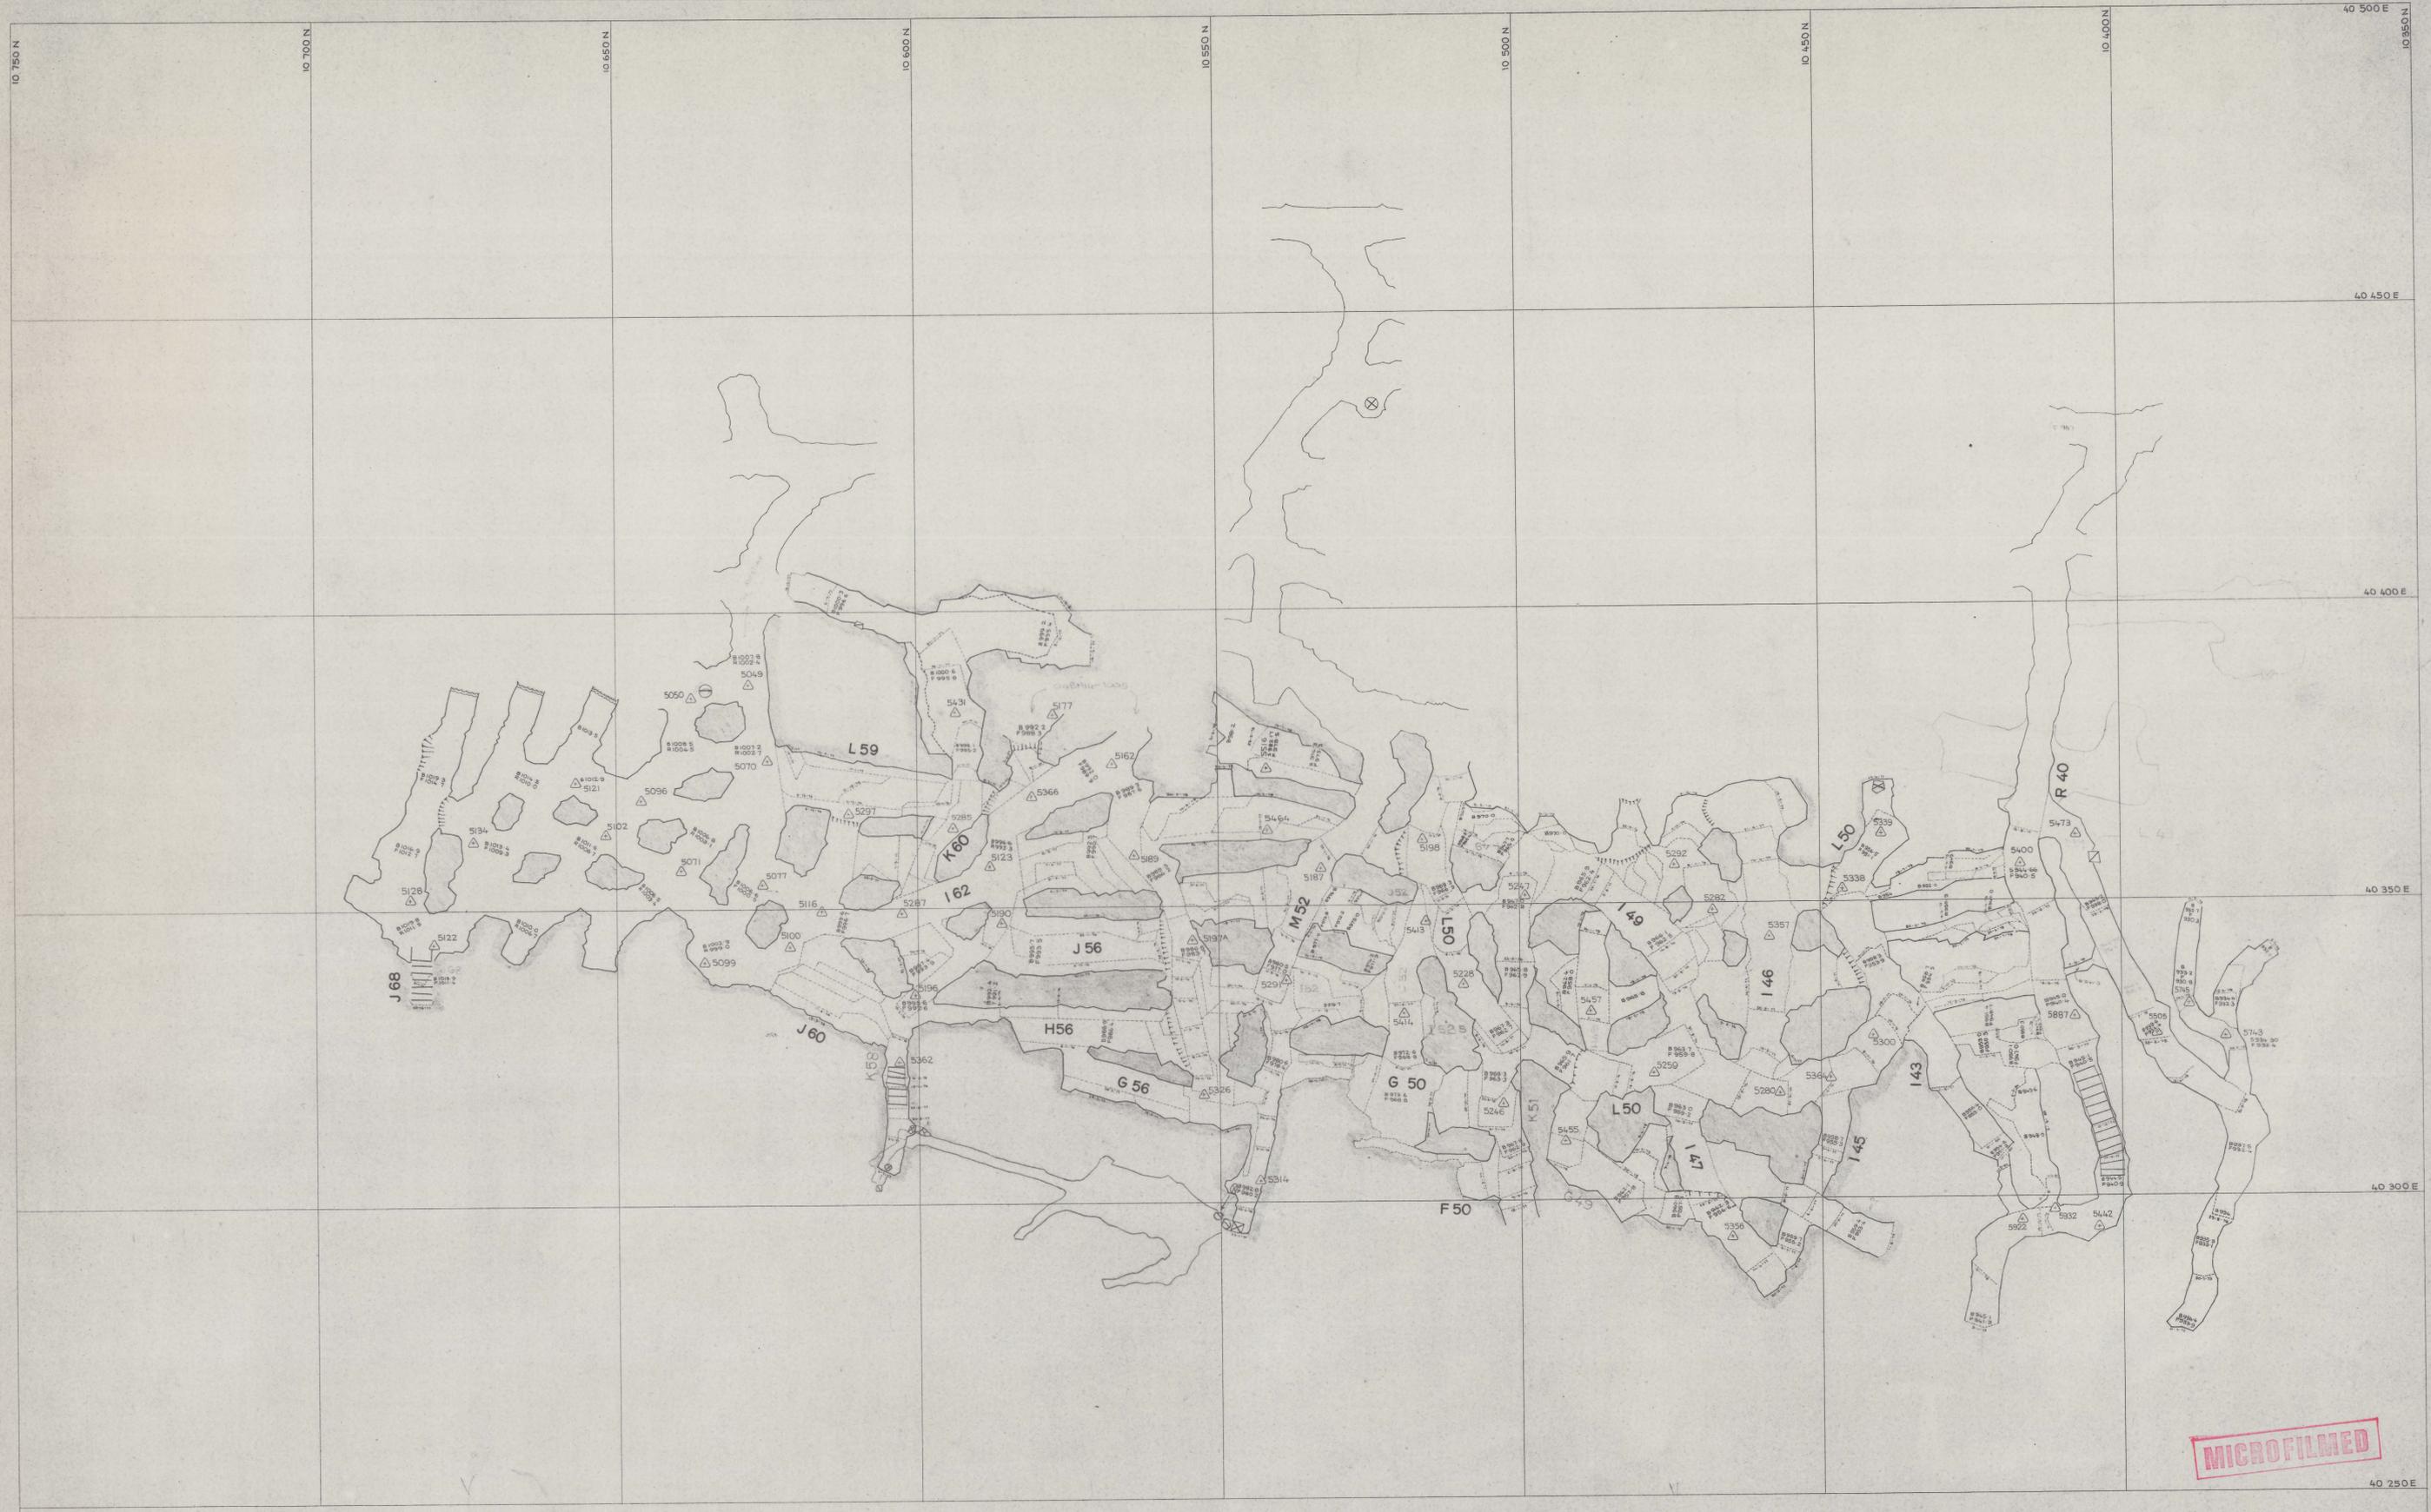

MICROFILMED

SCALE 1:500

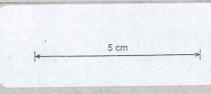

north

LOCATION
BOLD HEAD MINE

SUBJECT
B LENS MAIN STOPES

KIS KING ISLAND SCHEELITE
A DIVISION OF BARRICK INTERNATIONAL

GRASSY KING ISLAND

PLAN NUMBER
04BH15-1004

81052