
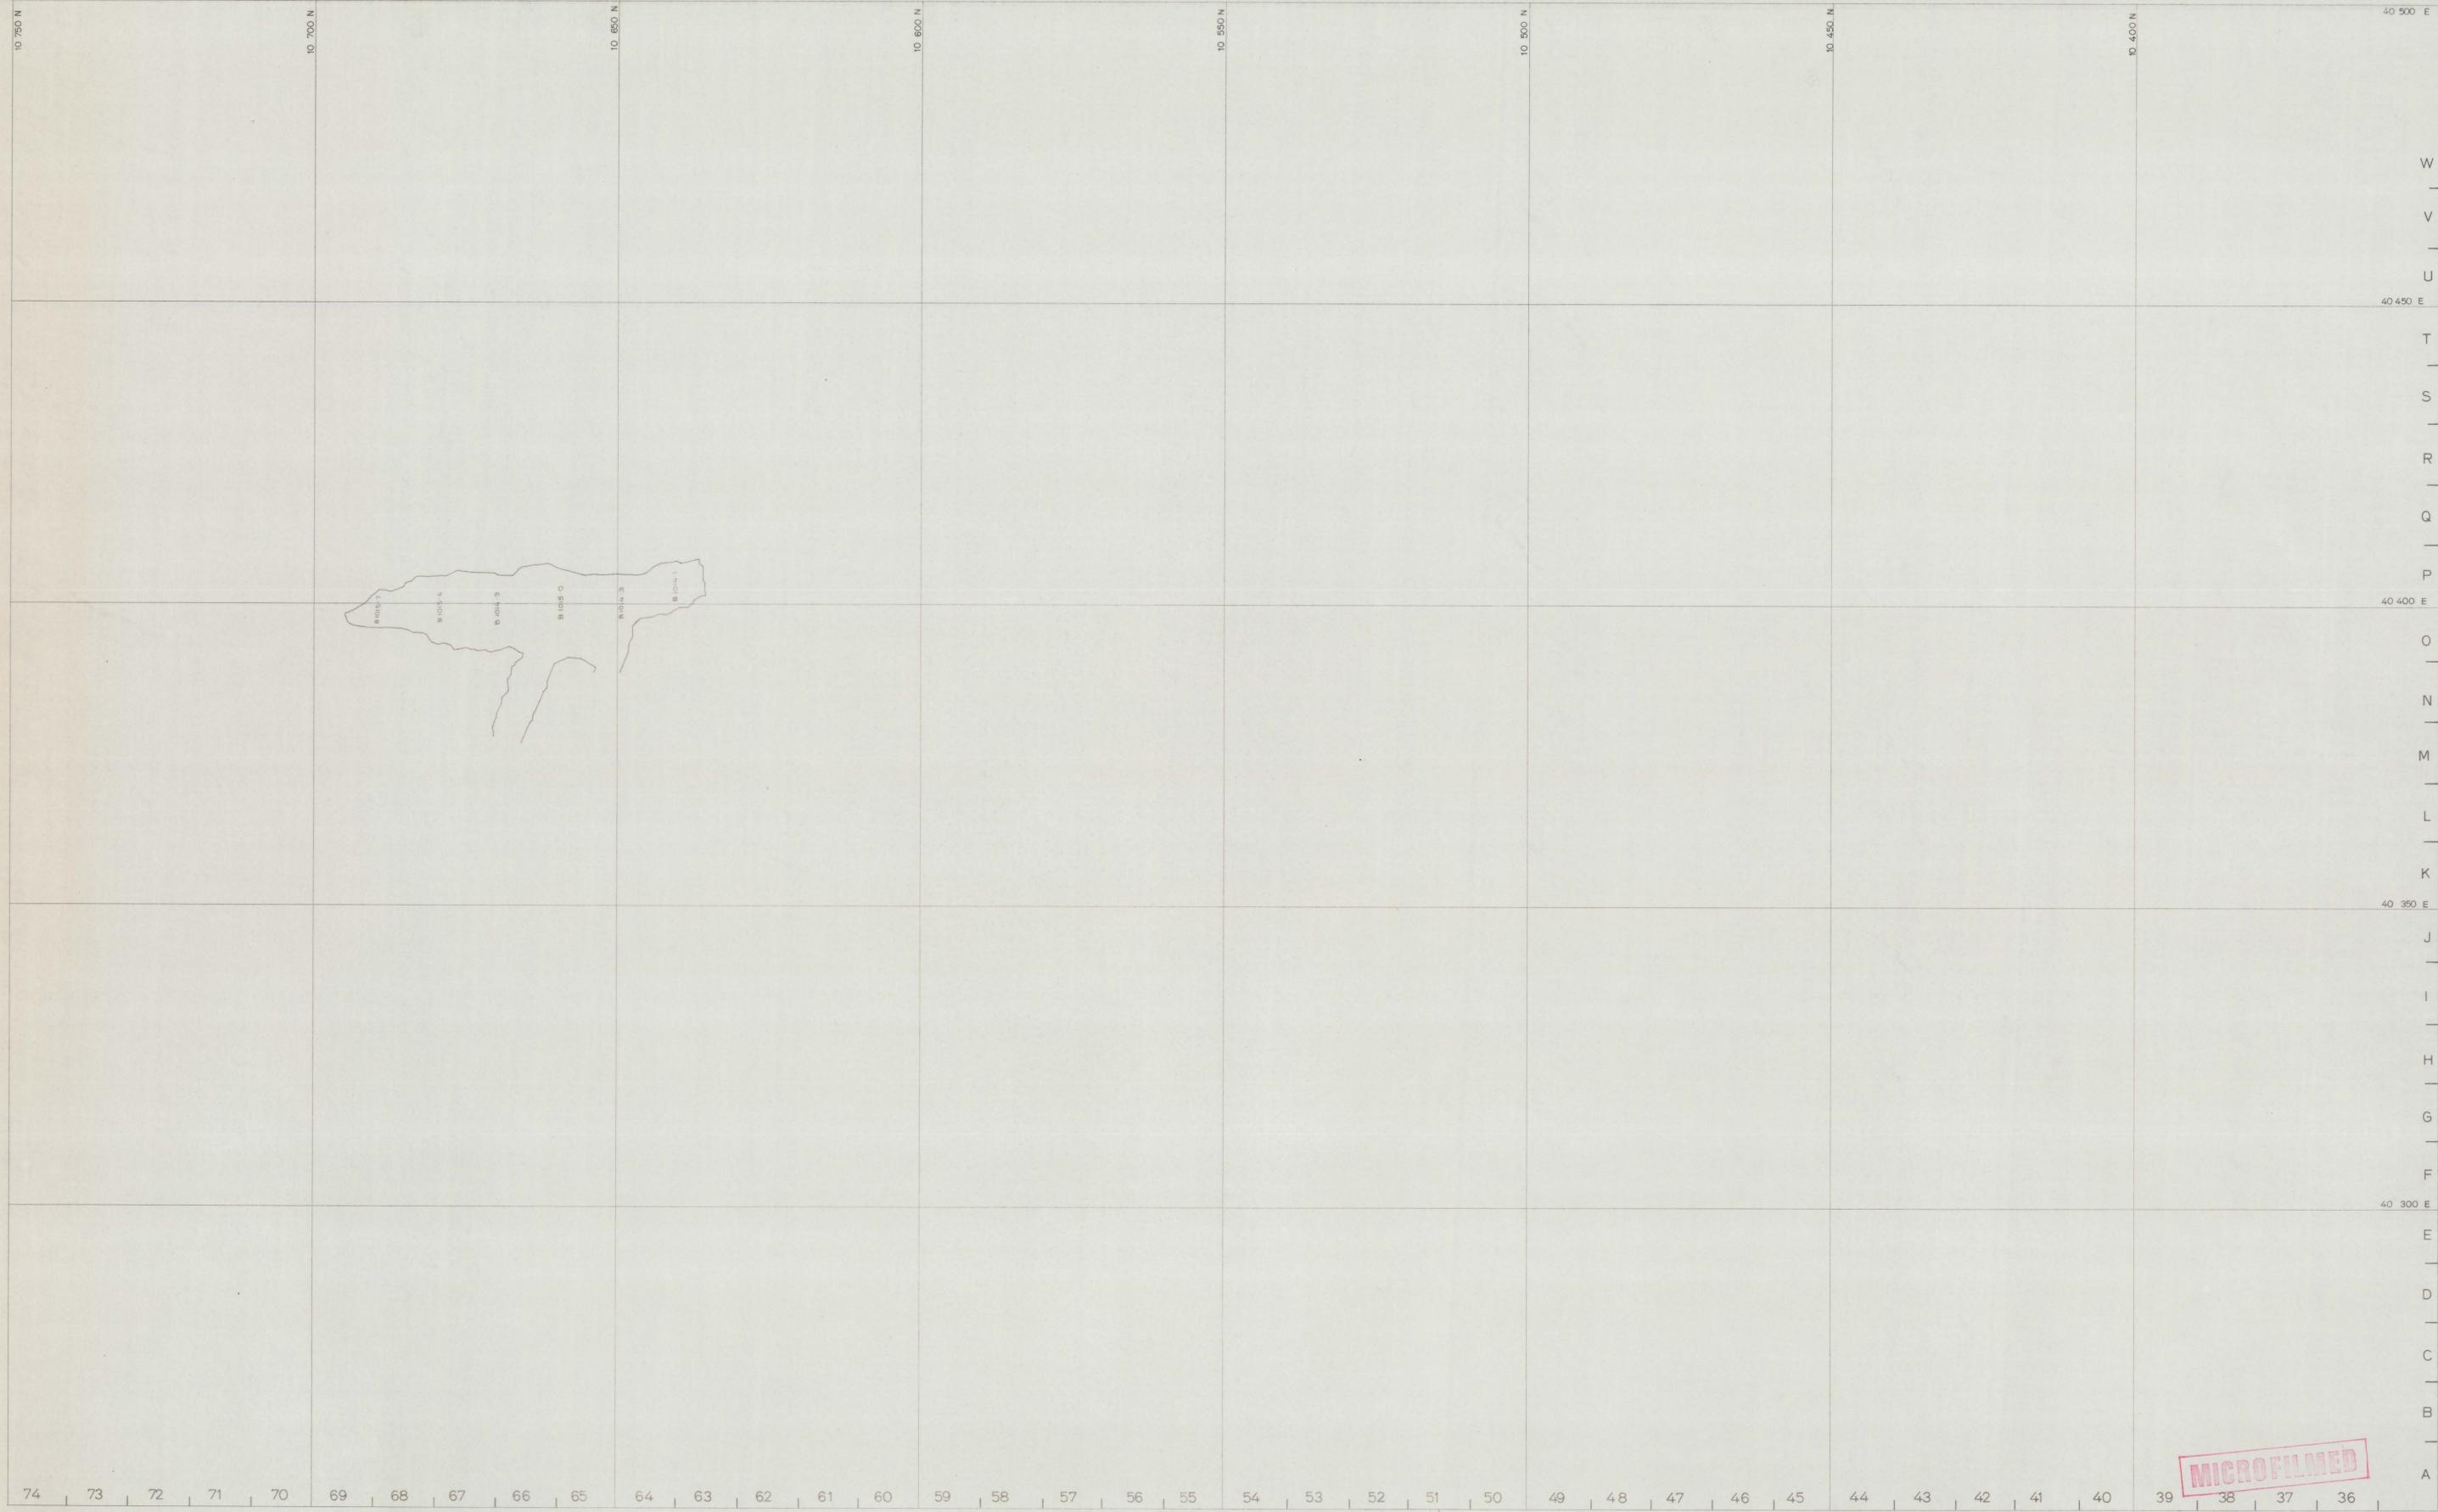


0374_589

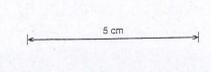

MICROFILMED

	SCALE 1 500	north	LOCATION BOLD HEAD MINE	 KING ISLAND SCHEELITE A DIVISION OF WARMAN INTERNATIONAL GRASSY KING ISLAND
			SUBJECT P 62 STOPE [3rd Lift]	