


0374\_593

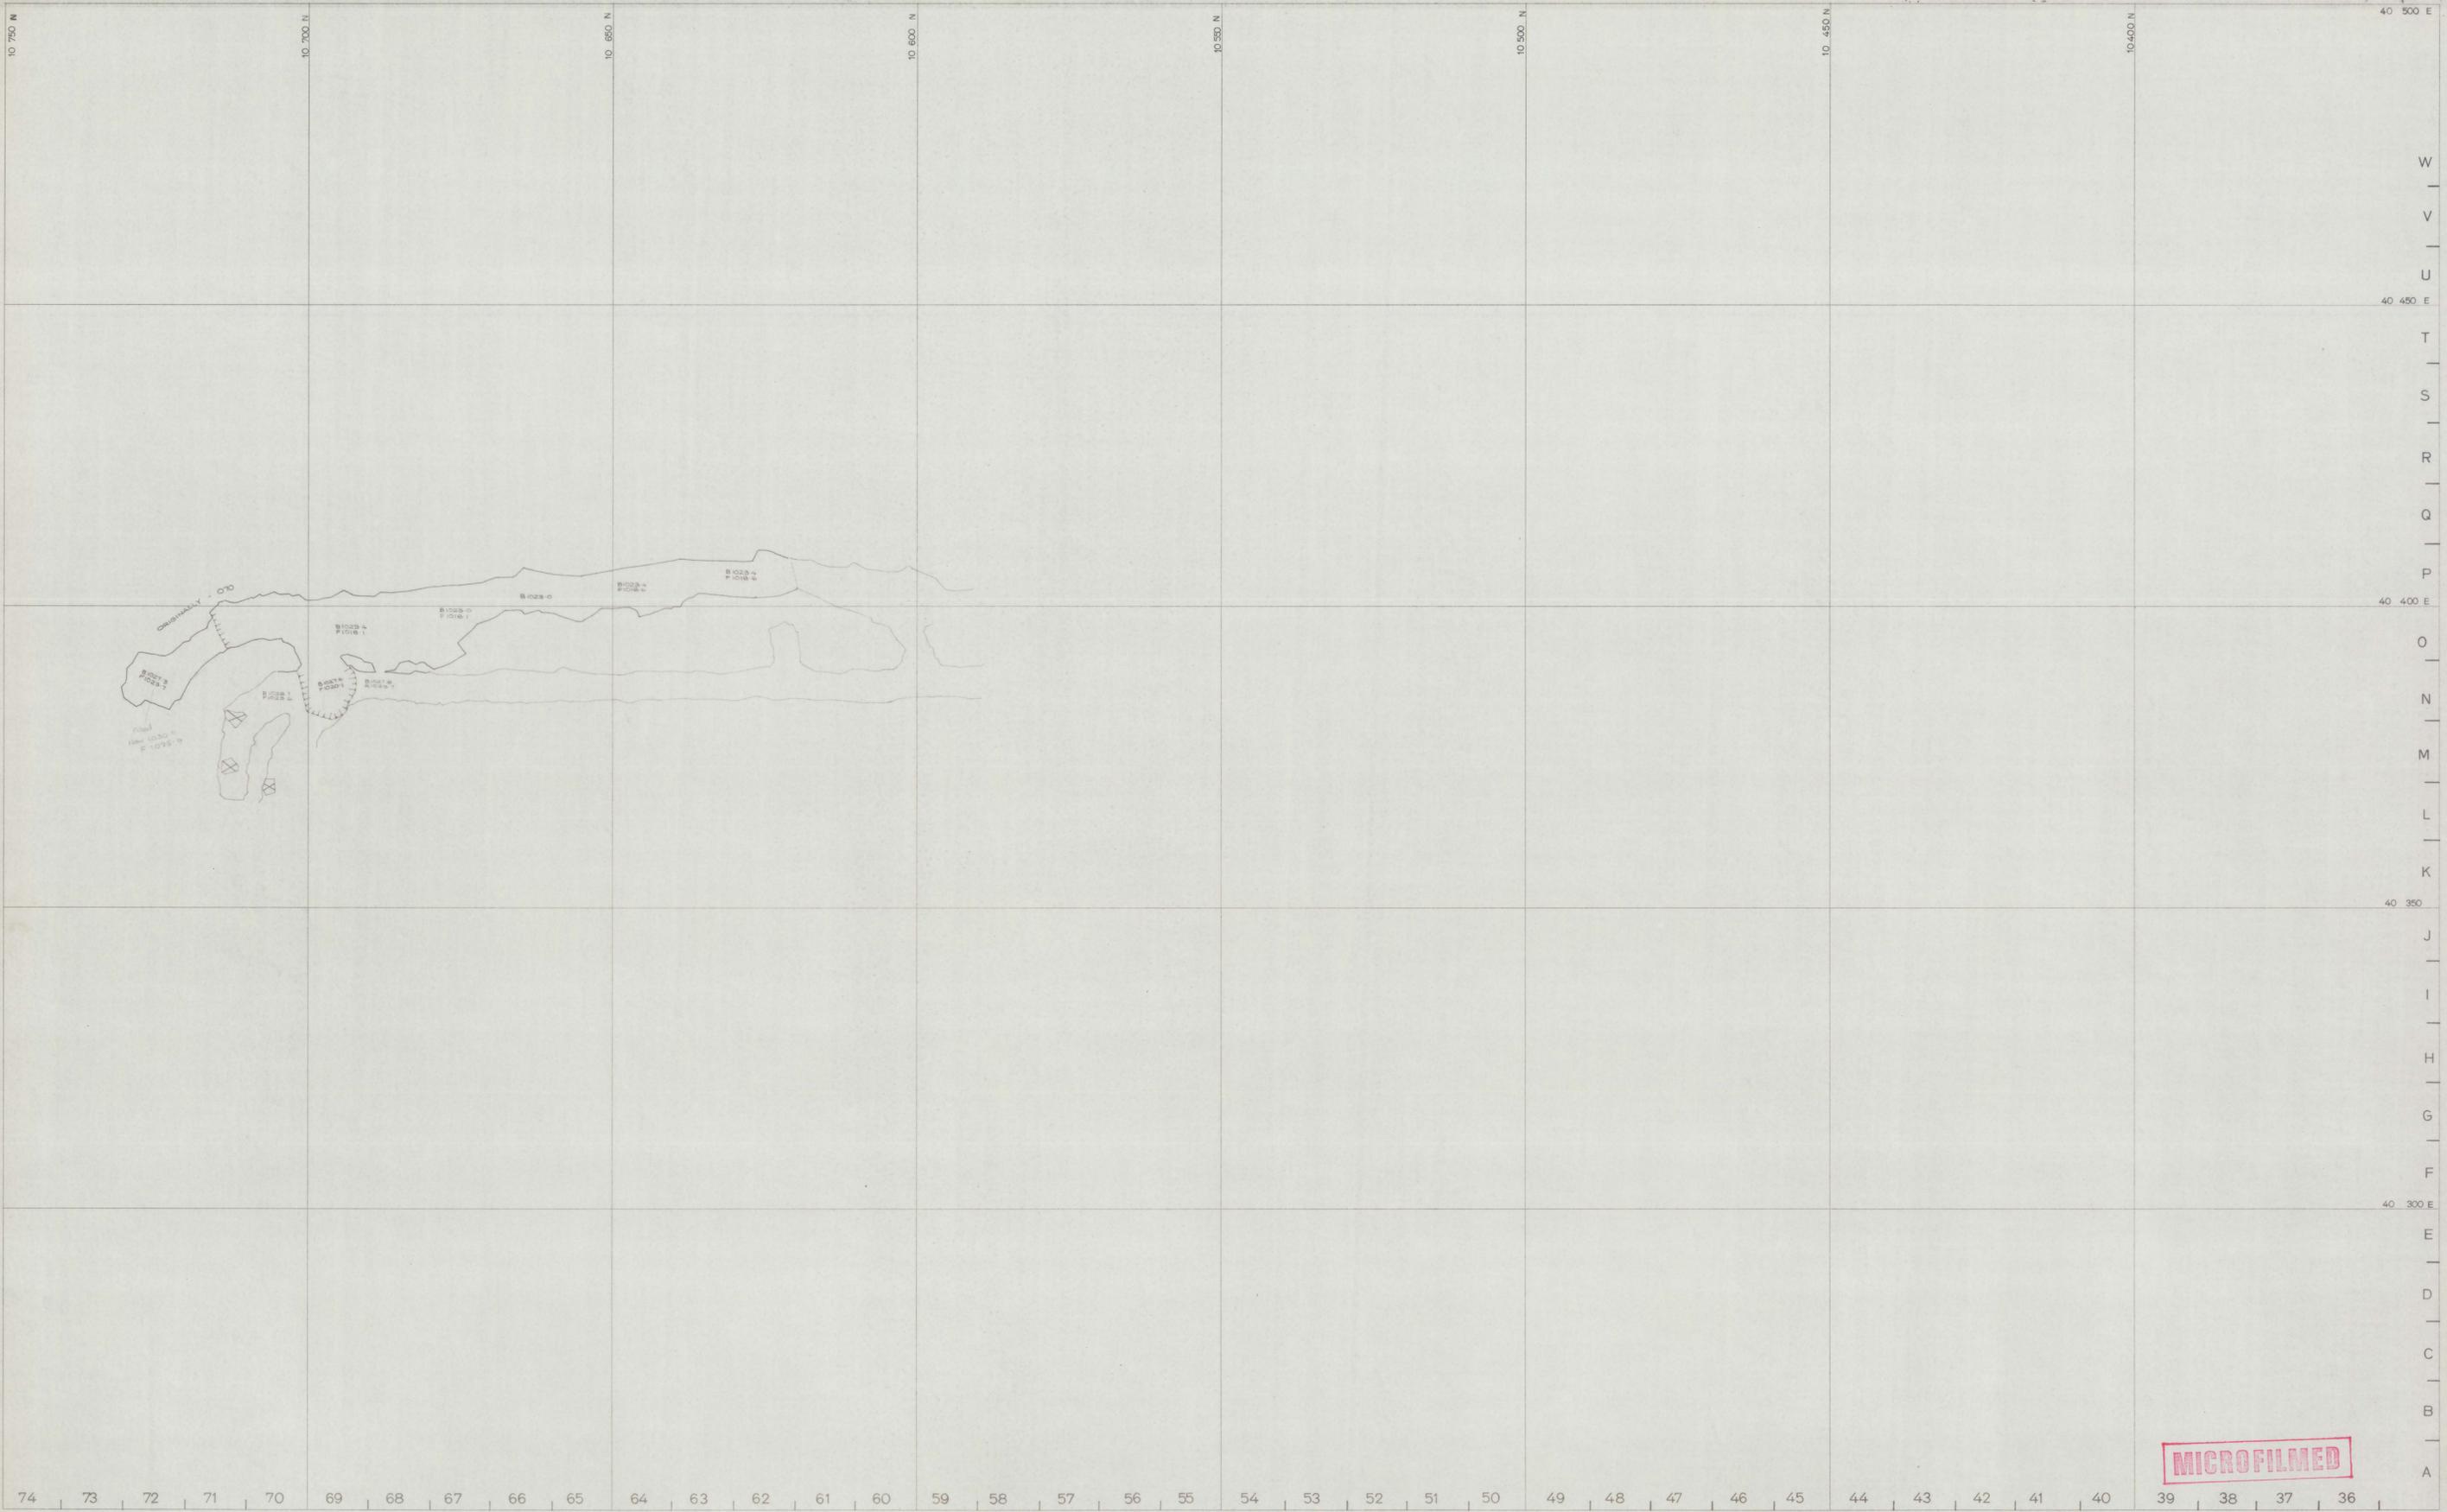

MICROFILMED

|             |  |             |                         |
|-------------|--|-------------|-------------------------|
| SCALE 1 500 |  | LOCATION    | BOLD HEAD MINE          |
| 5 cm        |  | SUBJECT     | P62 STOPE<br>[6th Lift] |
| north       |  |             |                         |
|             |  | PLAN NUMBER | 04BH15- 1011            |
|             |  |             | 8/059                   |