


0374_597

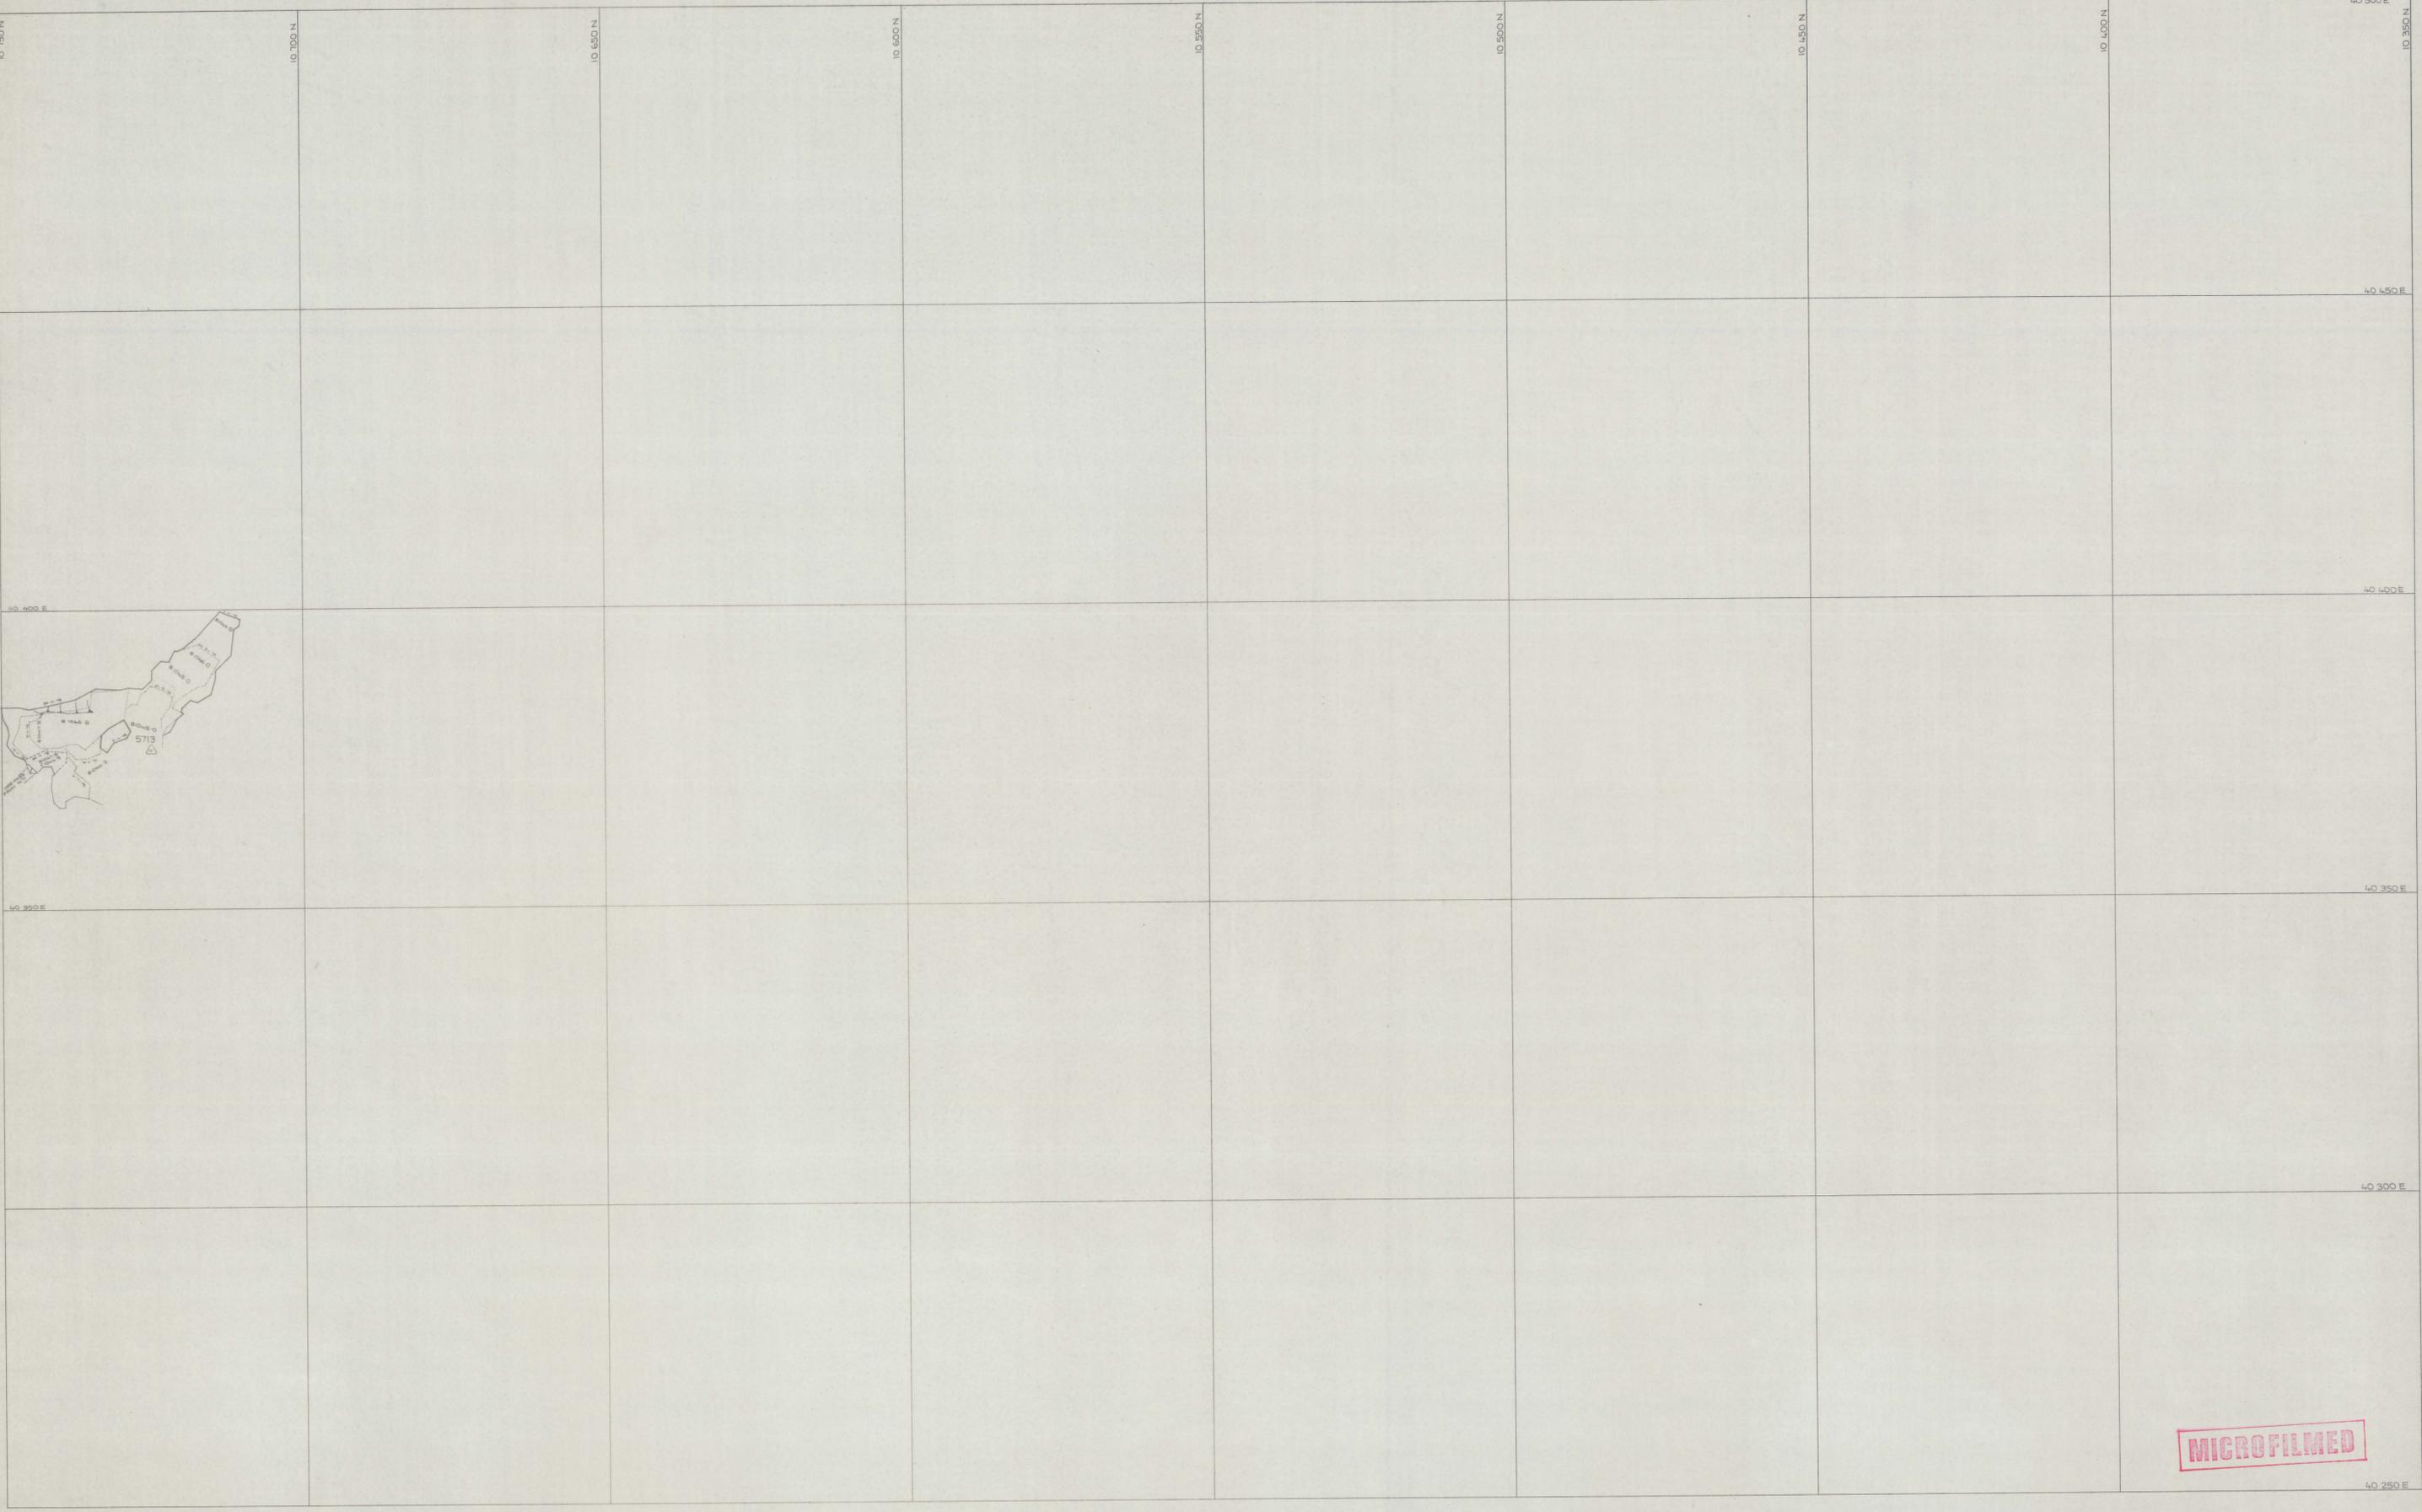

SCALE 1:500

5 cm

north

LOCATION BOLD HEAD MINE

SUBJECT P 70 STOPE
[3rd lift]

KIS KING ISLAND SCHEELITE
A DIVISION OF WARMAN INTERNATIONAL

GRASSY KING ISLAND

PLAN NUMBER 04BH15 - 1015

81063