


0374_599

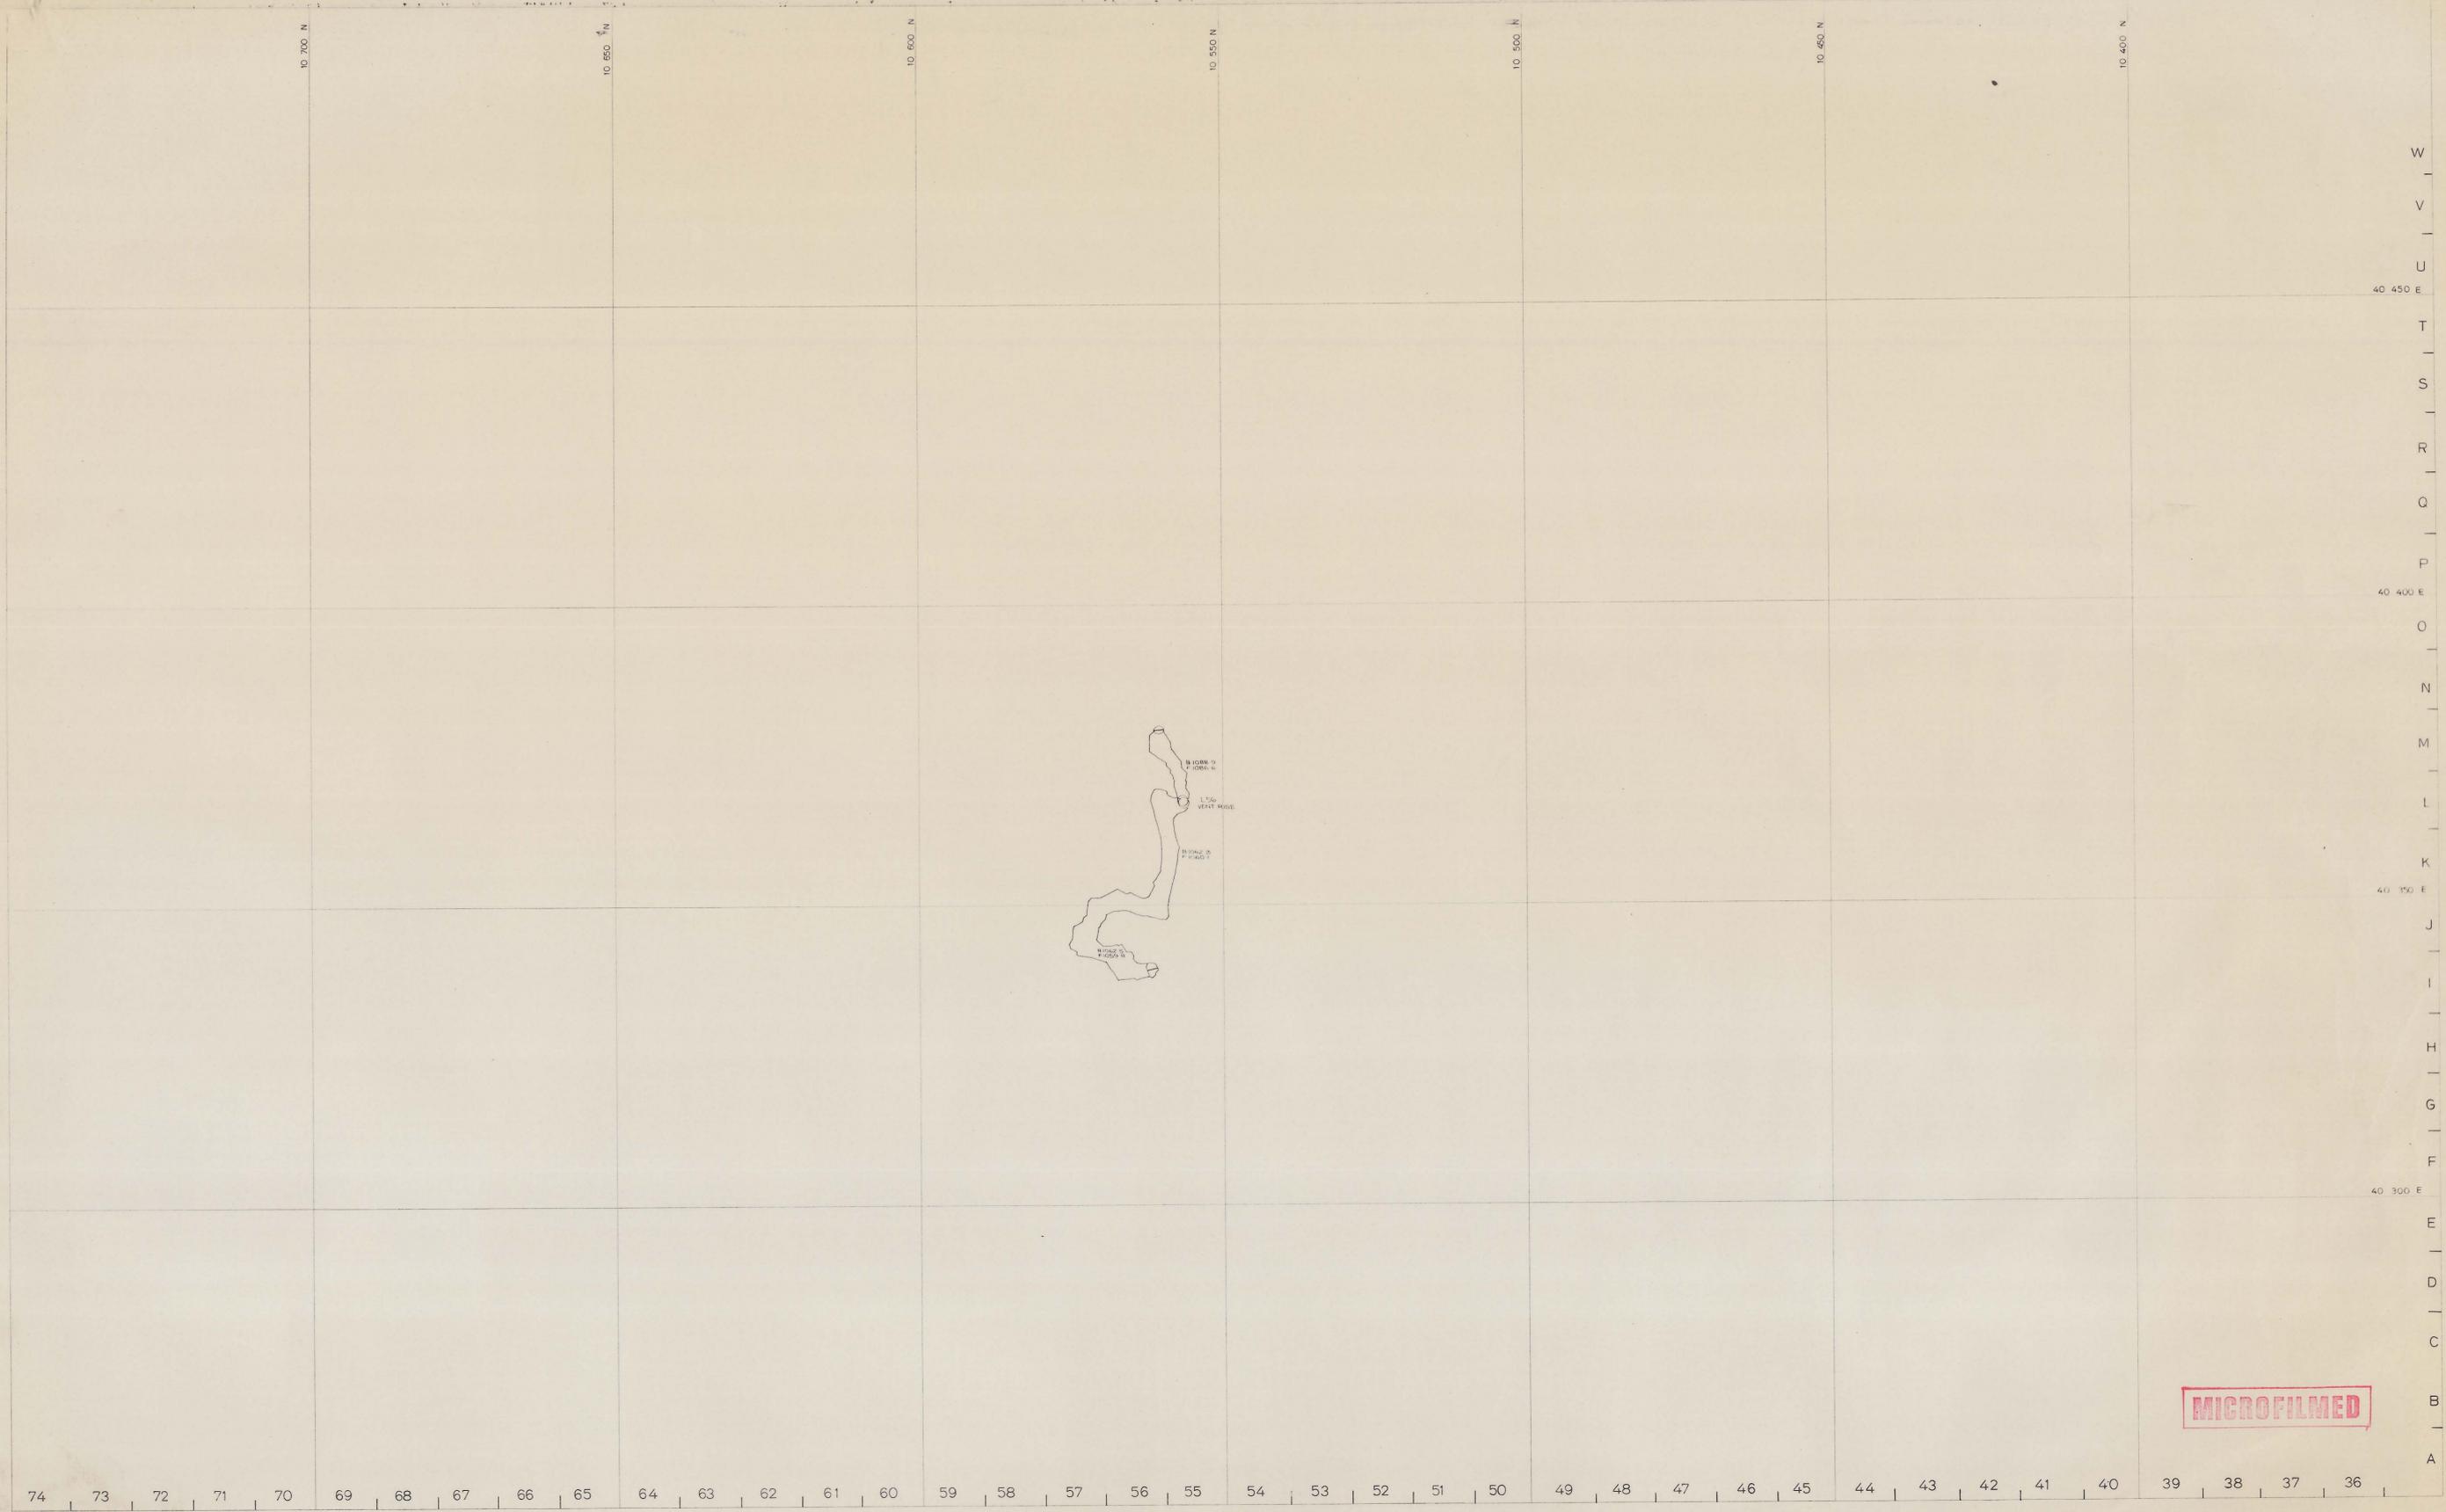

W
 V
 U
 40 450 E
 T
 S
 R
 Q
 P
 40 400 E
 O
 N
 M
 L
 K
 40 350 E
 J
 I
 H
 G
 F
 40 300 E
 E
 D
 C
 B
 A

74 73 72 71 70 69 68 67 66 65 64 63 62 61 60 59 58 57 56 55 54 53 52 51 50 49 48 47 46 45 44 43 42 41 40 39 38 37 36

MICROFILMED

| | | | | |
|--|-------------|----------|----------------|-------------|
| | SCALE 1 500 | LOCATION | BOLD HEAD MINE | |
| | 5 cm | SUBJECT | | |
| | | | | PLAN NUMBER |

81036