



SEE PLAN SUBMIT 1002

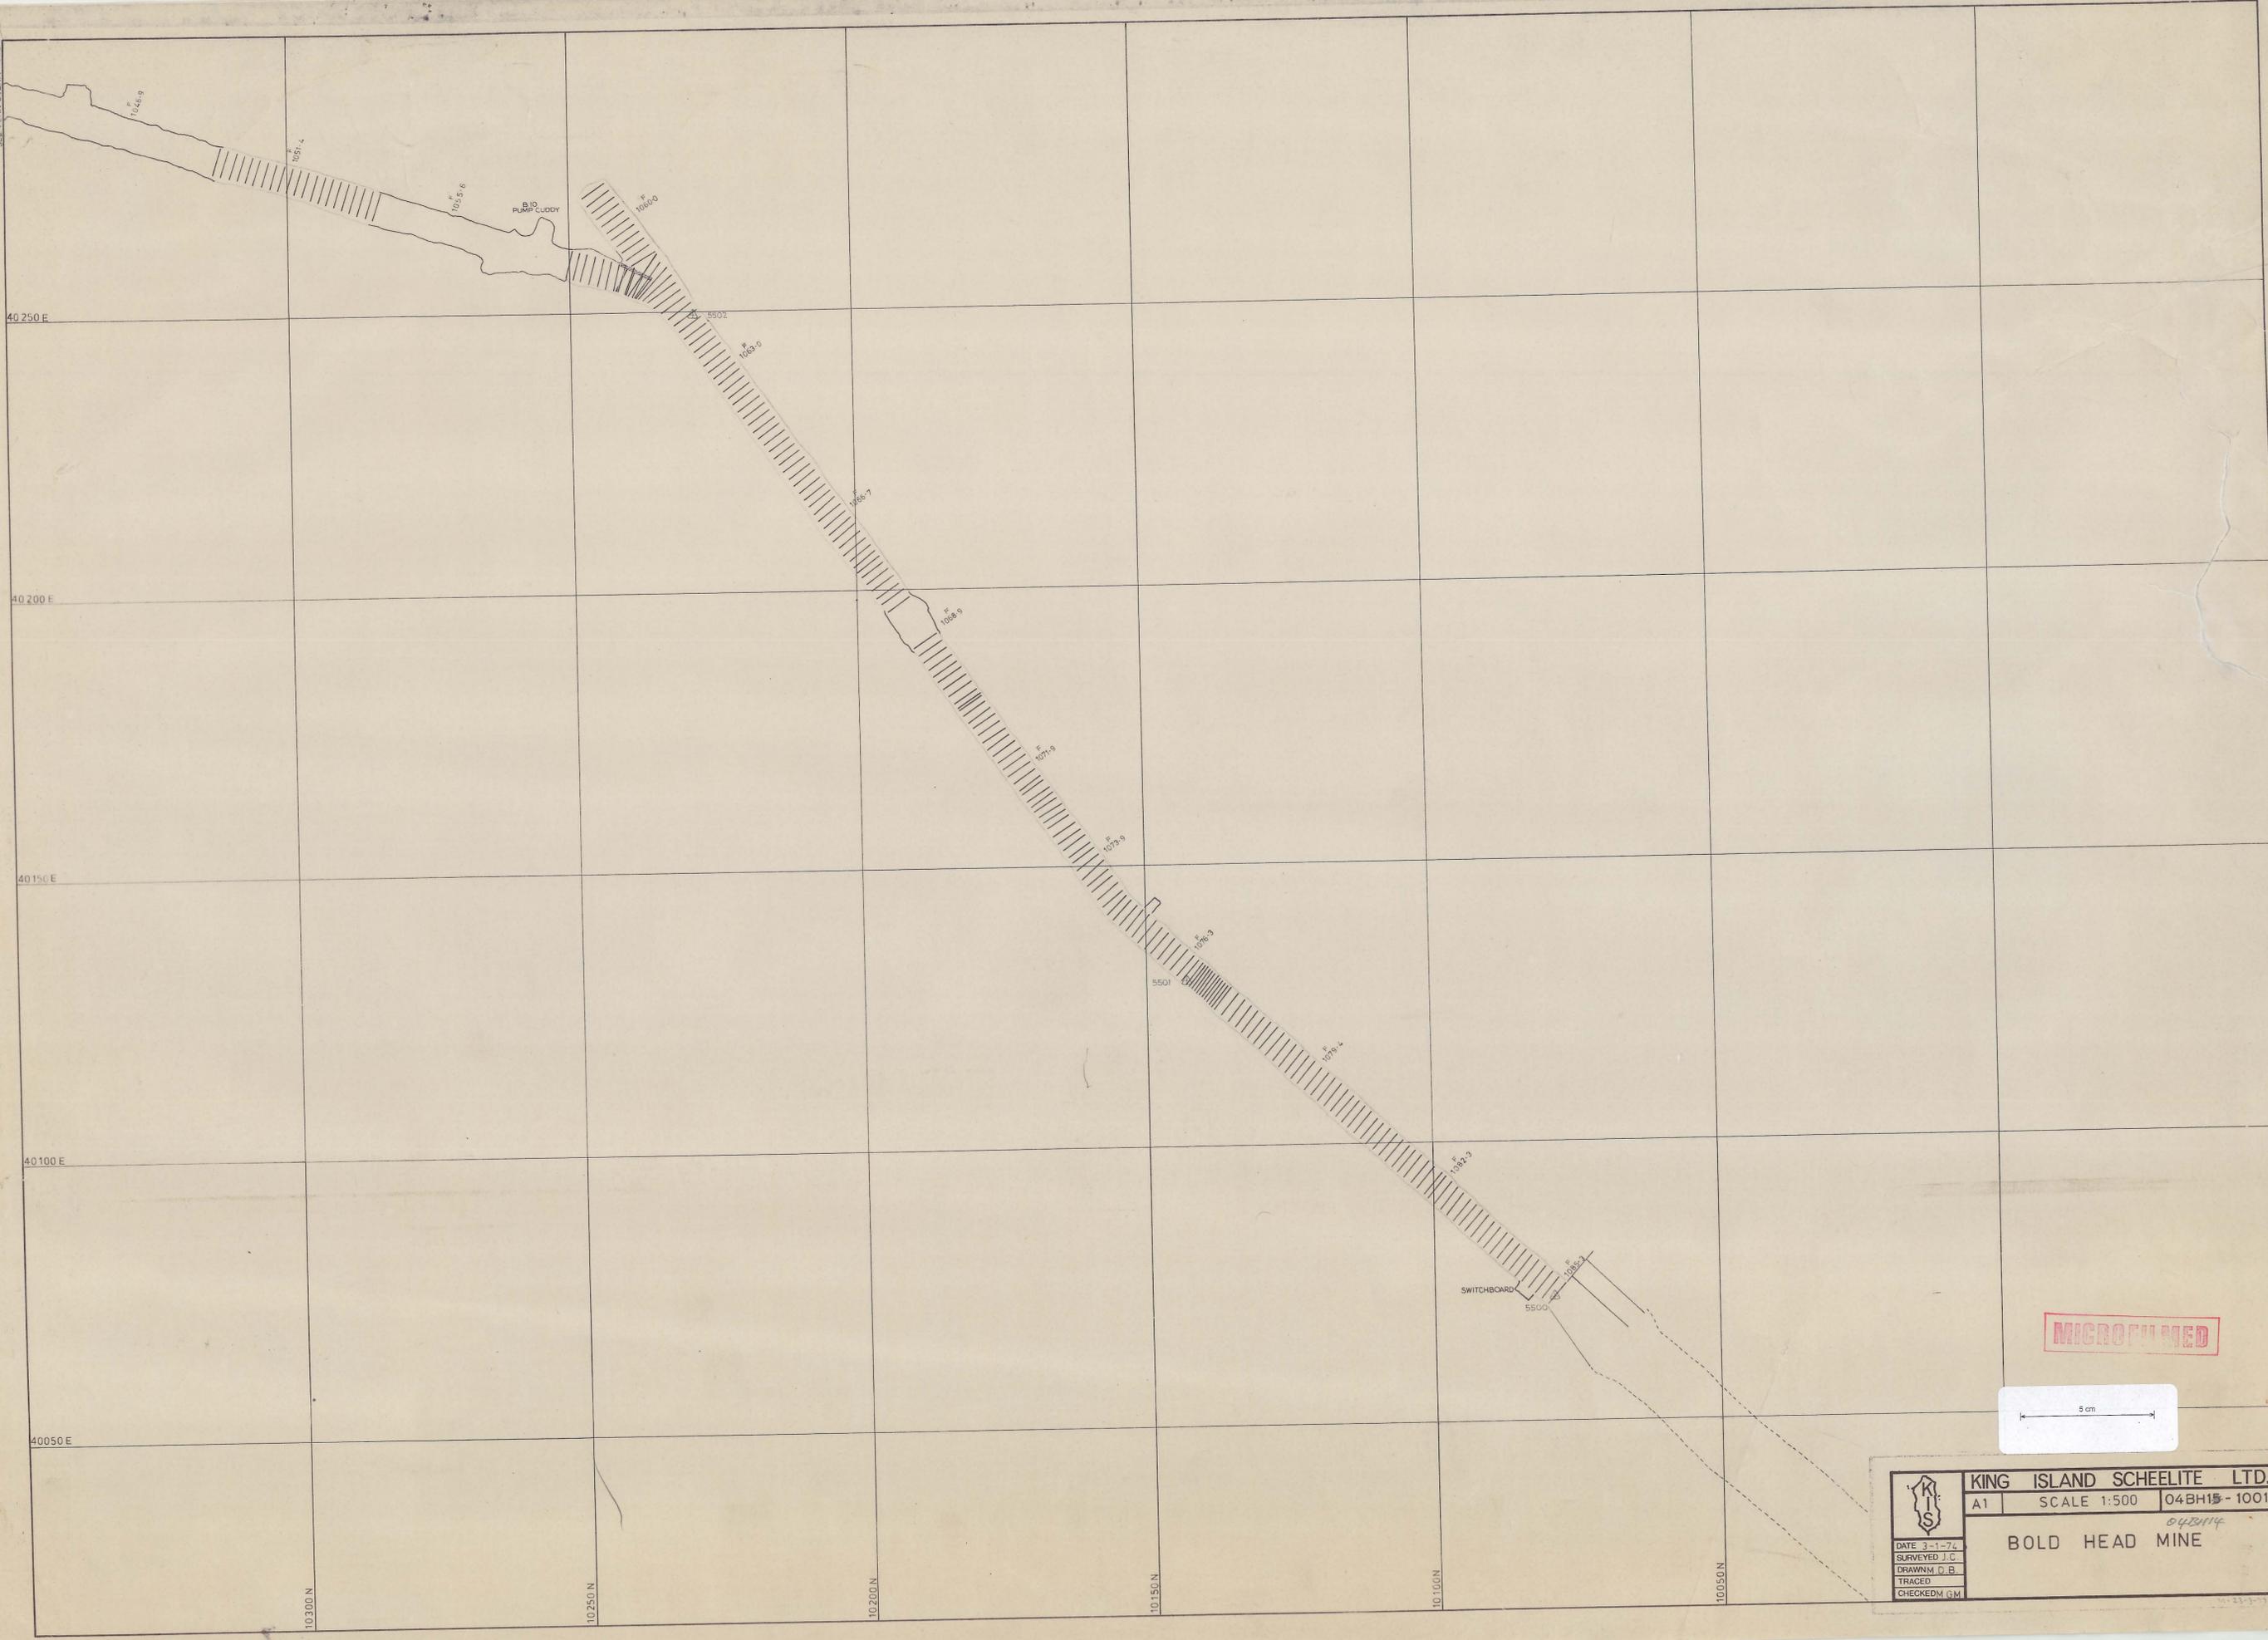

0374\_600

MICROFILMED

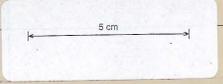

	KING ISLAND SCHEELITE LTD.	
	A1	SCALE 1:500 04BH15-1001
BOLD HEAD MINE <i>0423114</i>		
DATE 3-1-74 SURVEYED J.C. DRAWN M.D.B. TRACED CHECKED M.G.M.		