
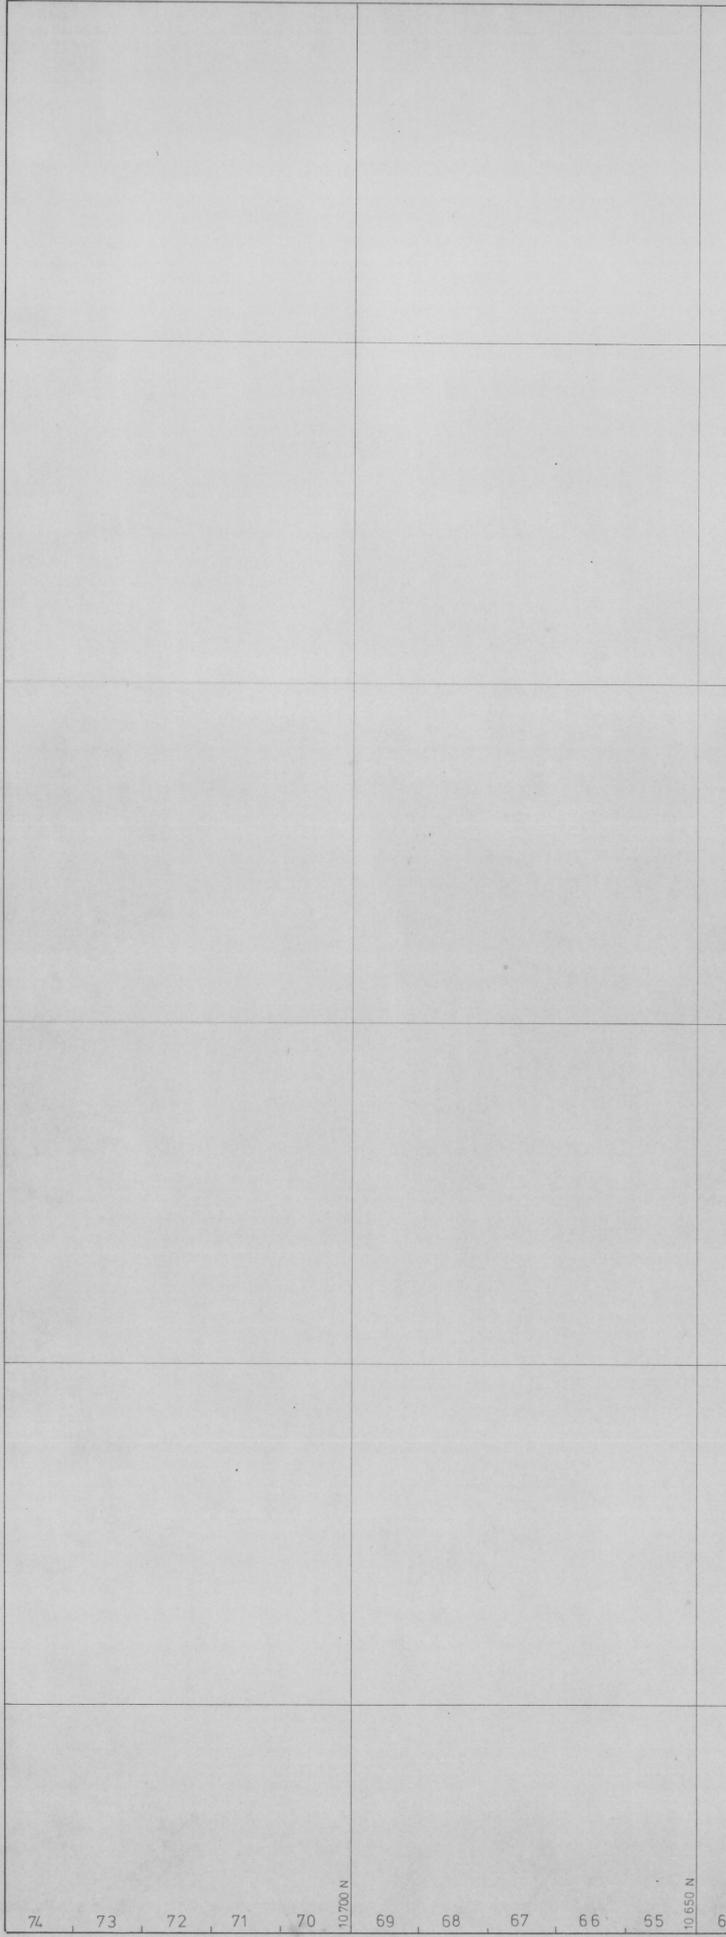


W  
V  
U  
40 450E  
T  
S  
R  
Q  
P  
40 400E  
O  
N  
M  
L  
K  
40 350E  
J  
I  
H  
G  
F  
40 300E  
E  
D  
C  
B  
A  
40 250E

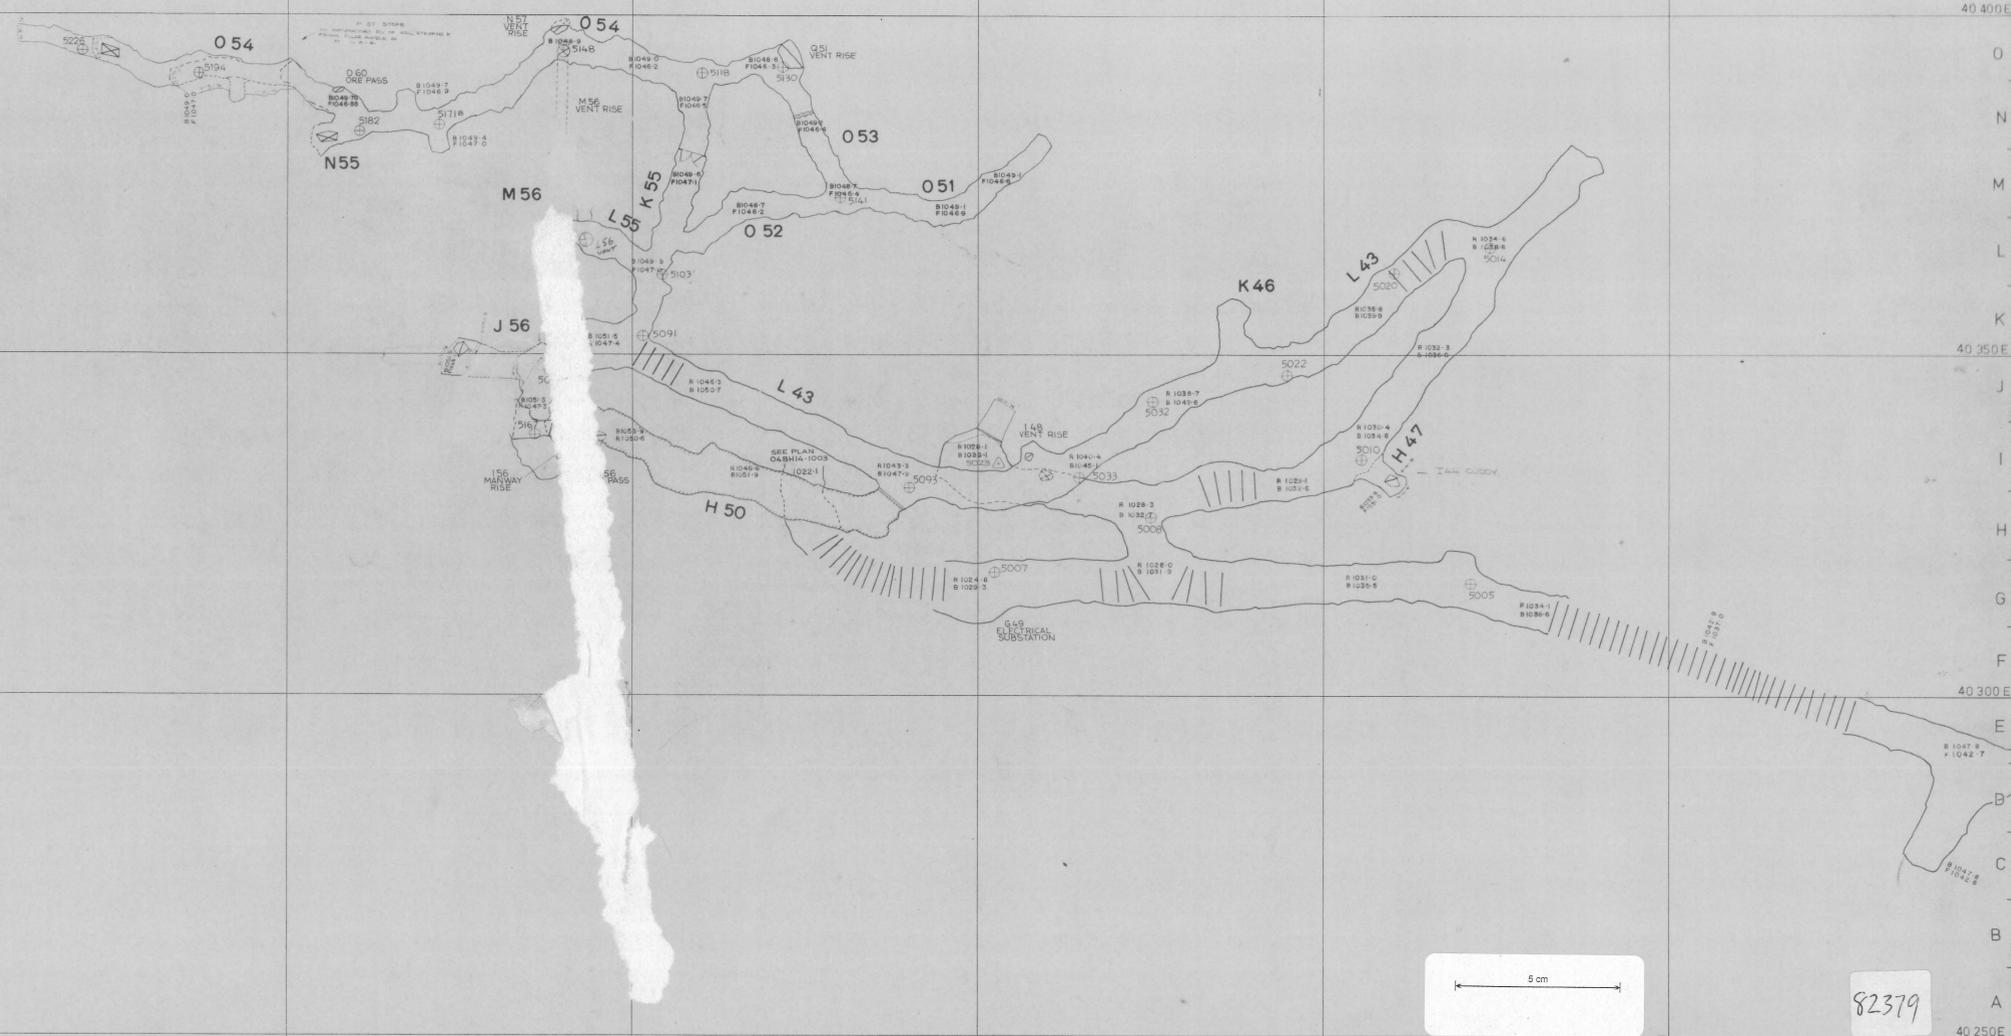

5 cm

82379

	KING ISLAND SCHEELITE	
	A1	SCALE 1:500
DATE 14-2-75		<b>BOLD HEAD MINE</b> 'A' LENS
SURVEYED J.C.		
DRAWN M.D.B.		
CHECKED M.G.M.		

0374\_603

9/1/02