
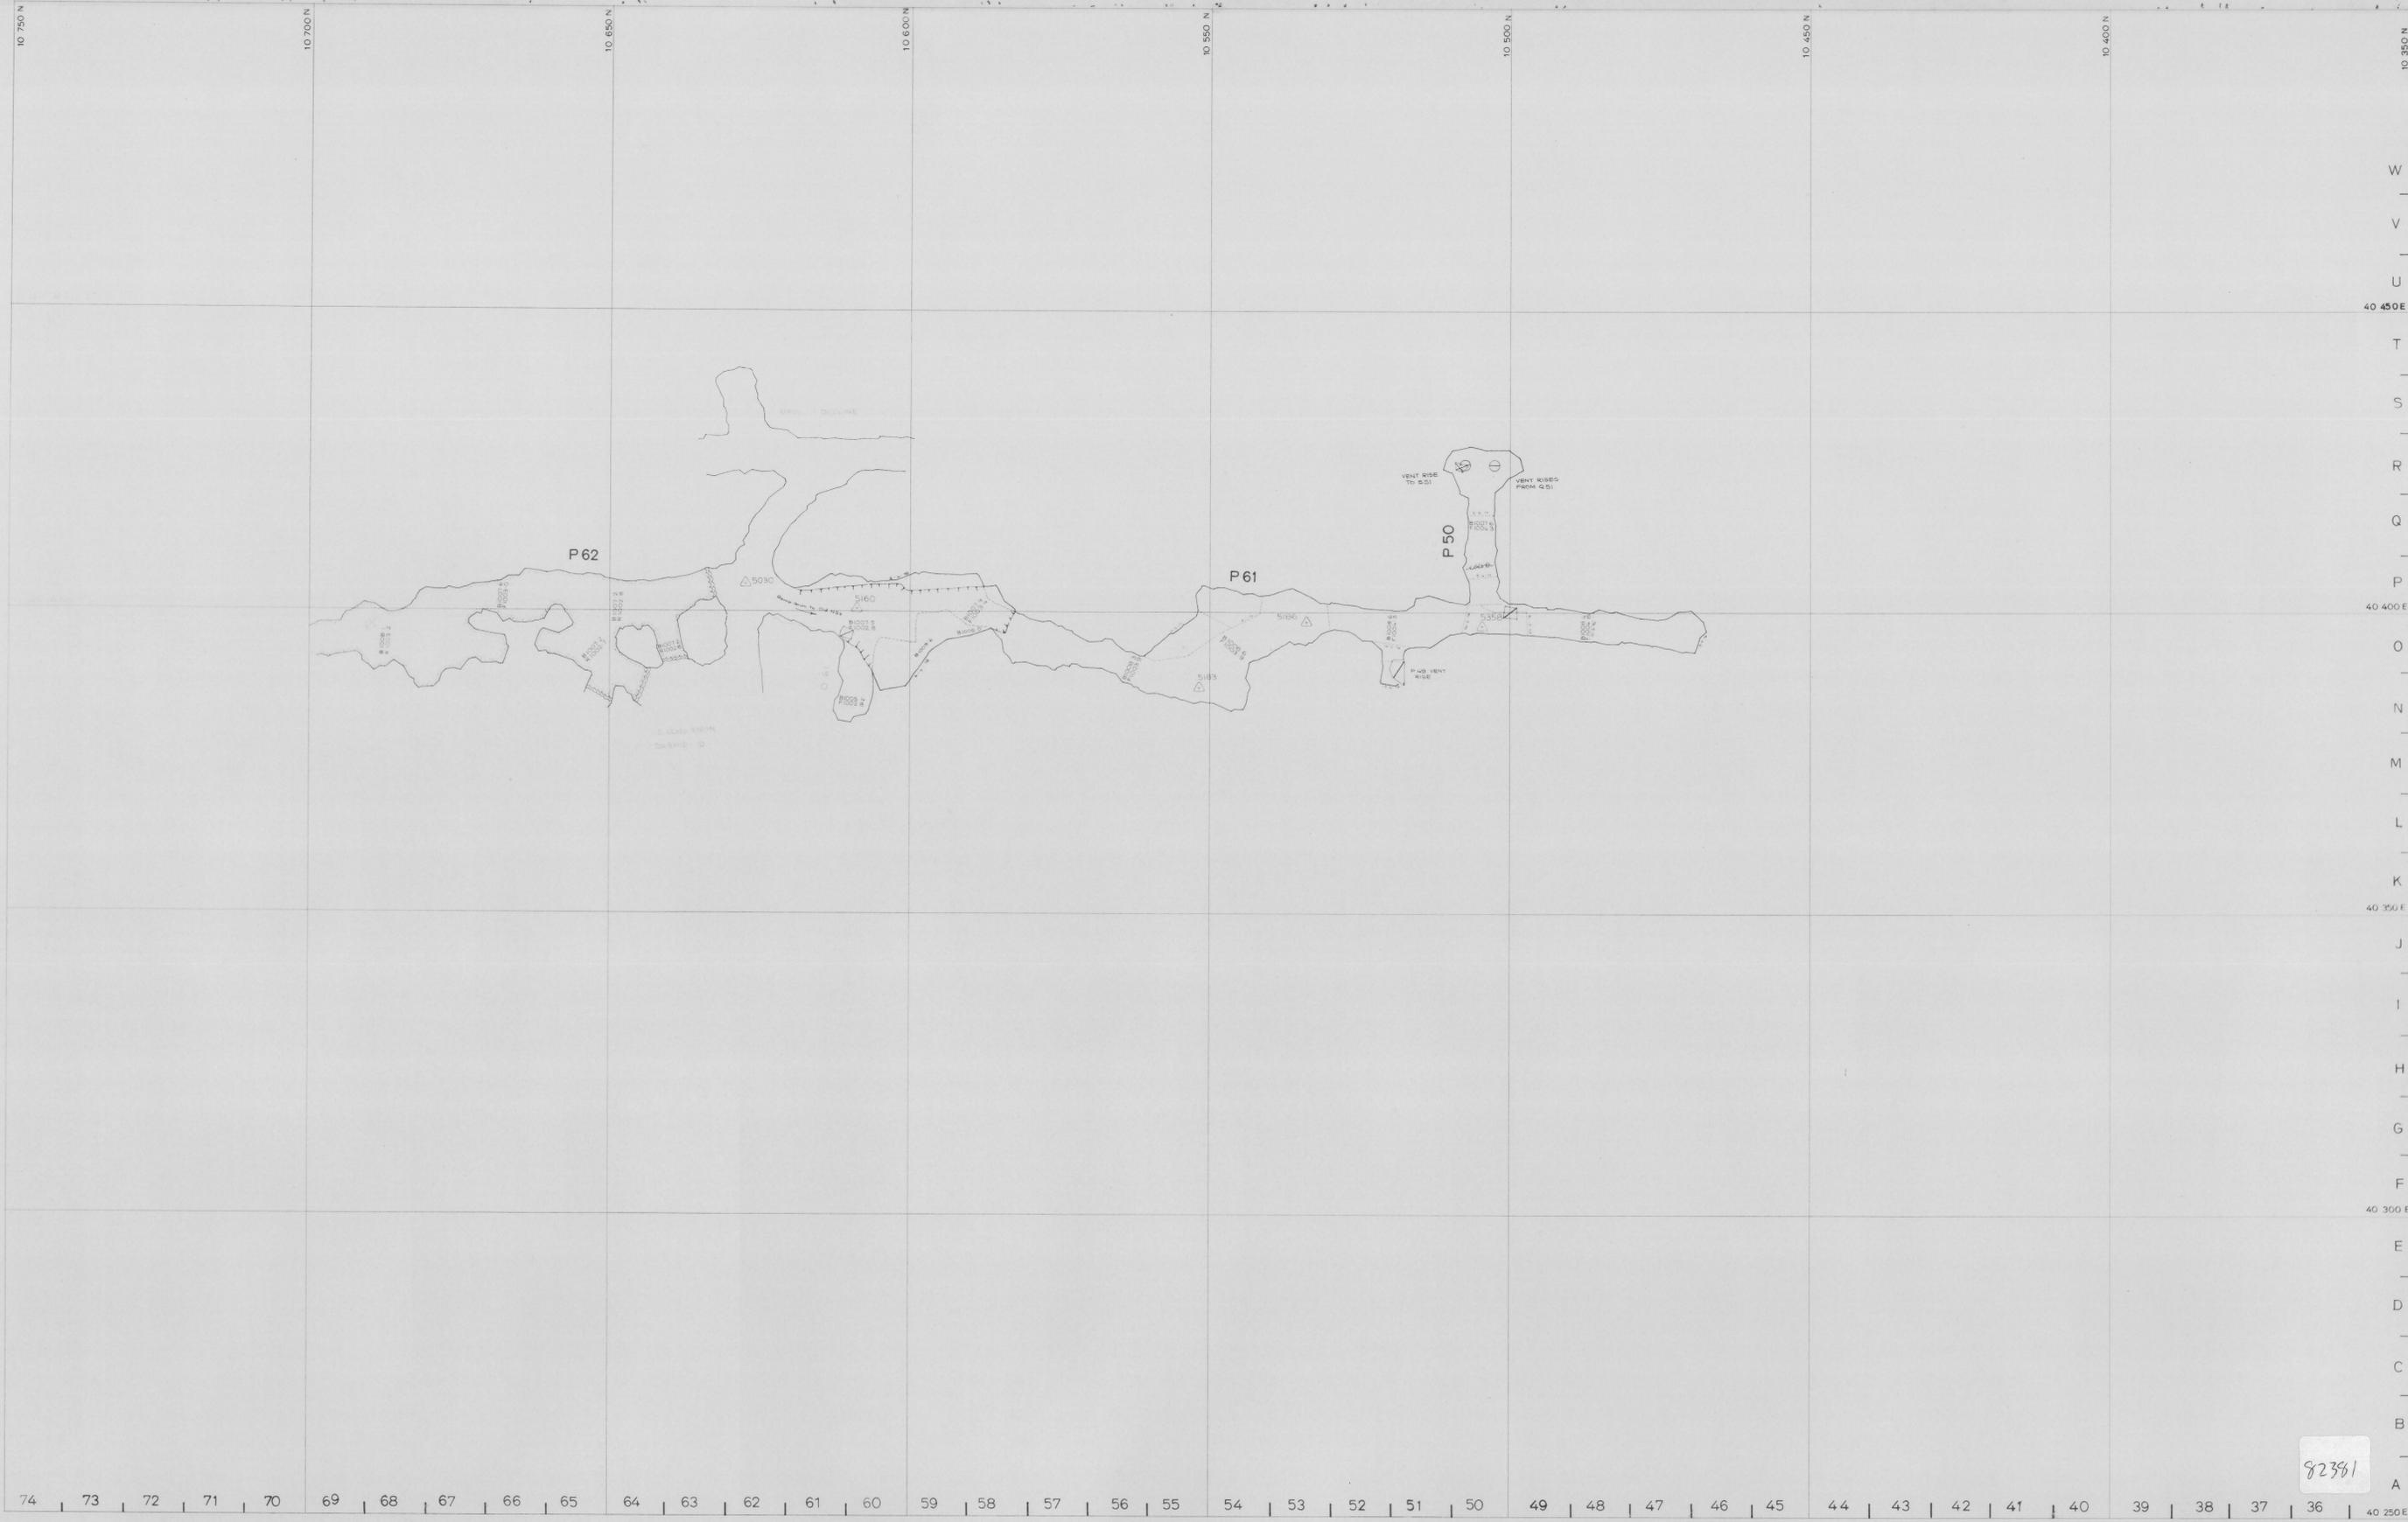


0374_626

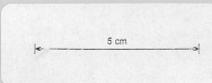

82381

SCALE 1:500 	LOCATION BOLD HEAD MINE	 GRASSY KING ISLAND PLAN NUMBER 04BH14 - 1004
	SUBJECT B. LENS FAULT BLOCK	
north		

Handwritten signature