
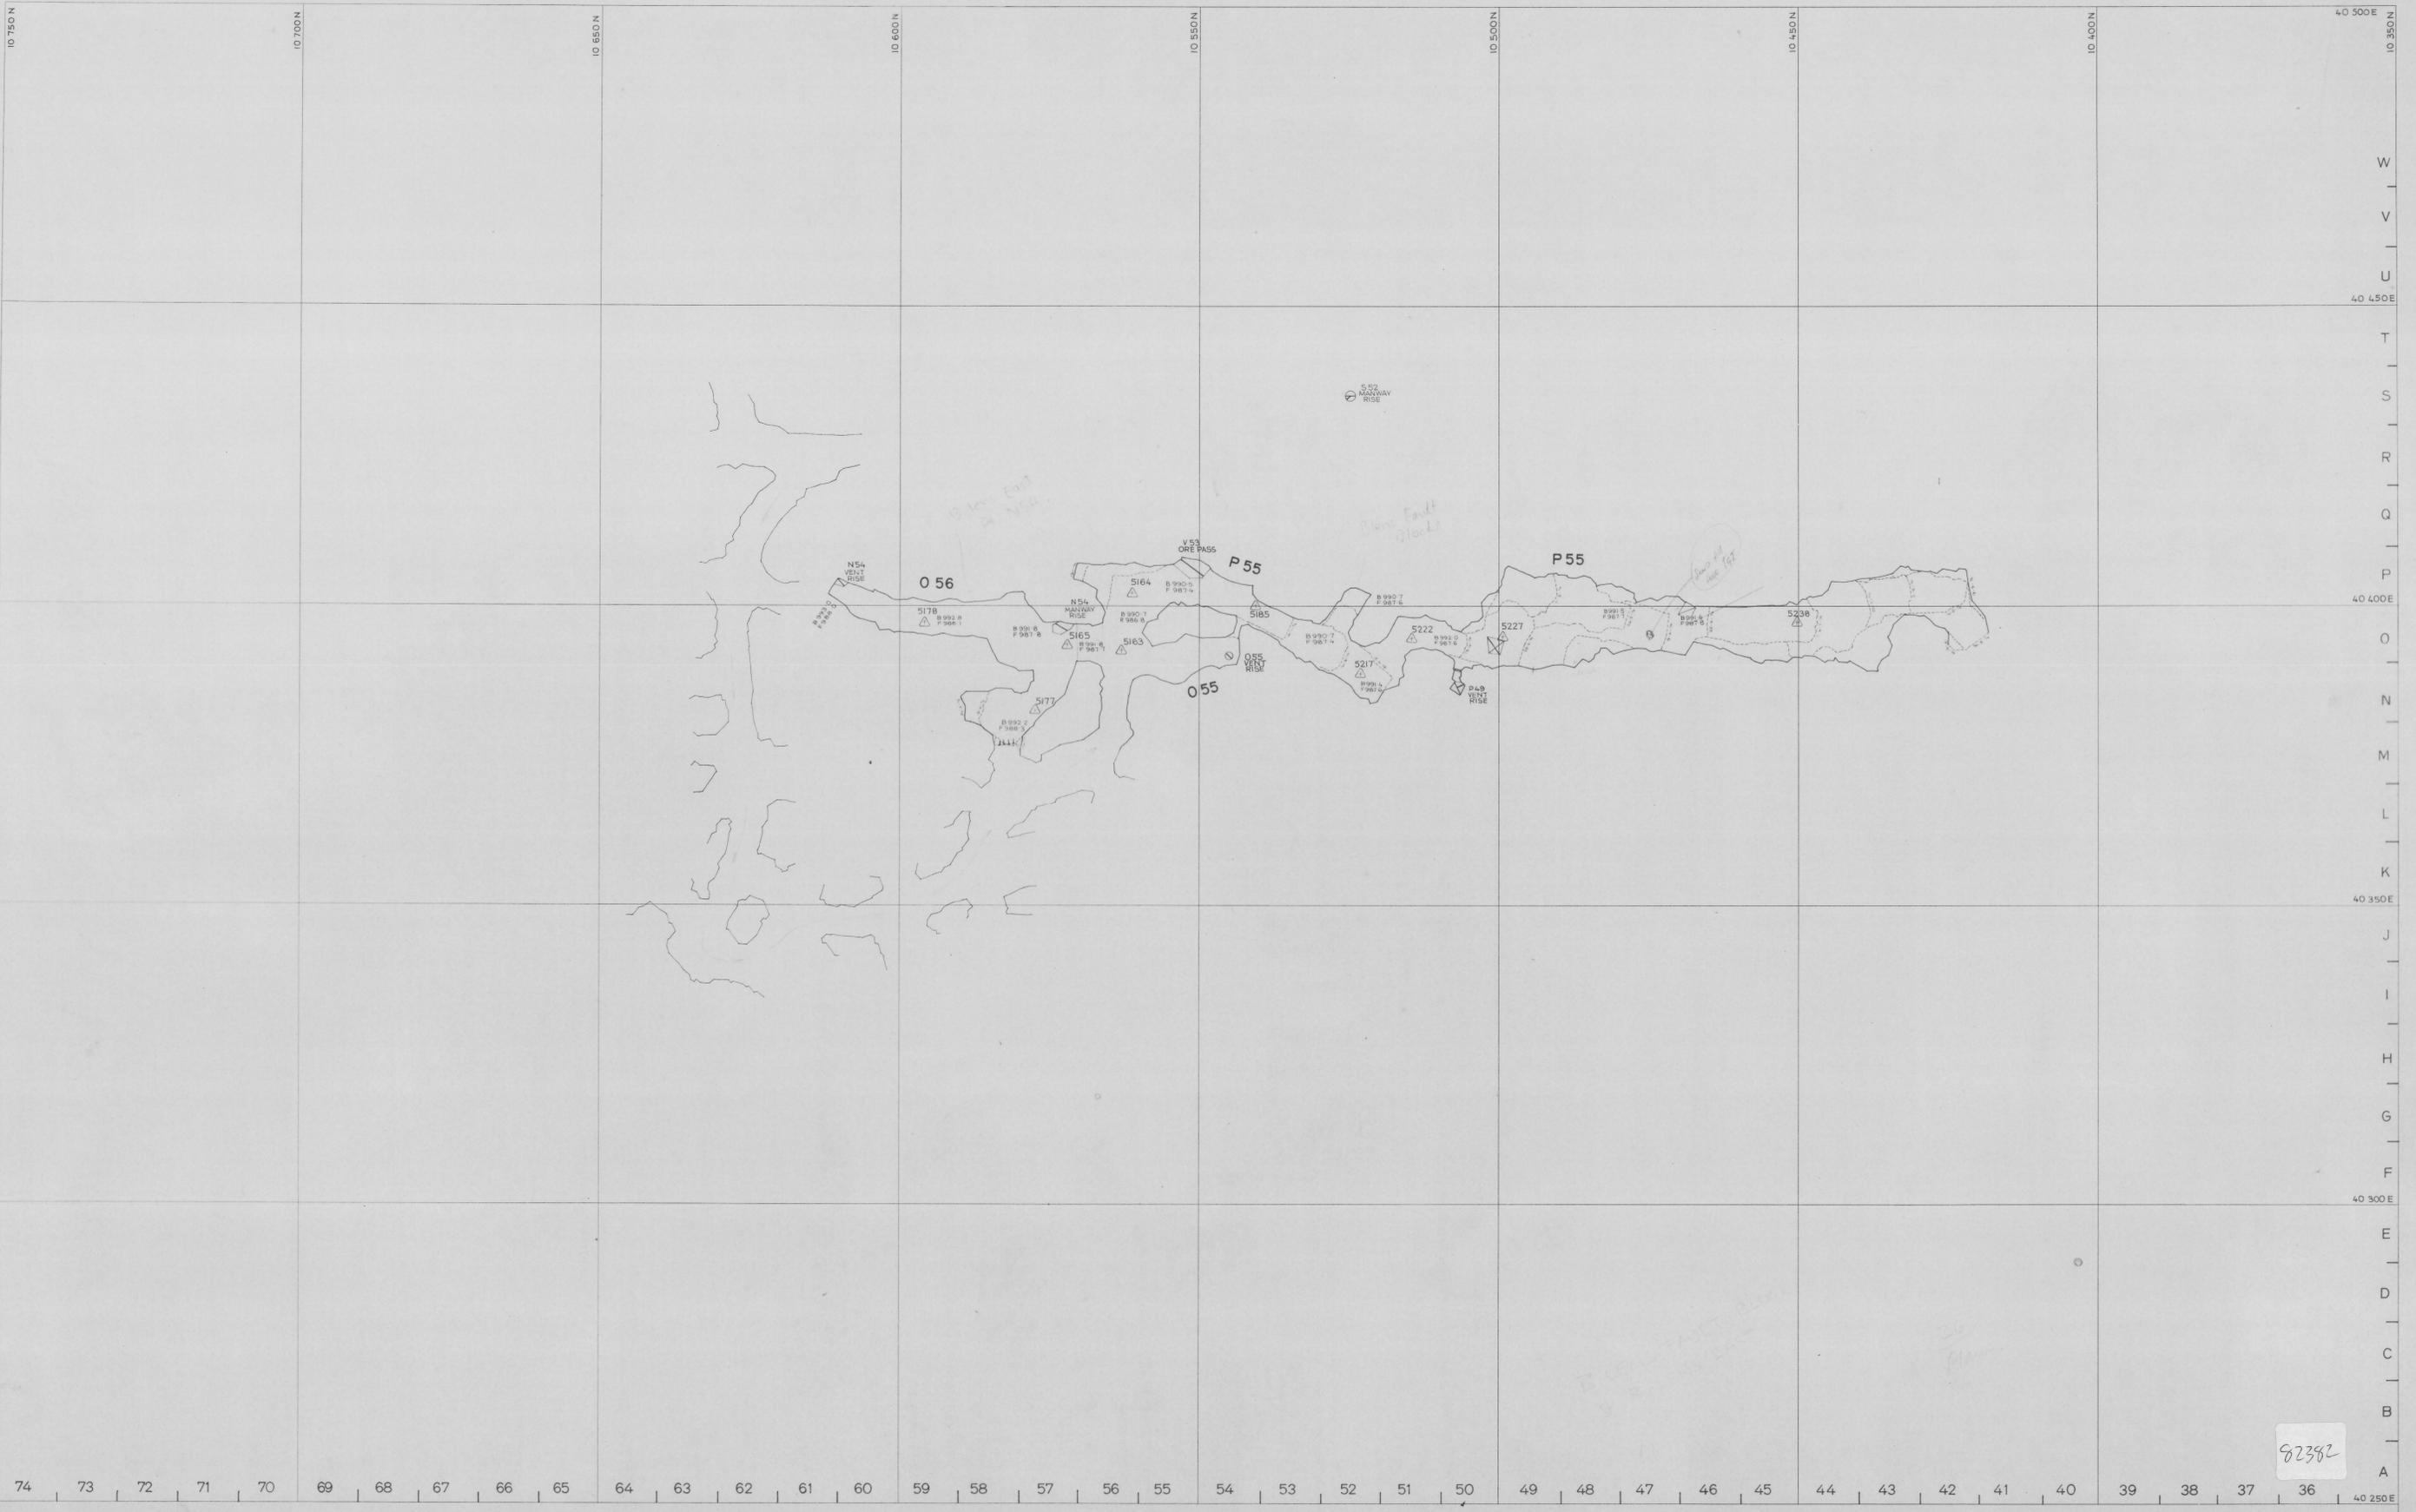


0374\_627

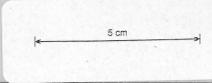

82382

74 73 72 71 70 69 68 67 66 65 64 63 62 61 60 59 58 57 56 55 54 53 52 51 50 49 48 47 46 45 44 43 42 41 40 39 38 37 36 40 250 E

SCALE 1:500		LOCATION BOLD HEAD MINE	
		SUBJECT B LENS FAULT BLOCK & B LENS EAST.	
north			
		GRASSY KING ISLAND	
		PLAN NUMBER 04BH14 - 1005	