



0374_631

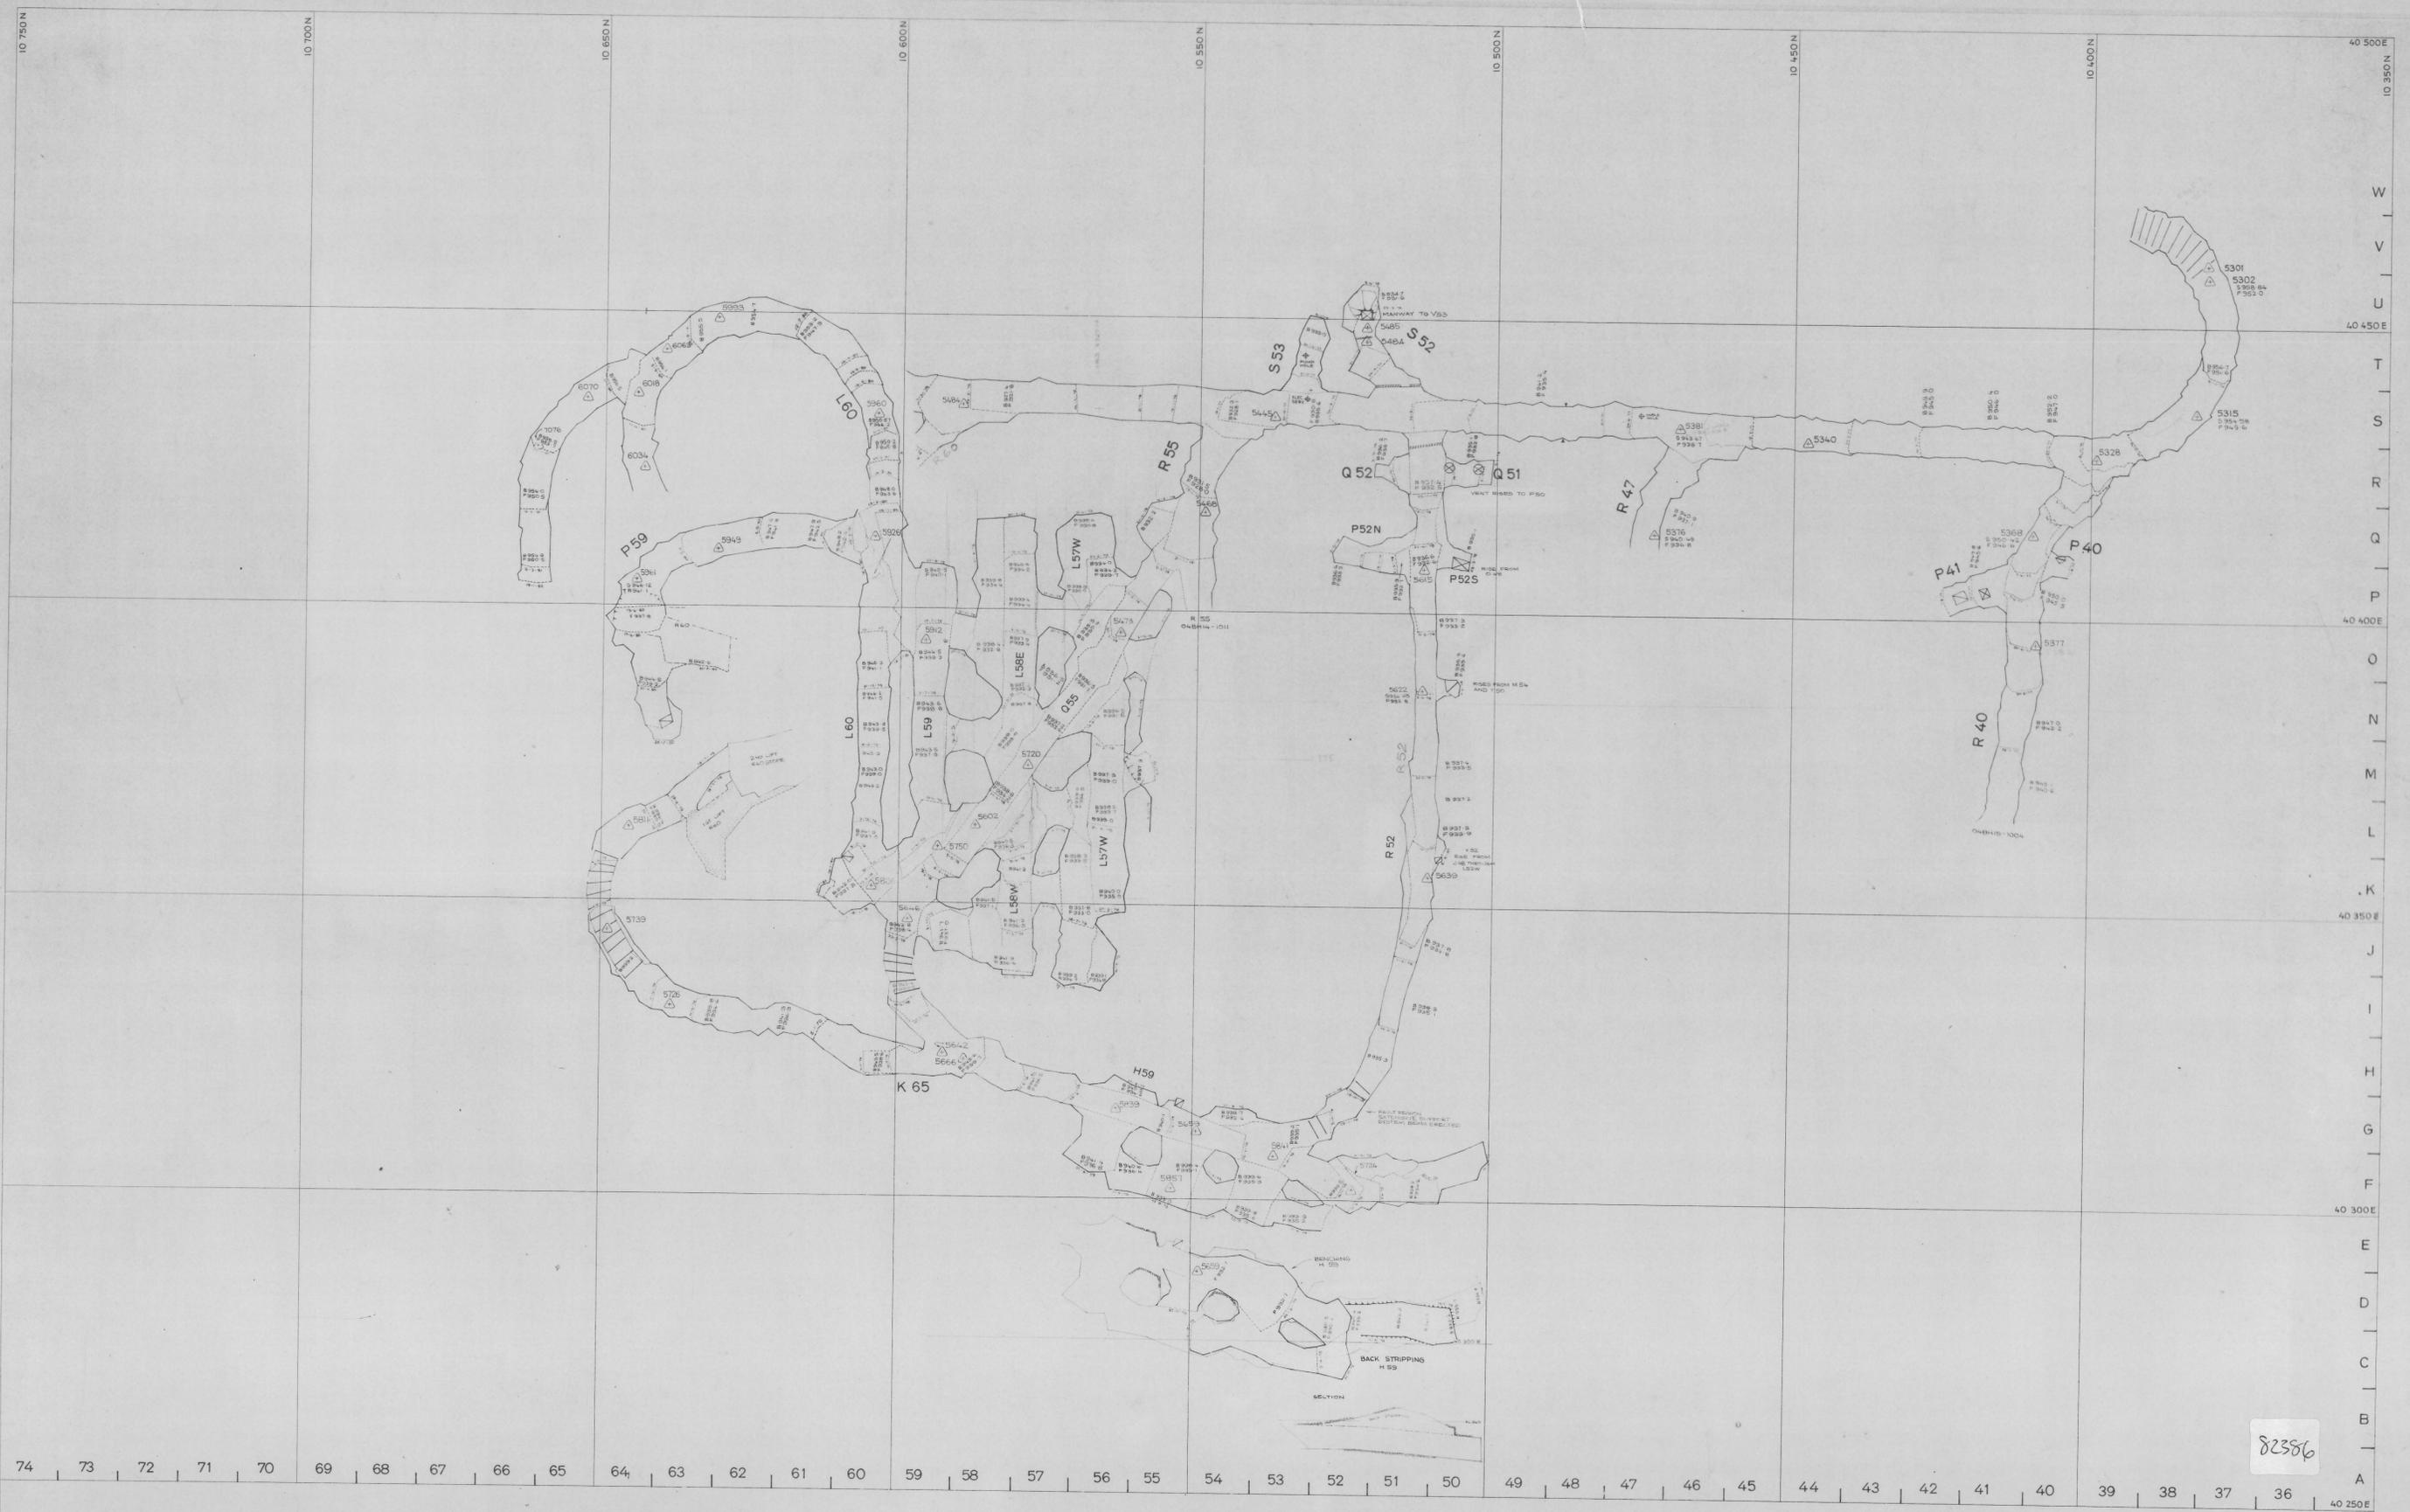

SCALE 1:500

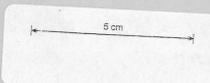

north

BOLD HEAD MINE

MAIN DECLINE

960 m to 910 m Back R.L.

KIS KING ISLAND SCHEELITE
 A DIVISION OF WARHAM INTERNATIONAL

GRASSY KING ISLAND

PLAN NUMBER 04BH14 - 1009

82386