
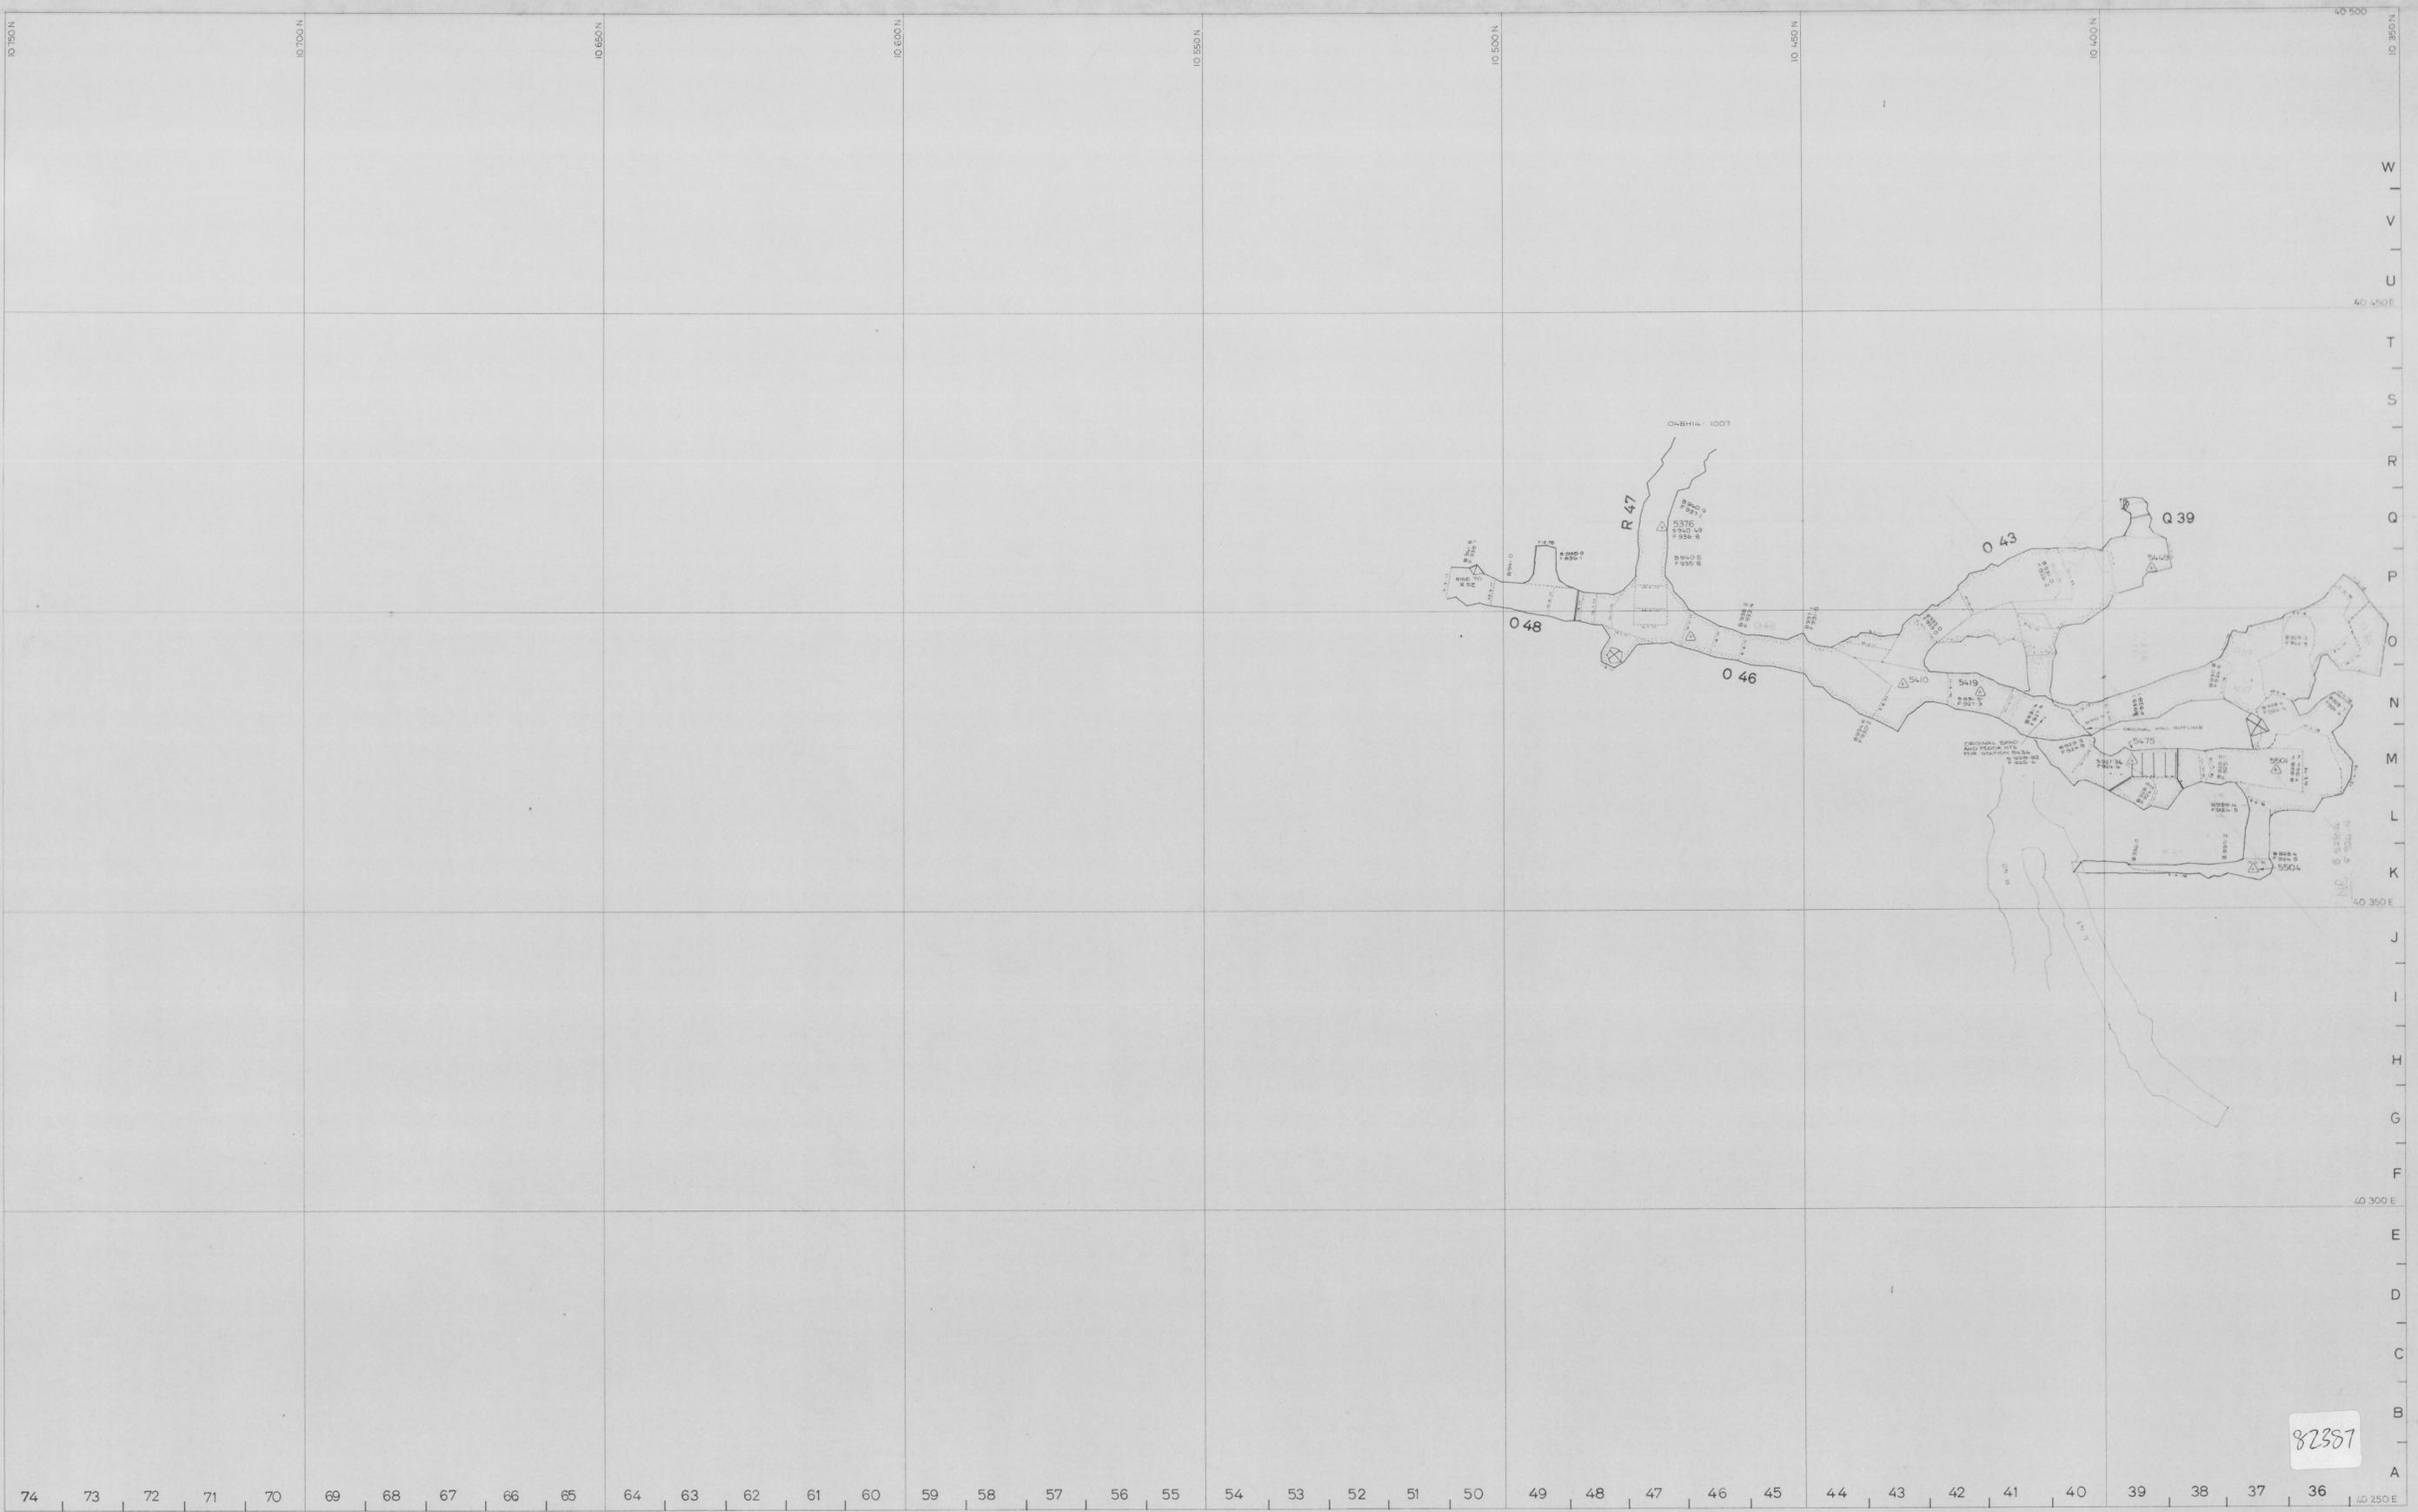


0374_632

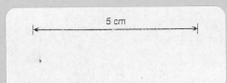

82387

SCALE 1 : 500		LOCATION	BOLD HEAD MINE	 KING ISLAND SCHEELITE A DIVISION OF WARRAN INTERNATIONAL
		SUBJECT	STOPE DEVELOPMENT B. F. 2.	
north			PLAN NUMBER	04BH14 - 1010

Handwritten signature