


0374_642

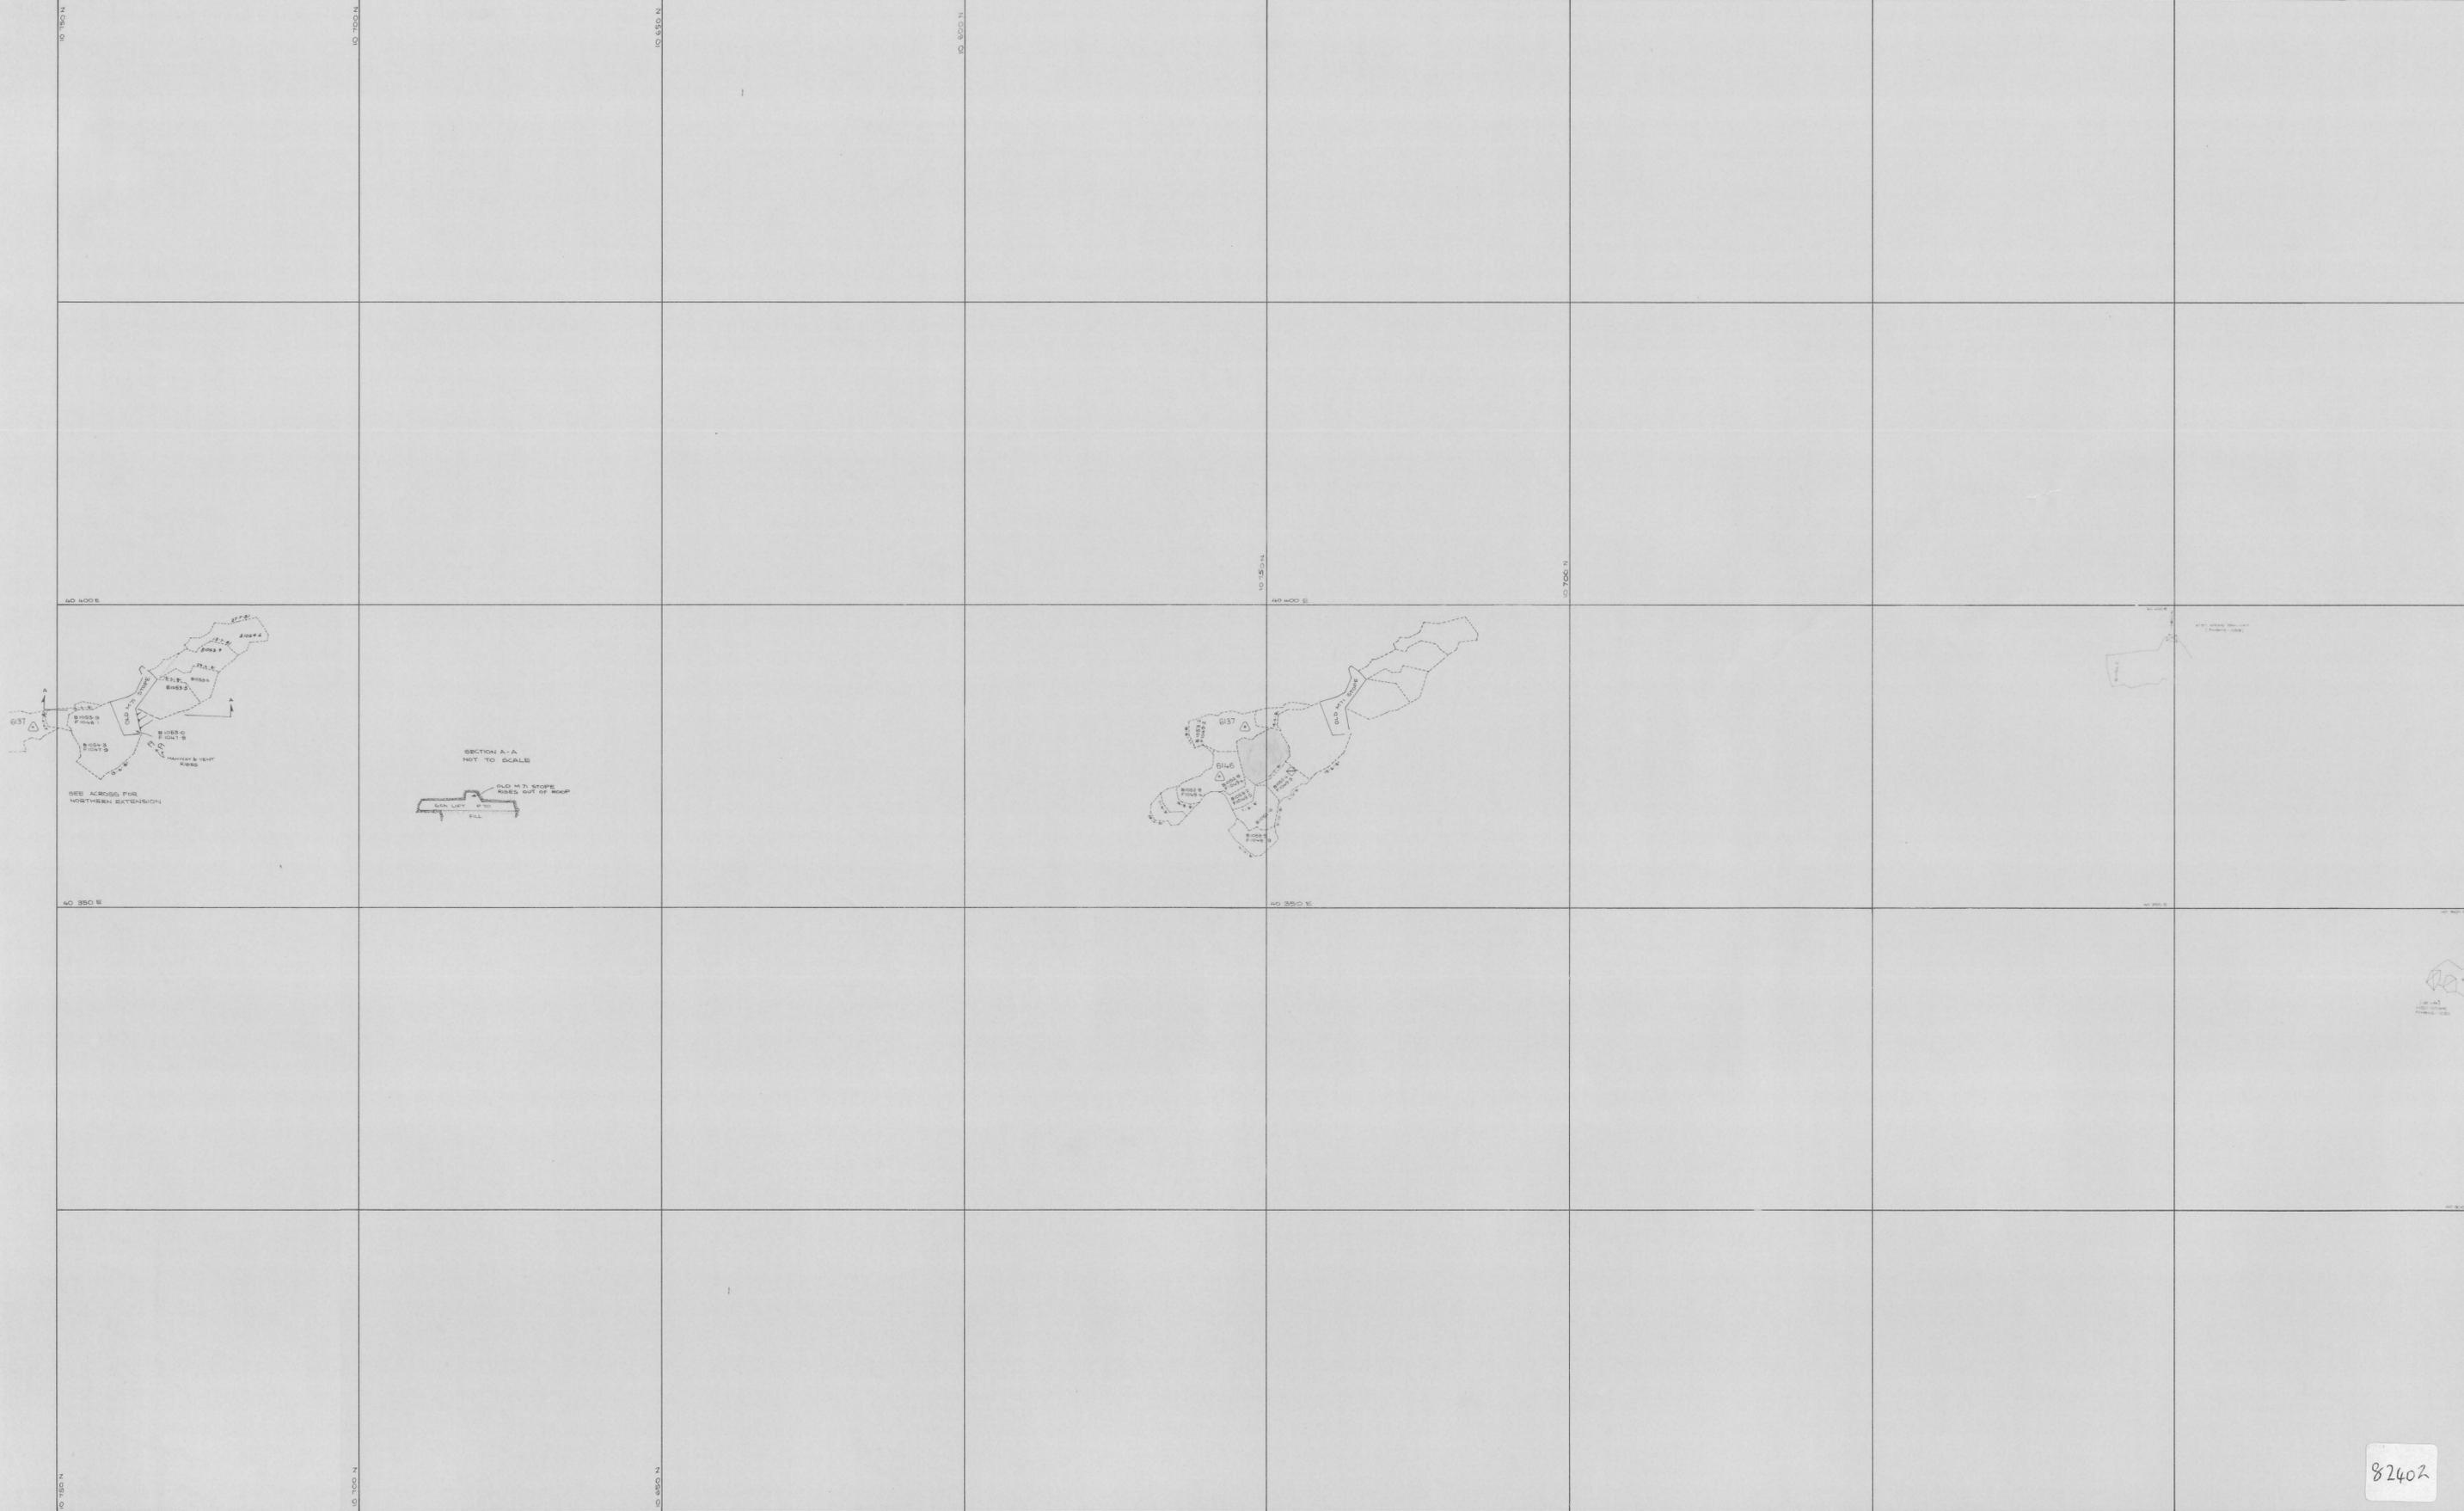

	SCALE 1:500		LOCATION BOLD HEAD MINE	
			SUBJECT P70 STOPE 6th lift	

Handwritten signature and date: 8/15/82