
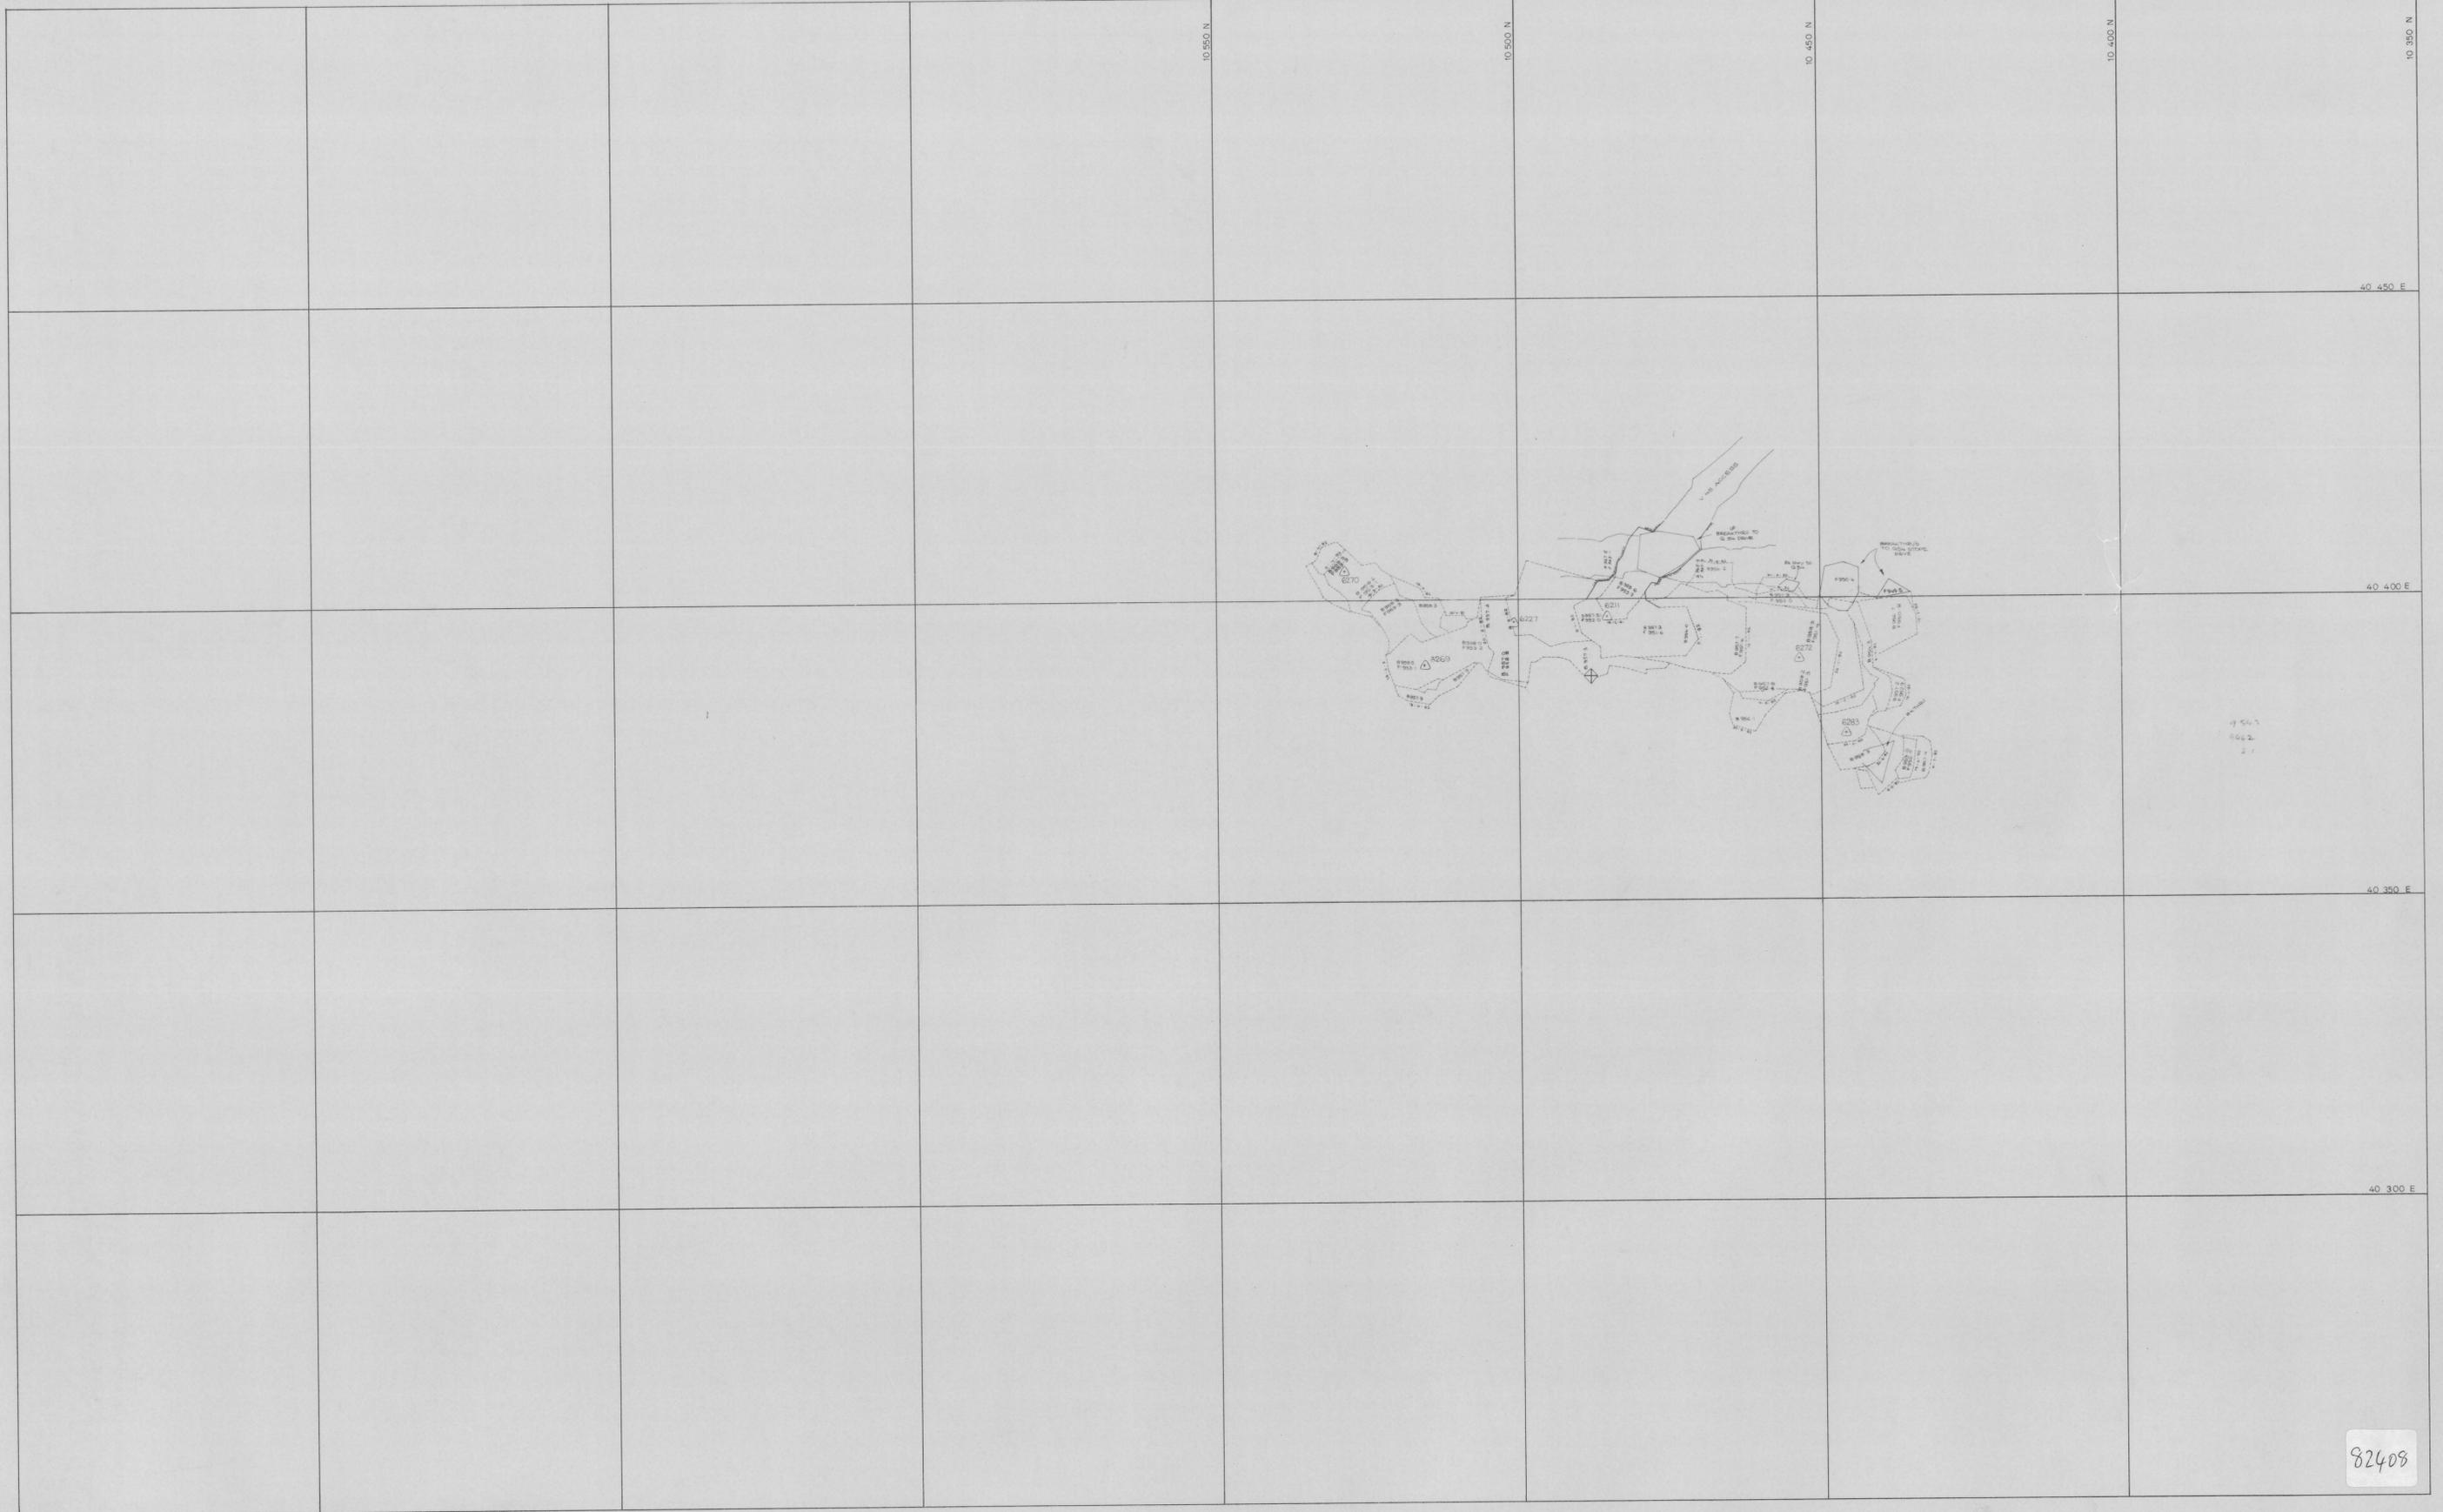


0374\_648

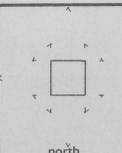

82408

	SCALE 1: 500	 north	LOCATION BOLD HEAD MINE	 GRASSY KING ISLAND <small>OUR MARK PLAN NUMBER</small> 04BH15 - 106 - 91
			SUBJECT <b>046 STOPE</b> <b>9th lift</b>	

*Handwritten signature*