



10374_650

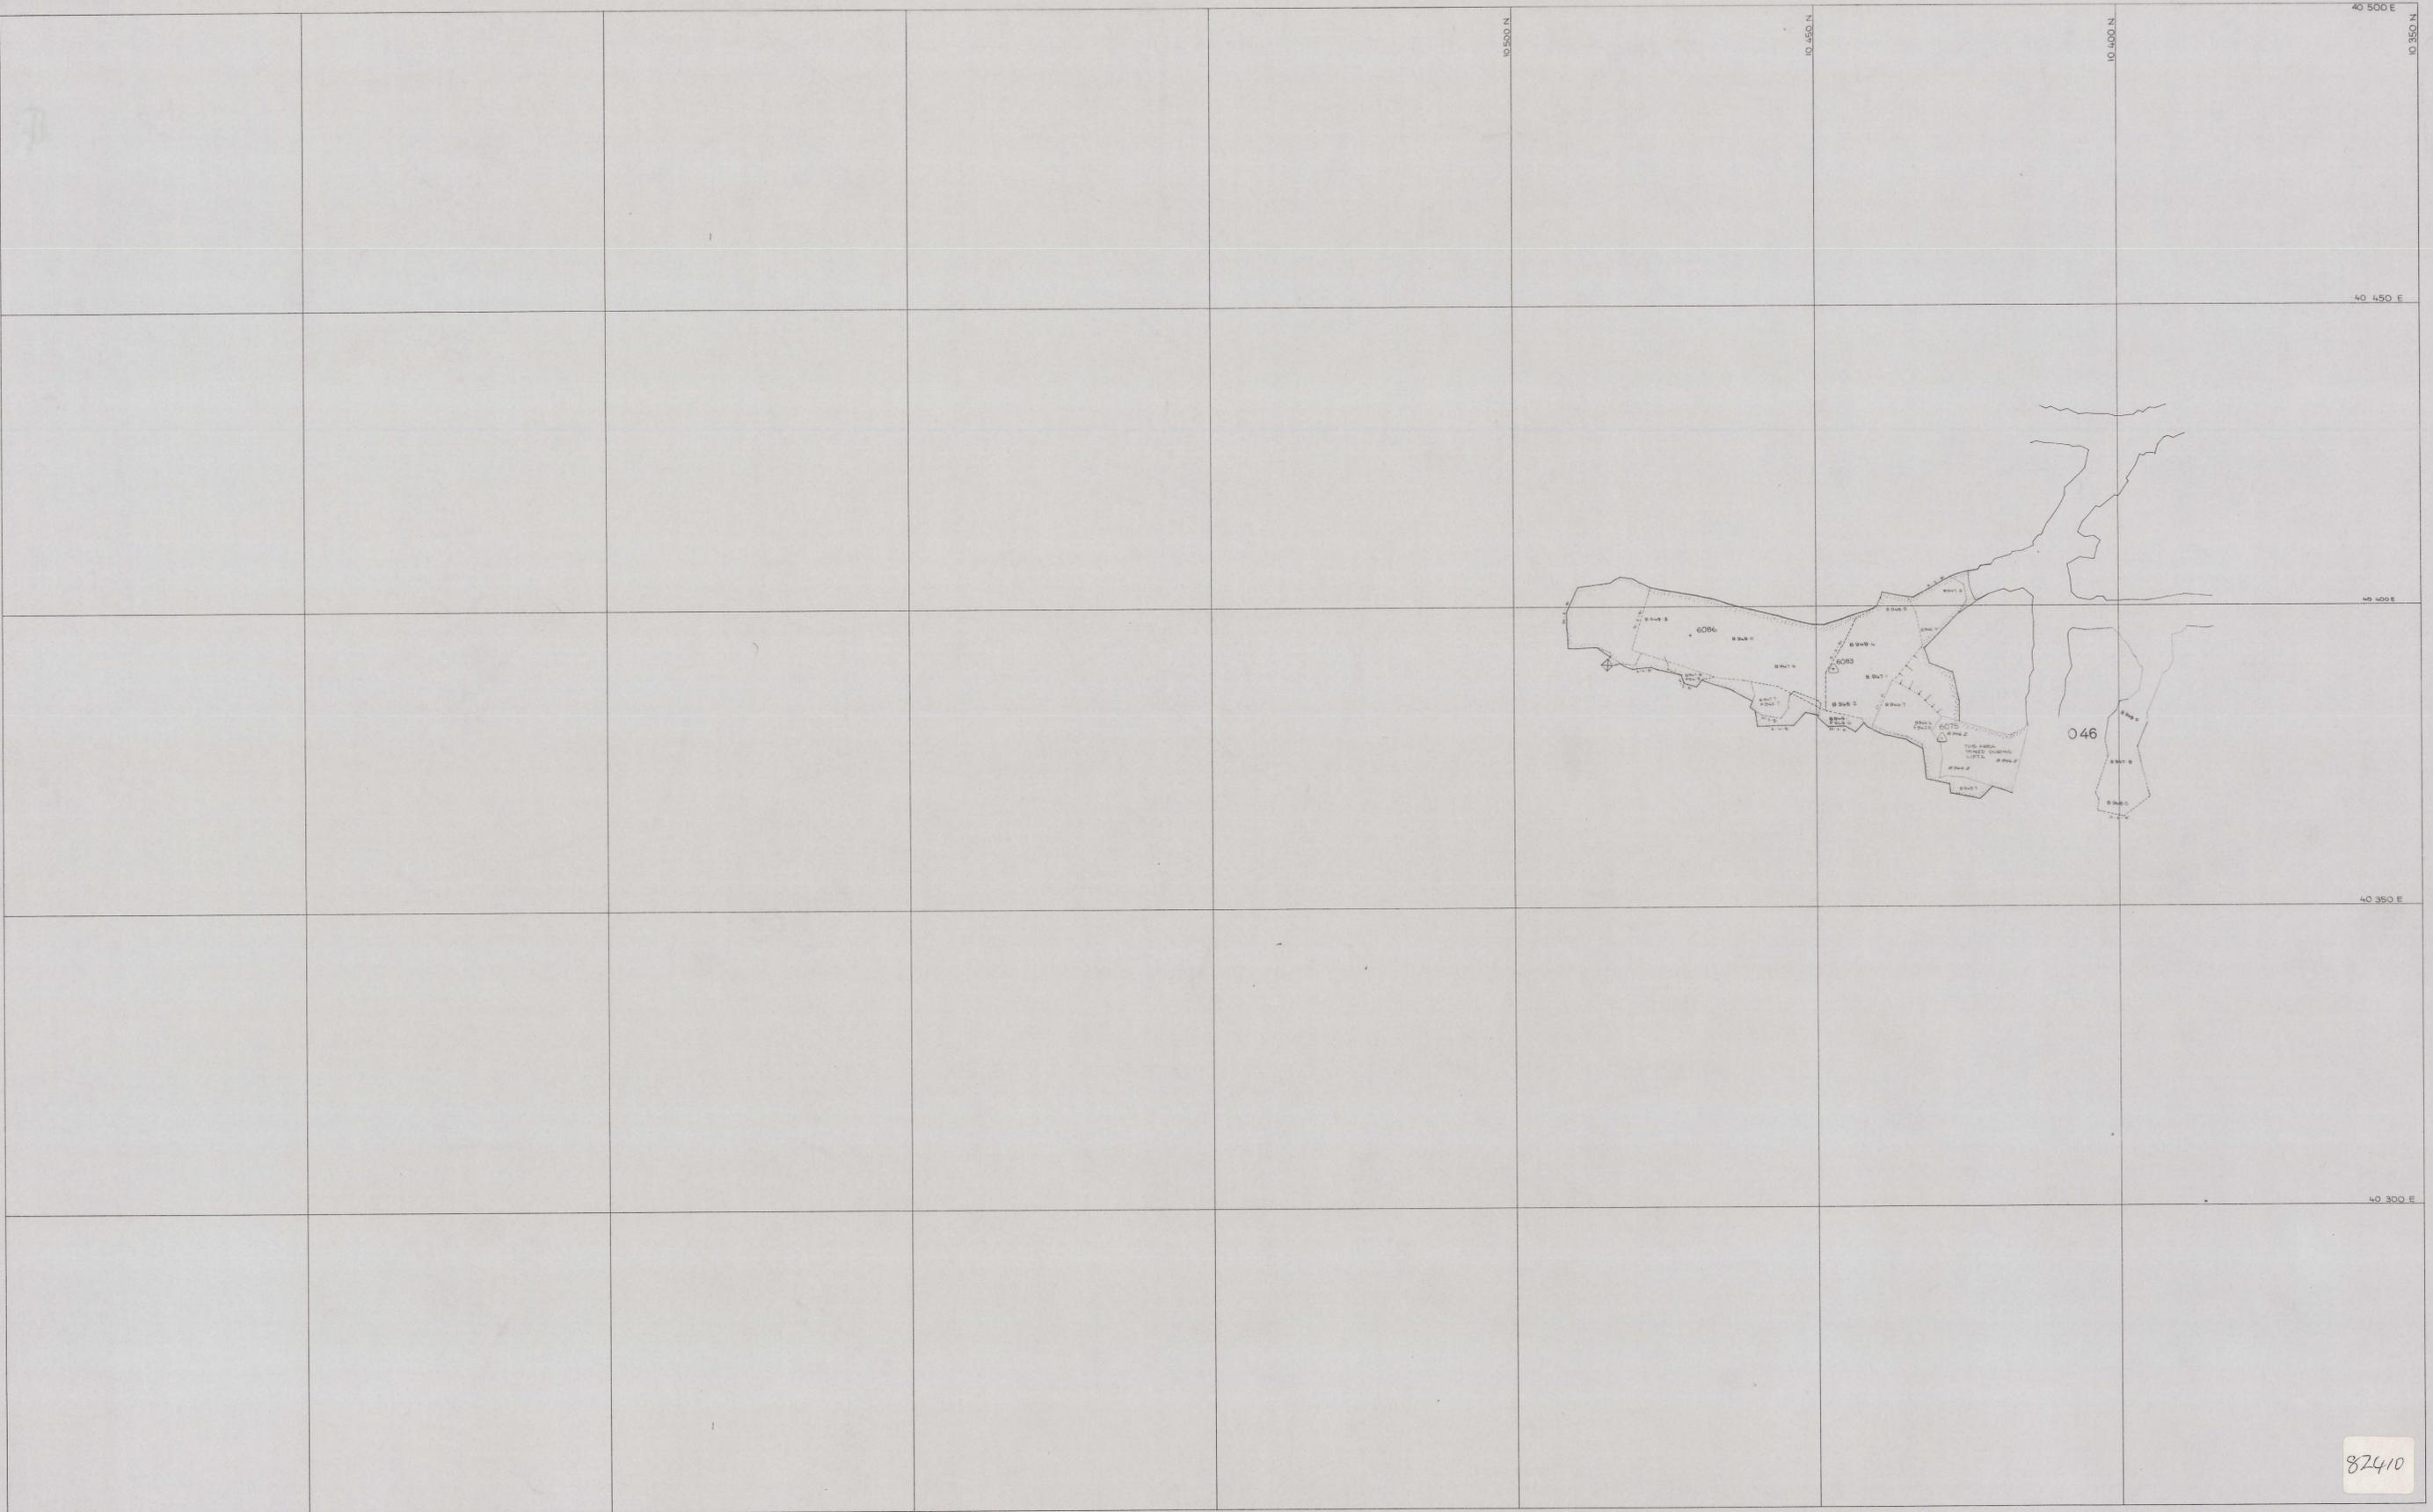

87410

SCALE 1:500

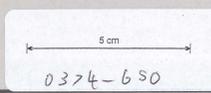

north

LOCATION

BOLD HEAD MINE

SUBJECT

037 & 043 STOPES
7th lift

KIS KING ISLAND SCHEELITE
A DIVISION OF WARRAN INTERNATIONAL

GRASSY KING ISLAND

PLAN NUMBER 04BH15 - 106 - 93

Handwritten signature