


0374_655

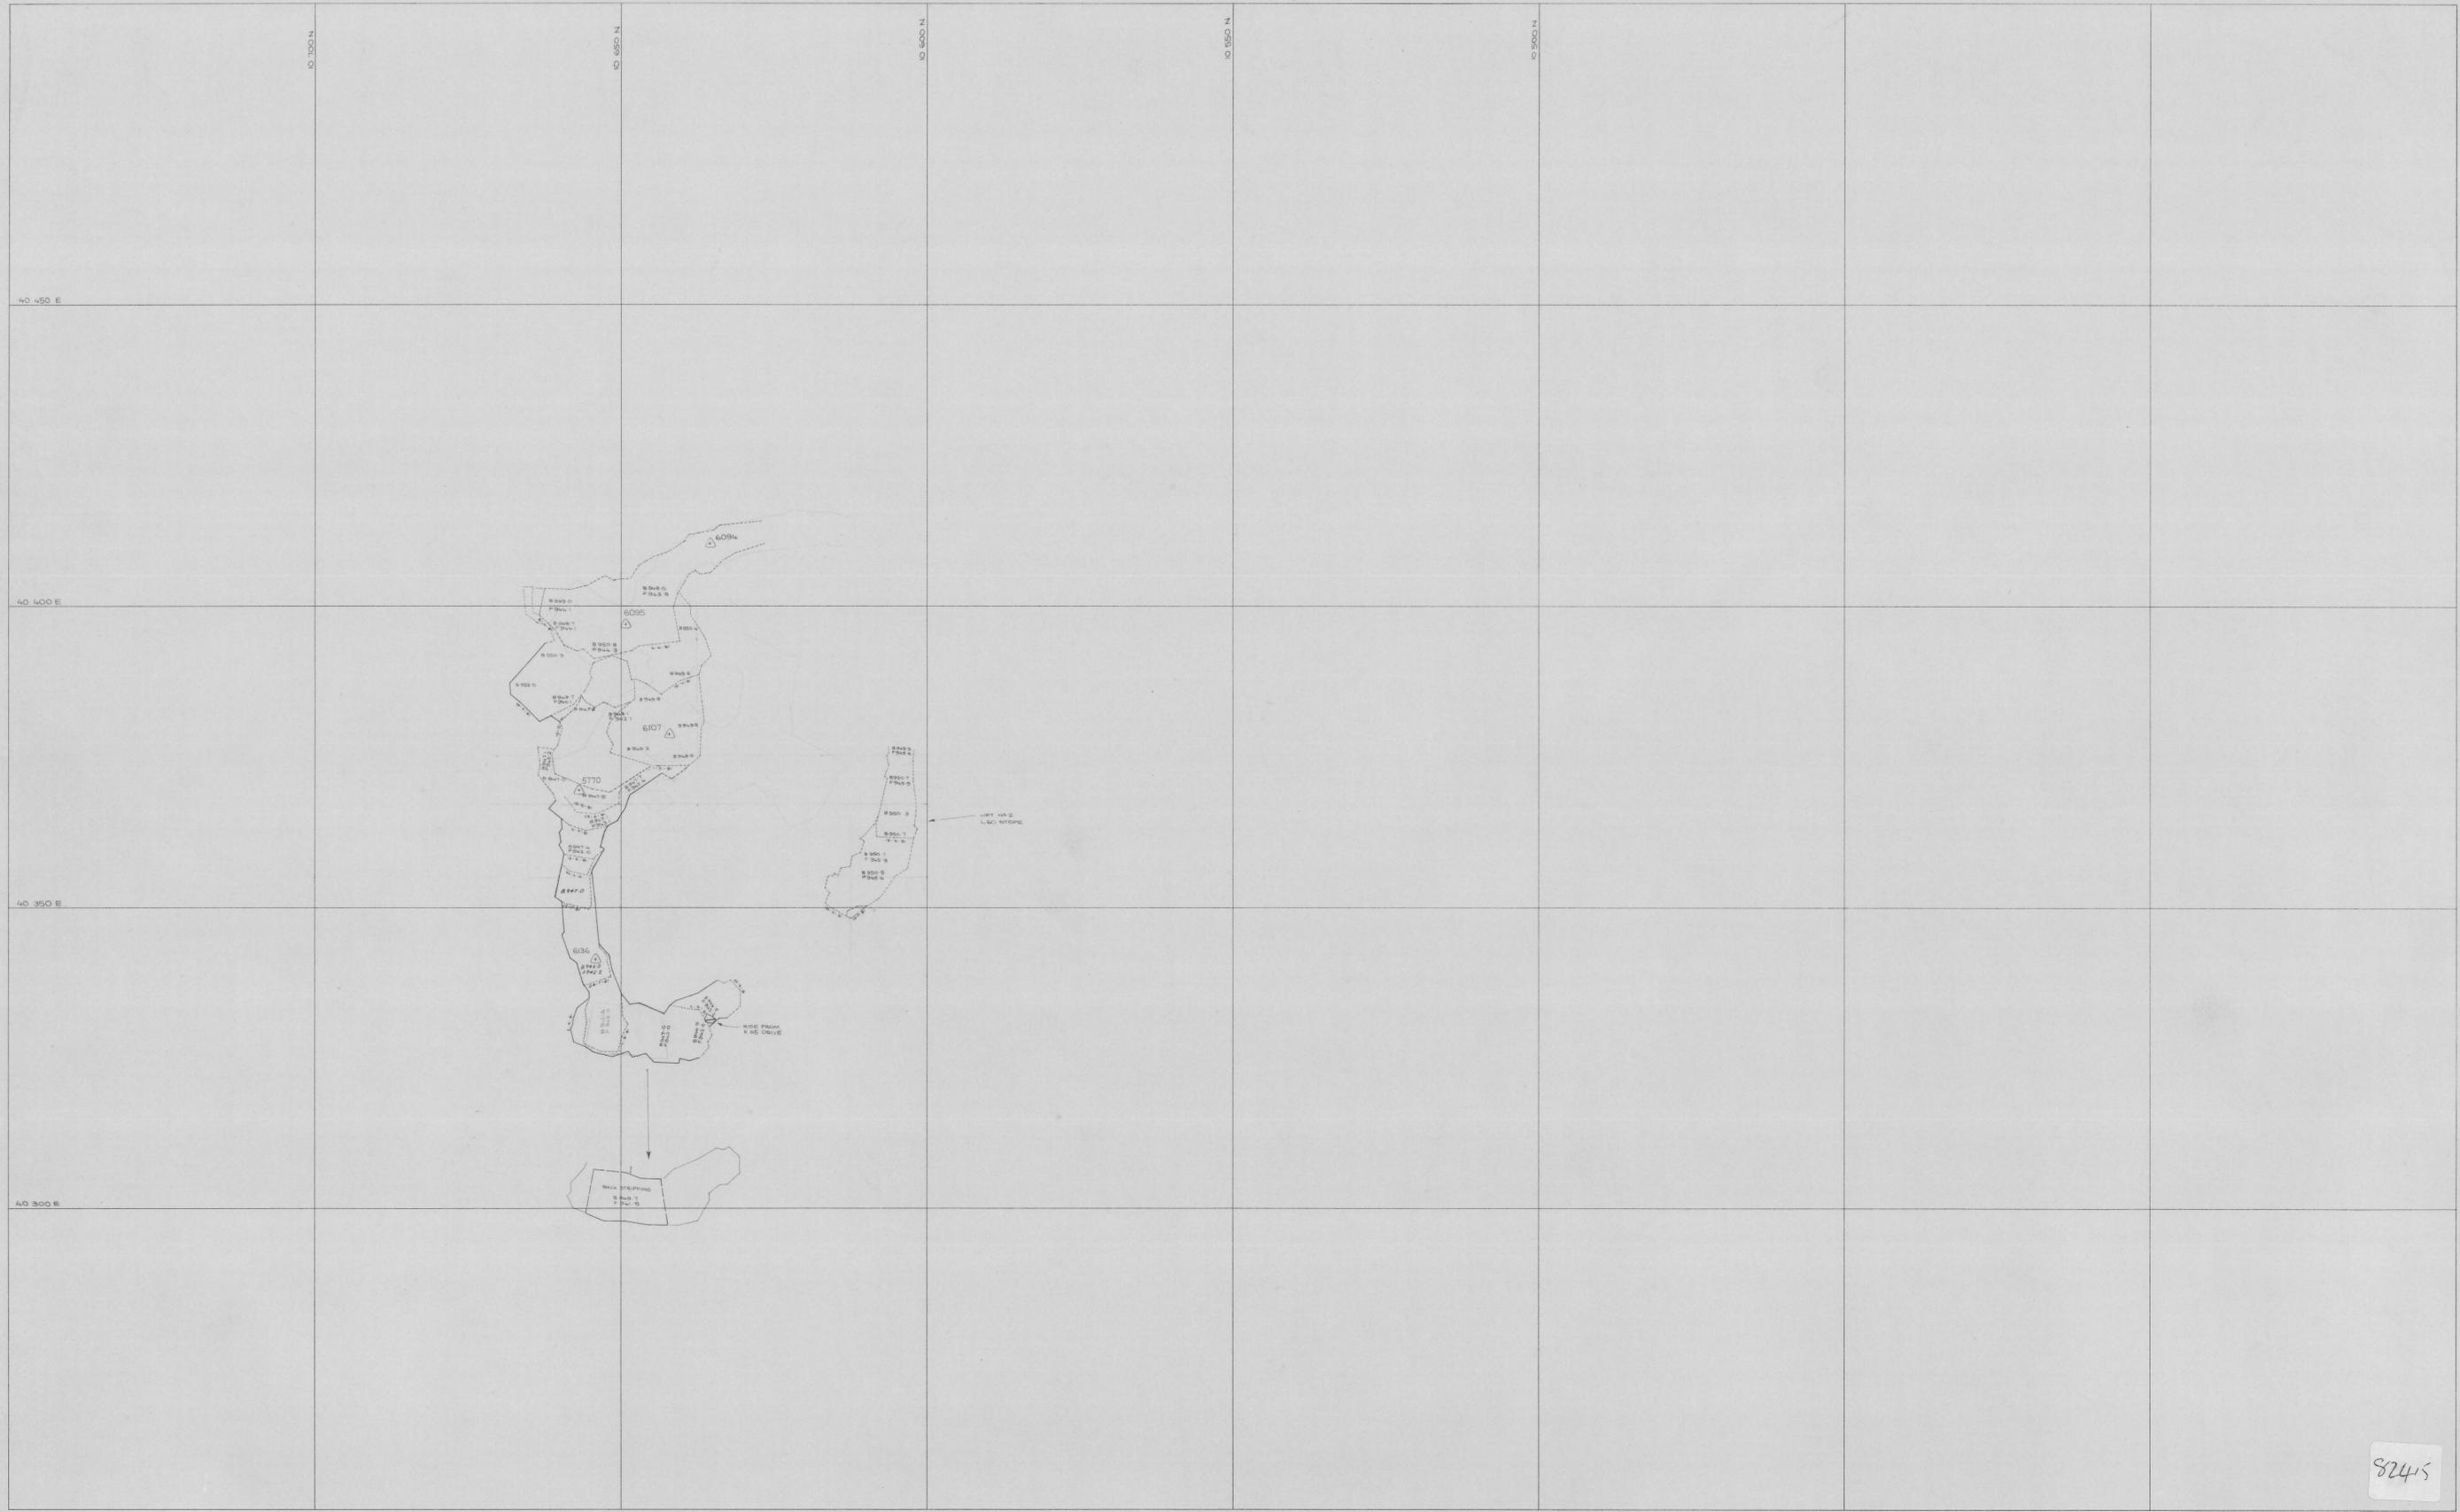

8245

	SCALE 1:500	north	LOCATION BOLD HEAD MINE	 GRASSY KING ISLAND PLAN NUMBER 04BH15 - 107 - 94
	 0374-655		SUBJECT R 60 - 6th lift	

Handwritten signature