


0374-677

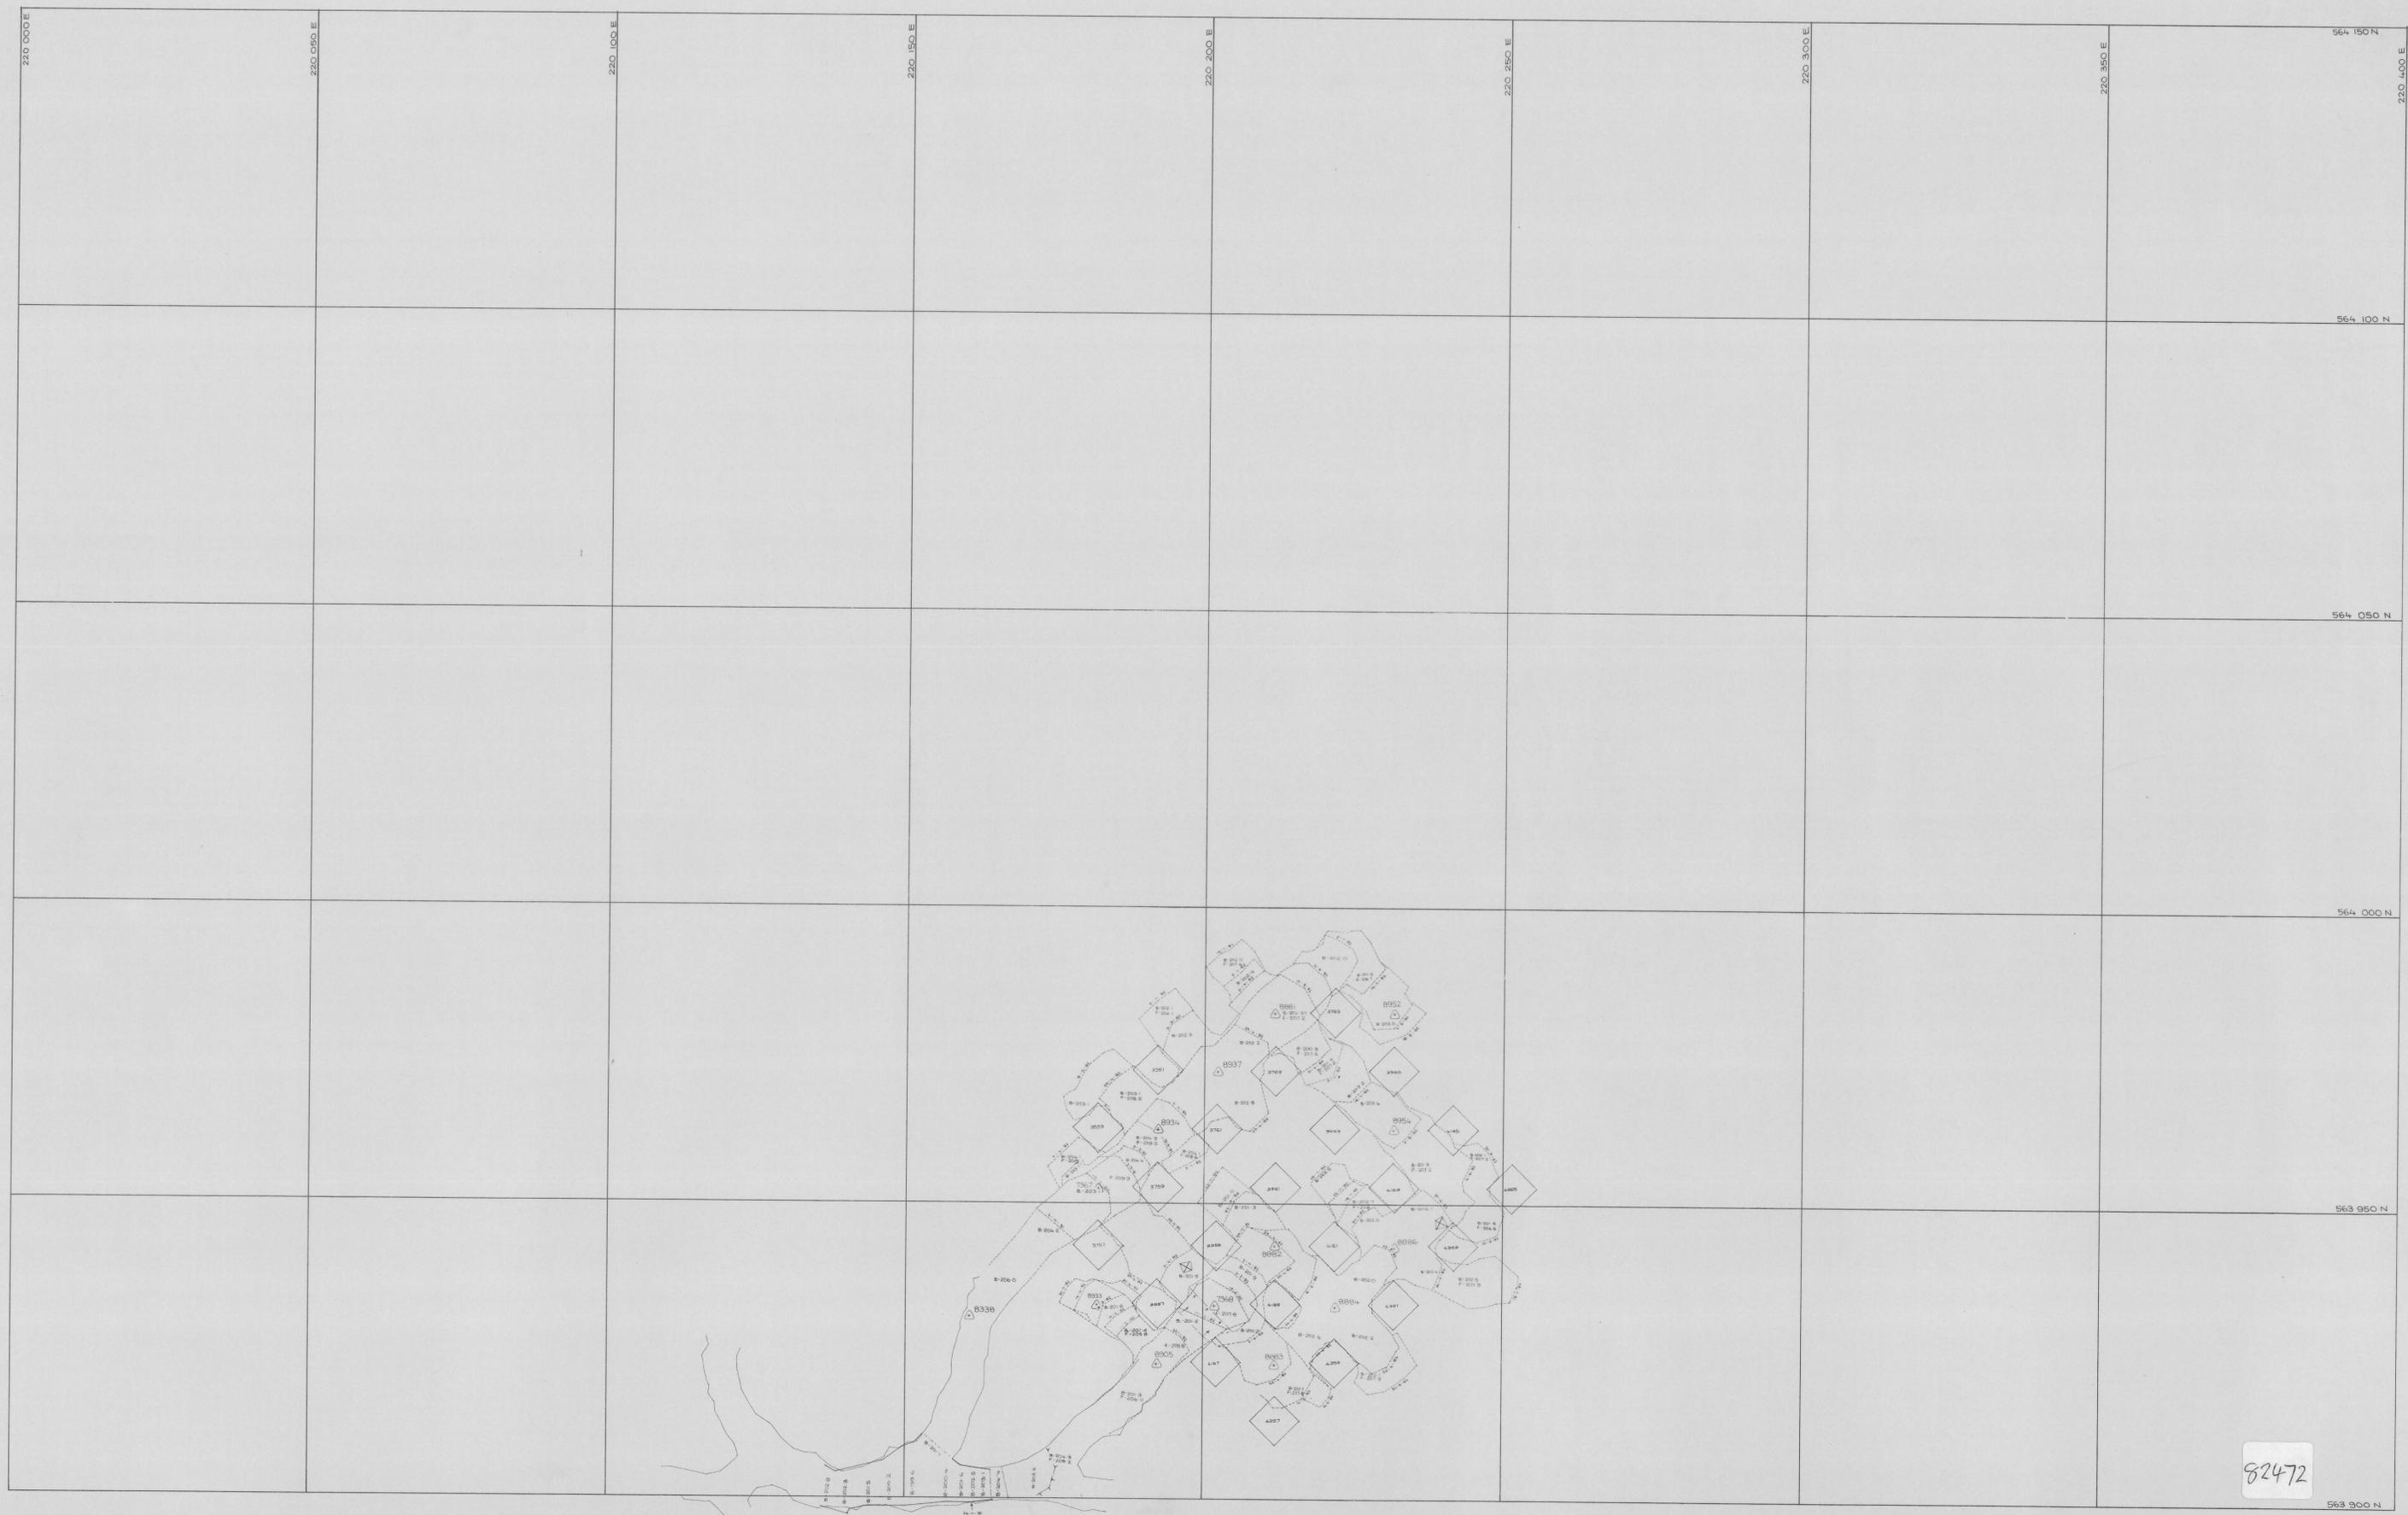

82472

<p>SCALE 1:500</p> <p>5 cm</p> <p>0374-677</p>		<p>LOCATION DOLPHIN MINE</p>	
		<p>SUBJECT LOWER PIT STOPE -206 m CONTOUR</p>	

*Handwritten signature and date: 2/4/82*