


0374_681

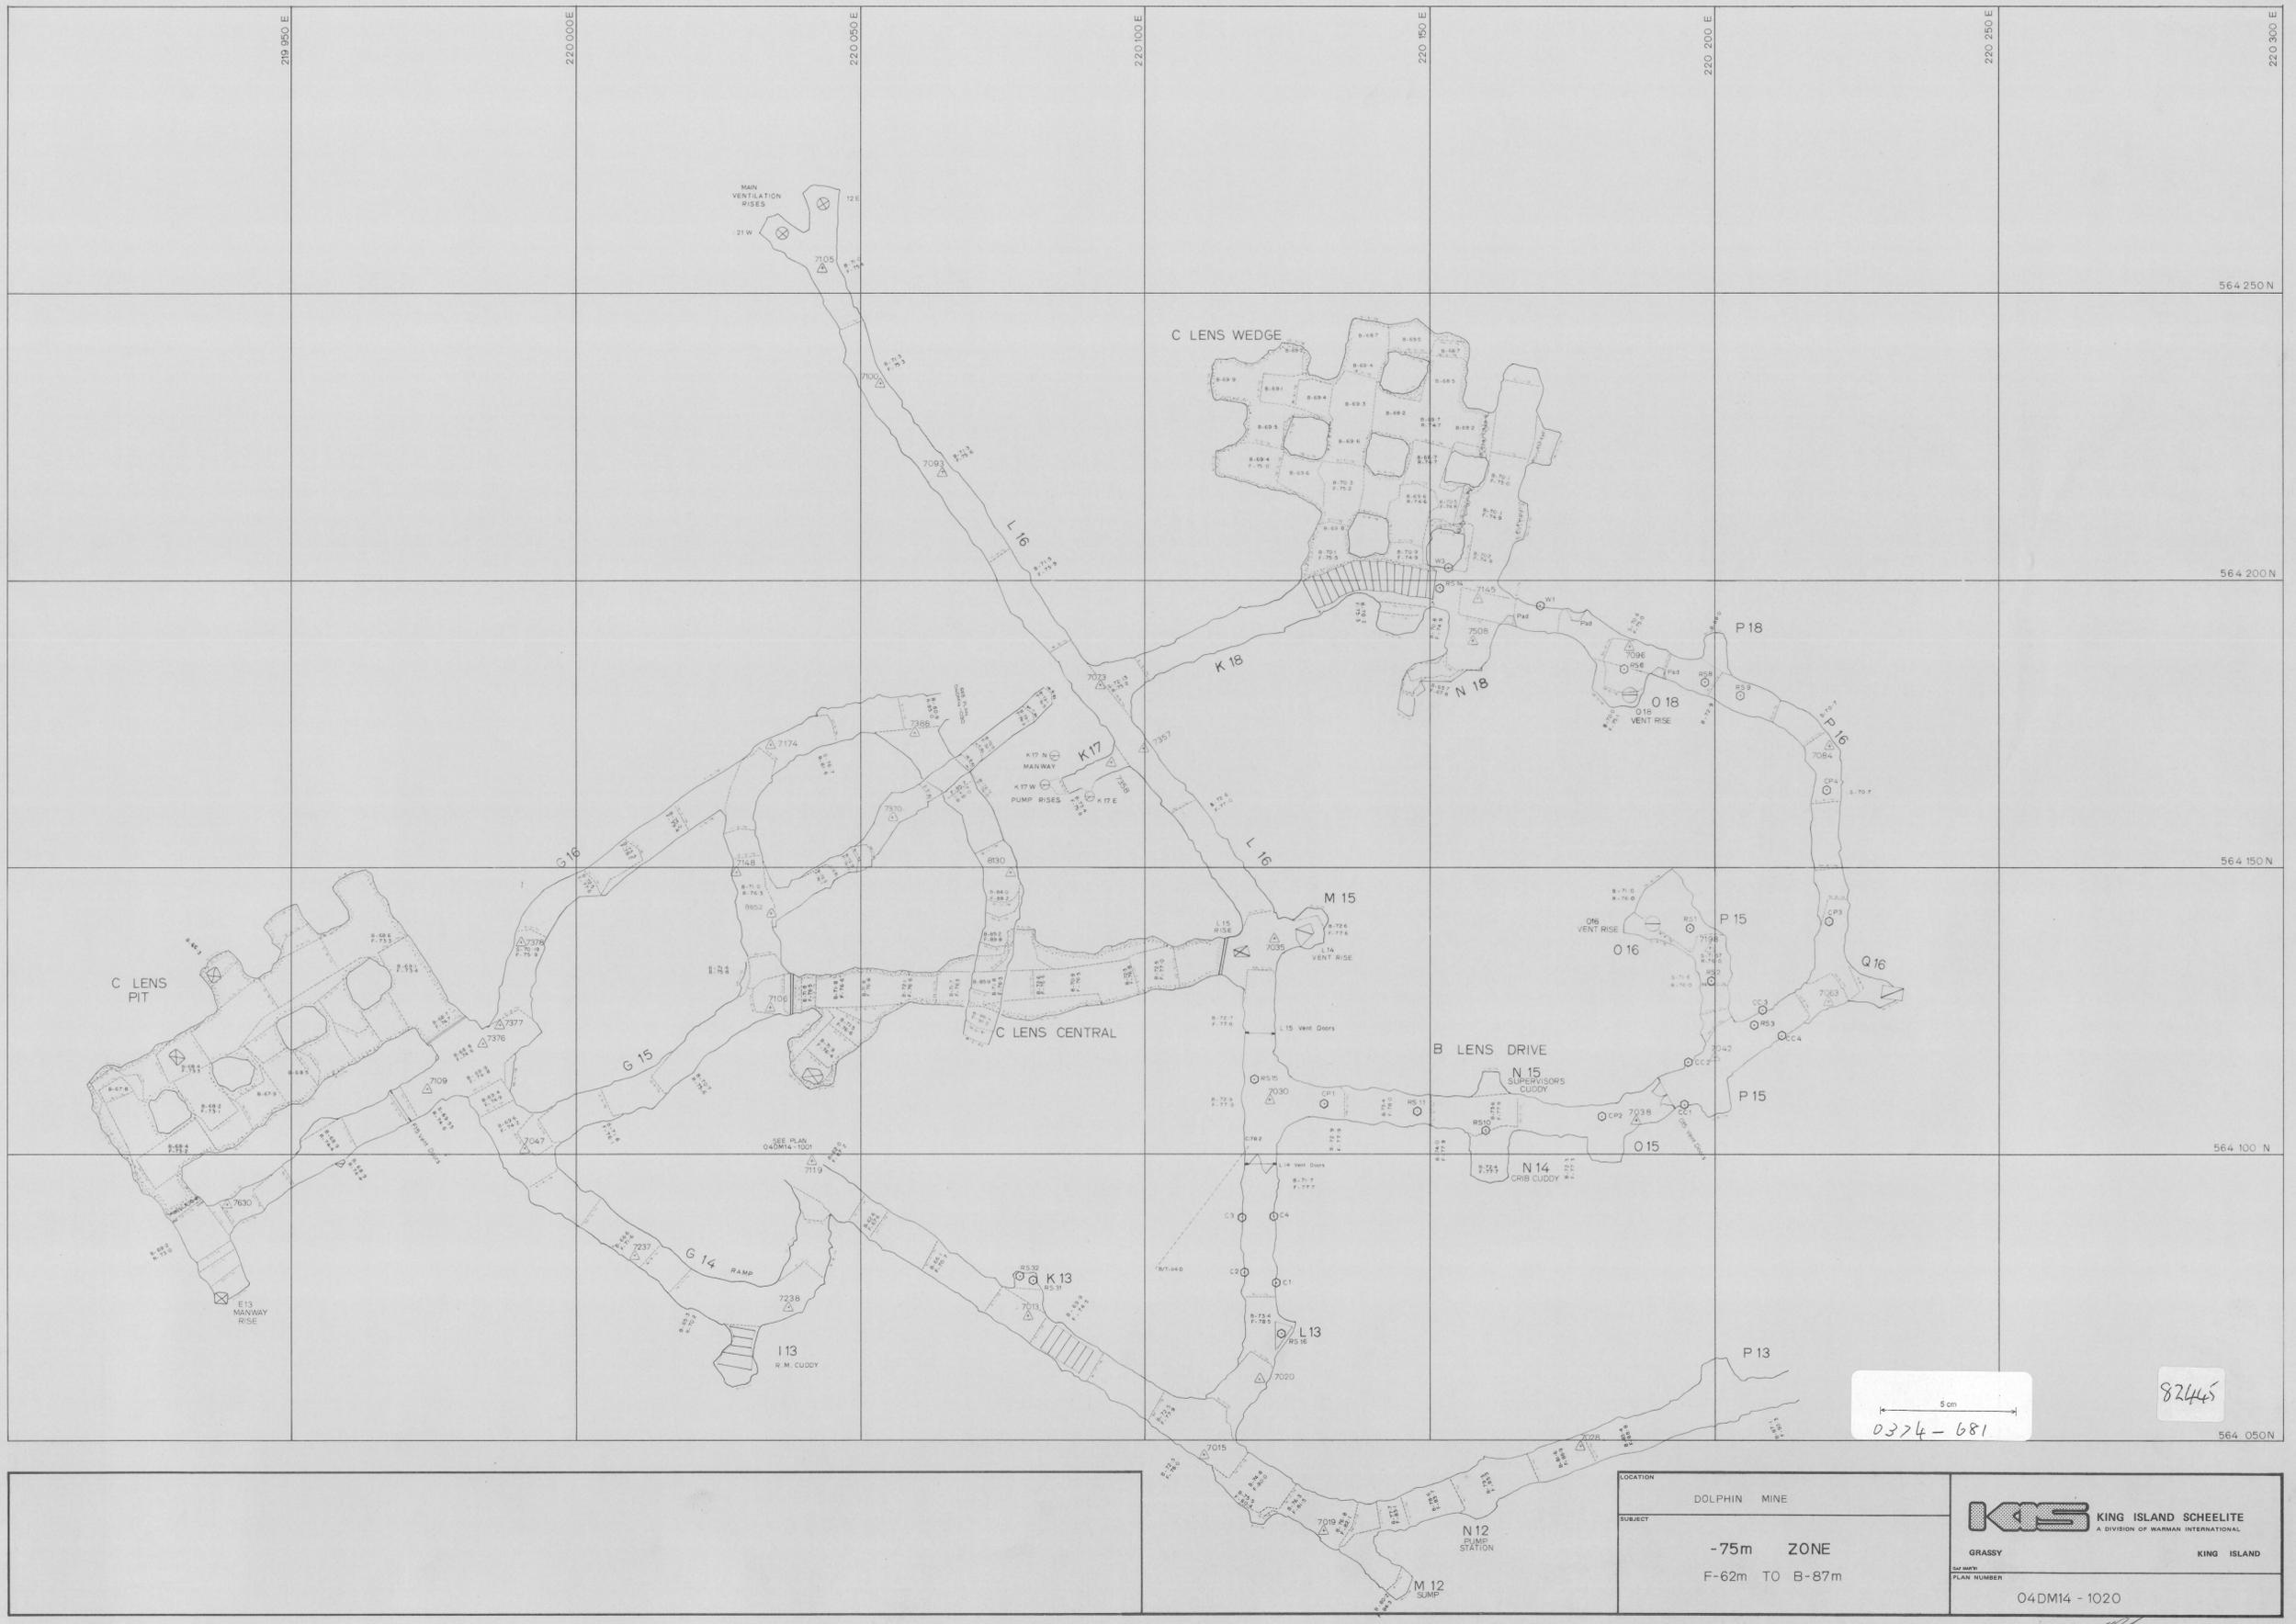

LOCATION	DOLPHIN MINE	 KING ISLAND SCHEELITE A DIVISION OF NARMAN INTERNATIONAL GRASSY KING ISLAND
SUBJECT	-75m ZONE F-62m TO B-87m	
PLAN NUMBER	04DM14 - 1020	

Handwritten signature and date:
 [Signature] 9/1/02