



W
V
U
40450E
T
S
R
Q
P
40400E
O
N
M
L
K
40350E
J
I
H
G
F
40300E
E
D
C
B
A
40250E

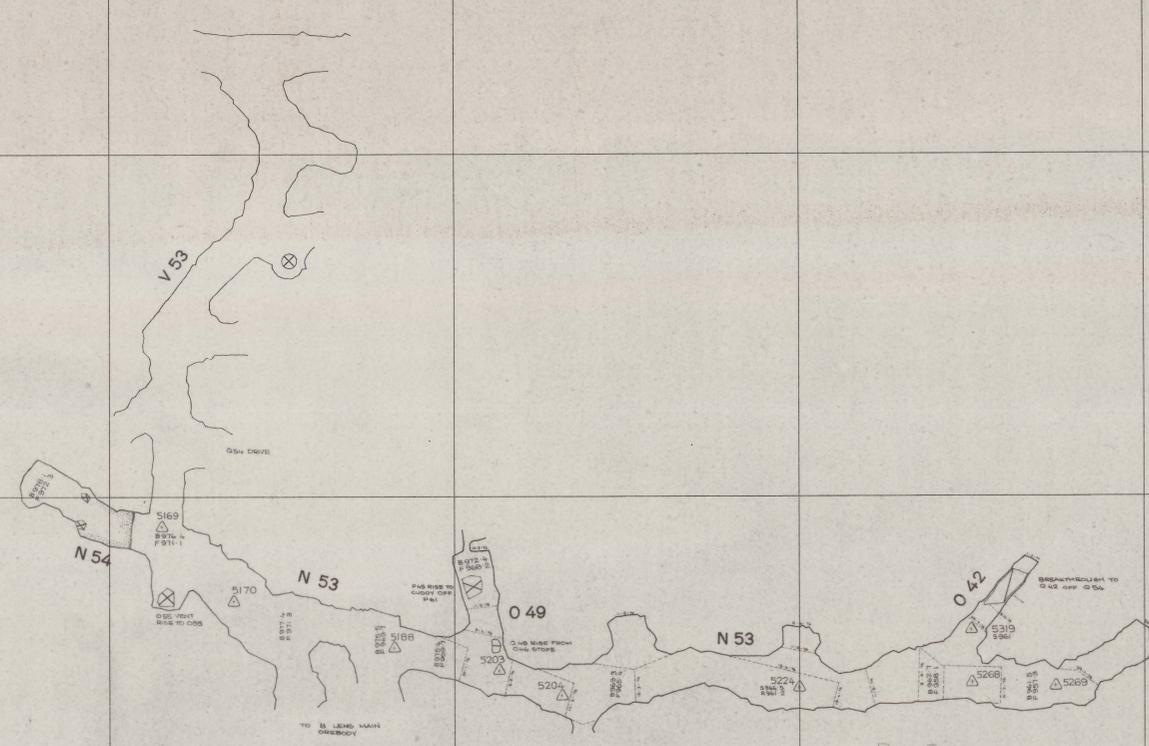

0374_712

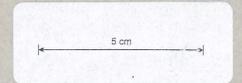

MICROFILMED

74 73 72 71 70 10 700 N 69 68 67 66 65 10 650 N 64 63 62 61 60 10 600 N 59 58 57 56 55 10 550 N 54 53 52 51 50 10 500 N 49 48 47 46 45 10 450 N 44 43 42

| | | |
|---------------------------|-----------------------|---------------------------|
| | KING ISLAND SCHEELITE | |
| | A1 | SCALE 1:500 04BH14-1008 |
| BOLD HEAD MINE | | |
| B LENS FAULT BLOCK & PART | | |
| B LENS EAST | | |
| DATE | | |
| SURVEYED | | |
| DRAWN | | |
| TRACED | | |
| CHECKED | | |

0374_712