


0374_743

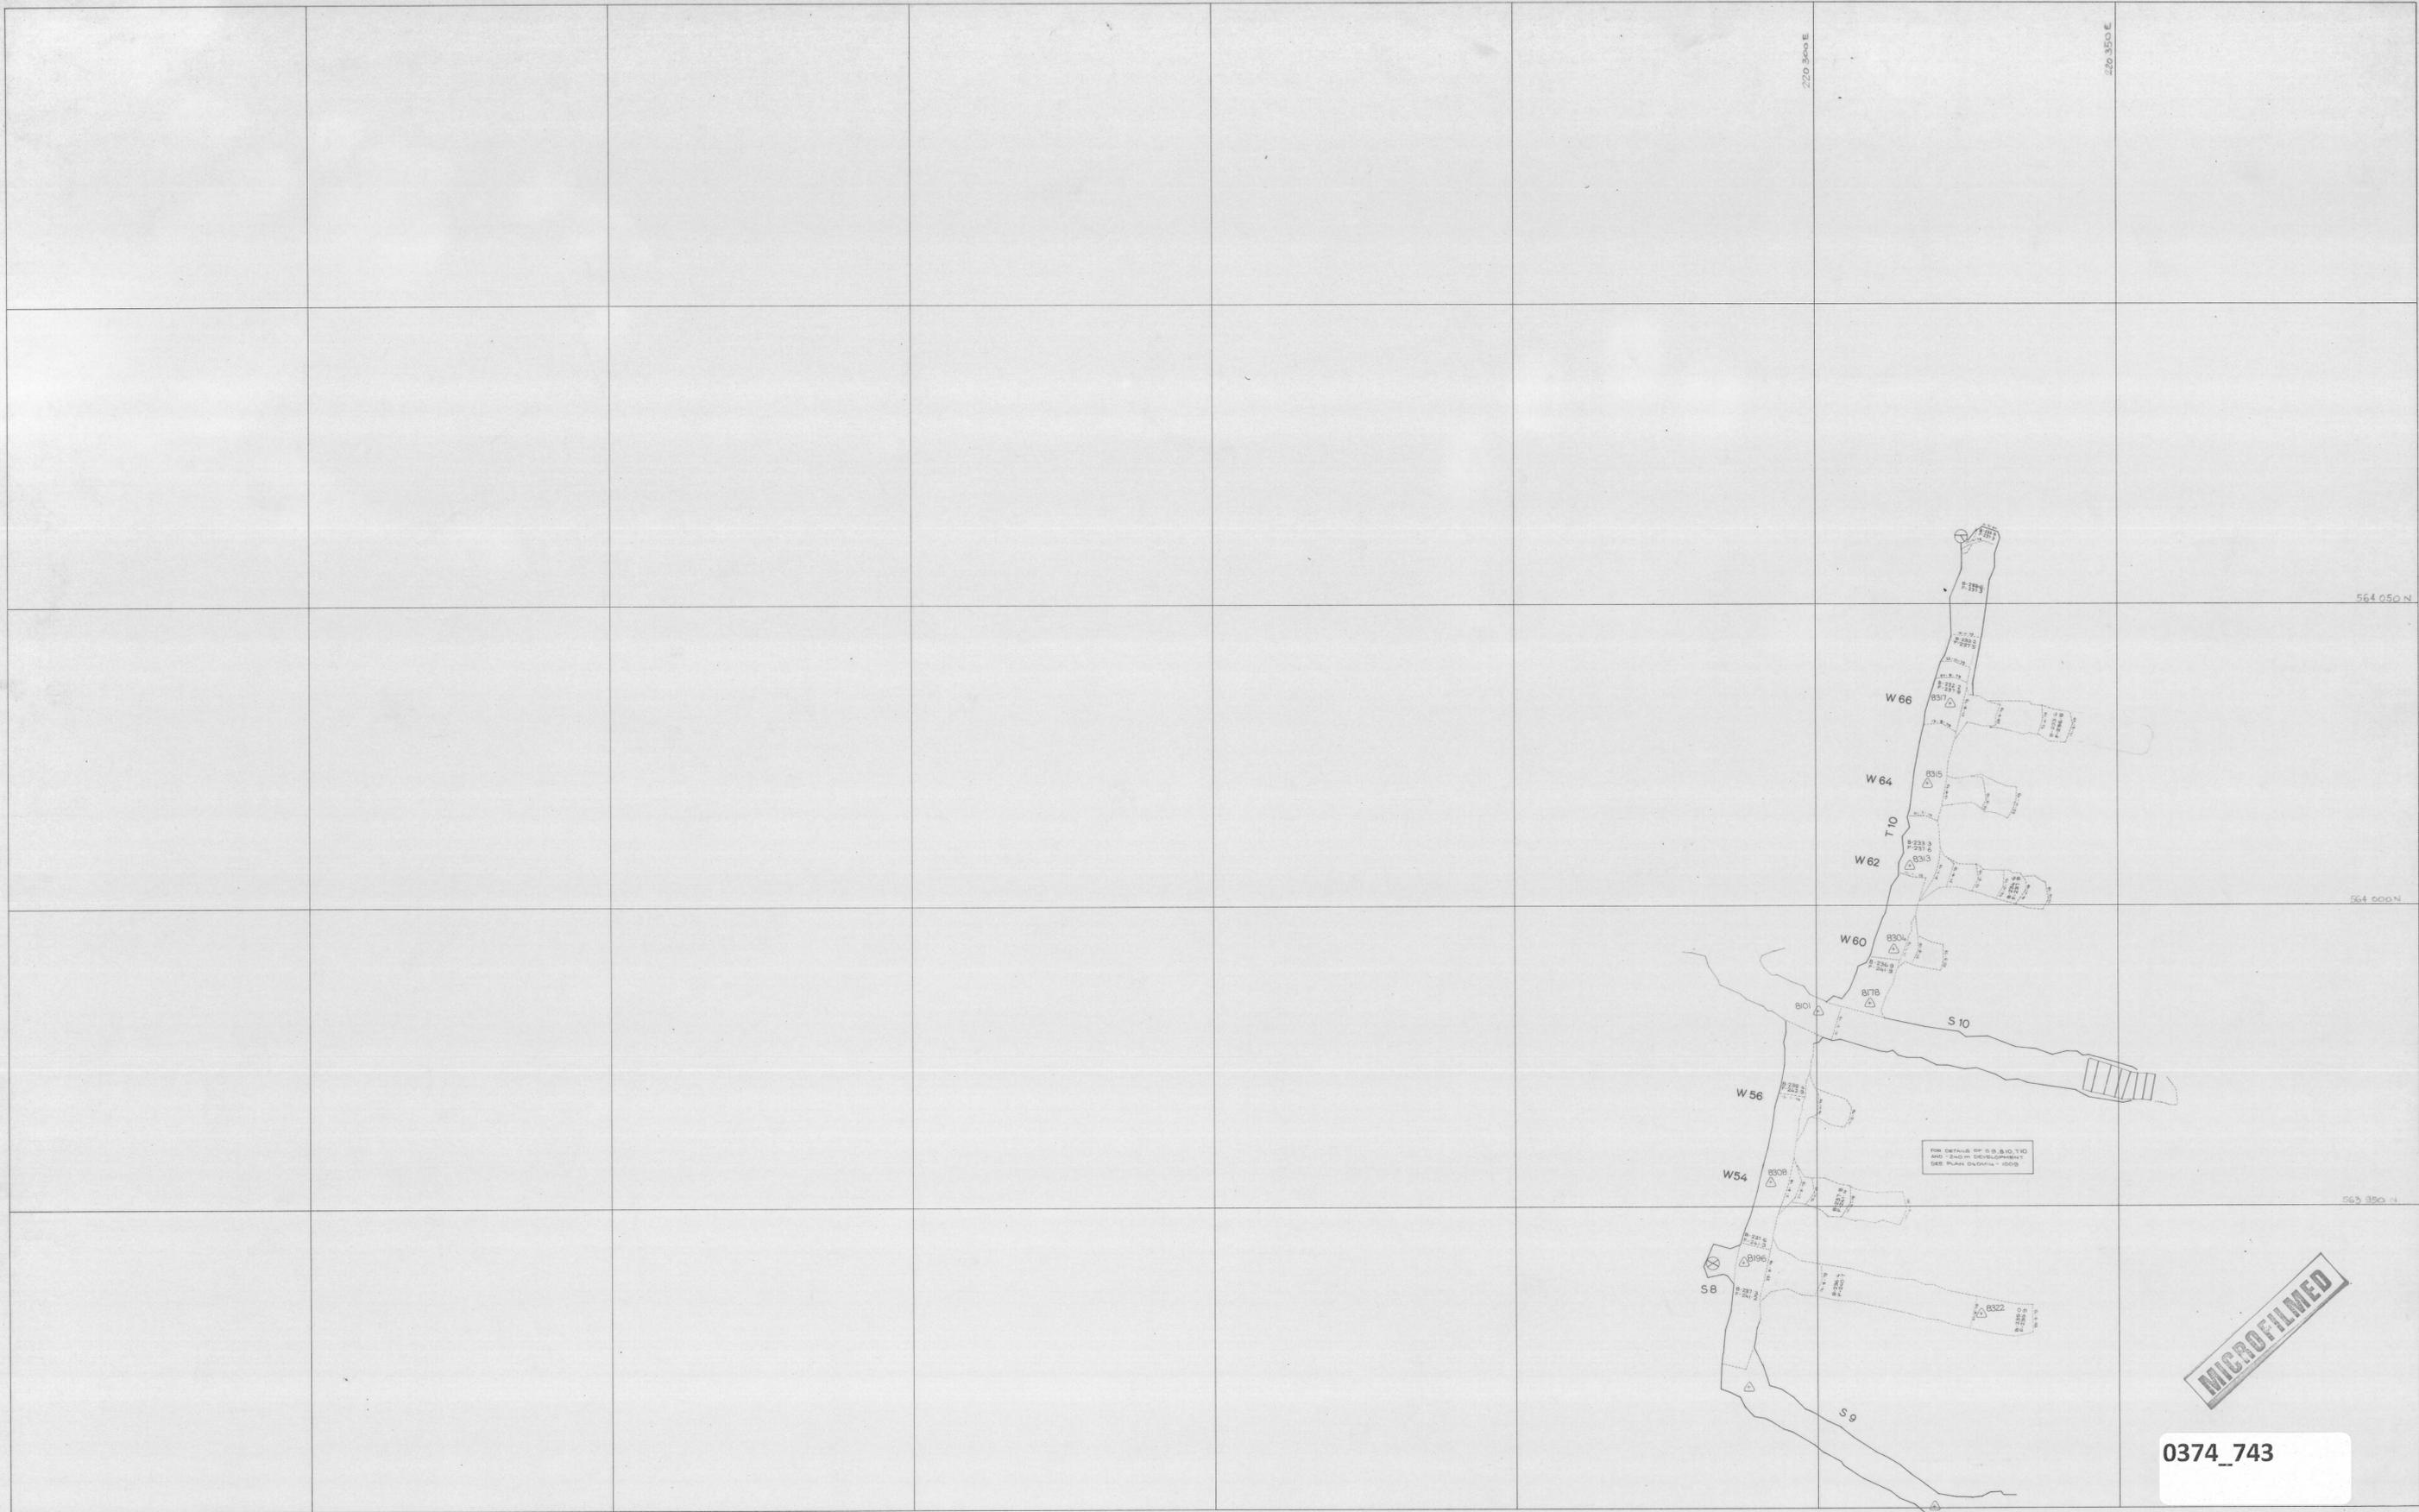

MICROFILMED

0374_743

	<p>SCALE 1:500</p>  <p>5 cm</p>	<p>north</p>	<p>LOCATION DOLPHIN MINE</p> <p>SUBJECT LOWER WEDGE ACCESS -240m LEVEL</p>	<p>KIS KING ISLAND SCHEELITE A DIVISION OF WARMAN INTERNATIONAL</p> <p>GRASSY KING ISLAND</p> <p>PLAN NUMBER 04DM14 - 1109 79046</p>
--	--	--------------	--	---