

220 050 E

220 100 E

220 150 E

220 200 E

220 250 E

220 300 E

220 350 E

564 250 N

564 200 N

564 150 N

564 100 N

564 050 N

W13

W15

W17

W19

W21

W23

W25

W27

W29

W31

W33

W35

W37

W89

W87

W85

W83

W81

W79


W77

W75

W73

K17 N
MANWAY RISE


L14
VENT RISE

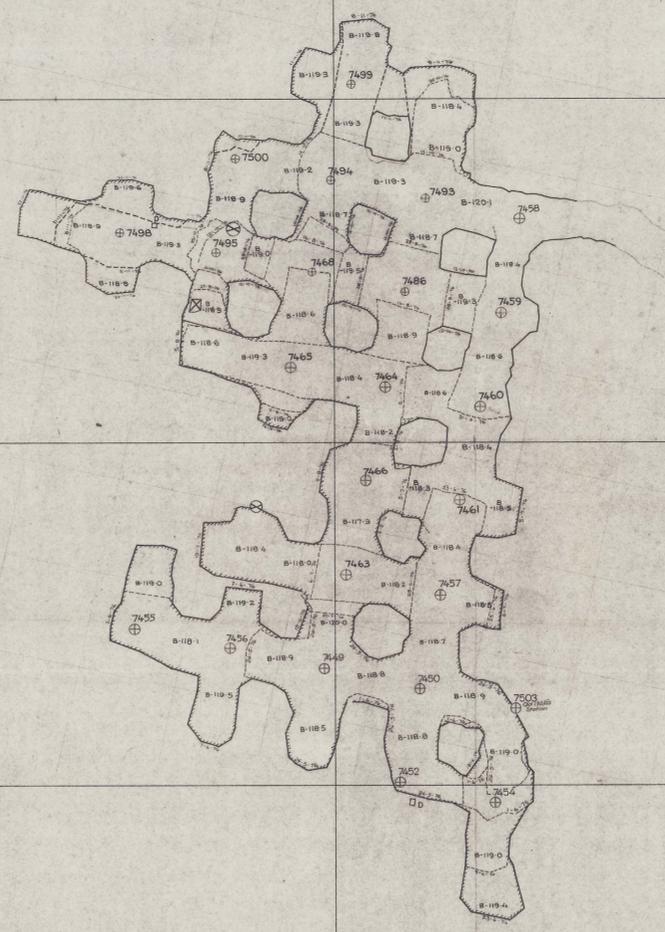

0374_818

MICROFILMED

SCALE 1:500

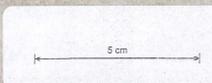

LOCATION DOLPHIN MINE
 SUBJECT 'C' LENS WEDGE
 -122 m CONTOUR

KIS KING ISLAND SCHEELITE
 A DIVISION OF WARMIN INTERNATIONAL
 GRASSY KING ISLAND
 PLAN NUMBER 04DM15 - 1021 XX031

0374_818